


CONSTRUCT GRAVEL DRIVES		
LOCATION/TYPE	RADII STA/OFFSET	APPROX. WIDTH
STA 65+81 RT/(C)	STA 65+50.92/40.00 FT STA 66+10.92/40.00 FT	20 FT
STA 66+70 LT/(R)	STA 66+37.99/40.00 FT STA 67+02.00/40.00 FT	24 FT
STA 68+67 RT/(C)	STA 68+37.00/40.00 FT STA 68+97.00/40.00 FT	20 FT

STEEL BEAM GUARDRAIL, GALVANIZED  
 STA 64+00 - 66+00 LT  
 MANUFACTURED TERMINAL SECTION, FLARED  
 STA 66+00 - 66+38 LT  
 REMOVAL AND DISPOSAL OF GUIDE POSTS  
 STA 68+68 LT

SPECIAL PROVISION (REMOVE AND STOCKPILE STONEWALL)  
 STA 64+00 - 64+48 RT  
 SPECIAL PROVISION (HAND-PLACED BITUMINOUS CONCRETE MATERIAL, DRIVES)  
 STA 65+81 RT  
 STA 66+70 LT  
 STA 68+67 RT  
 SPECIAL PROVISION (FABRIC SCREENING FENCE)  
 STA 64+50 - 65+70 RT


63+75 - 66+00 o/s Lt.

66+00 - 66+38 o/s Lt.

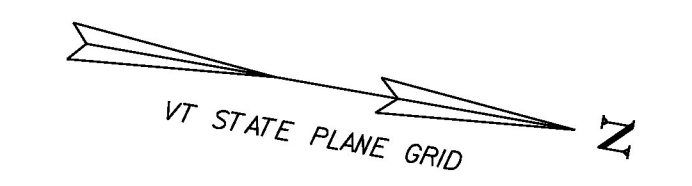

DRIVE 63+09 LT ALIGNMENT-2 INFORMATION			
		NORTHING	EASTING
POB	500+00.00	648741.3551	1447841.6872
POE	502+00.00	648939.9662	1447821.3407
BEARING	N 07° 47' 45.40" W		

CURVE #6 DATA	
DELTA	= 13° 49' 32" LT
D	= 4° 05' 33"
R	= 1400.00'
T	= 169.74'
L	= 337.82'
E	= 10.25'
BANK	= 0.064

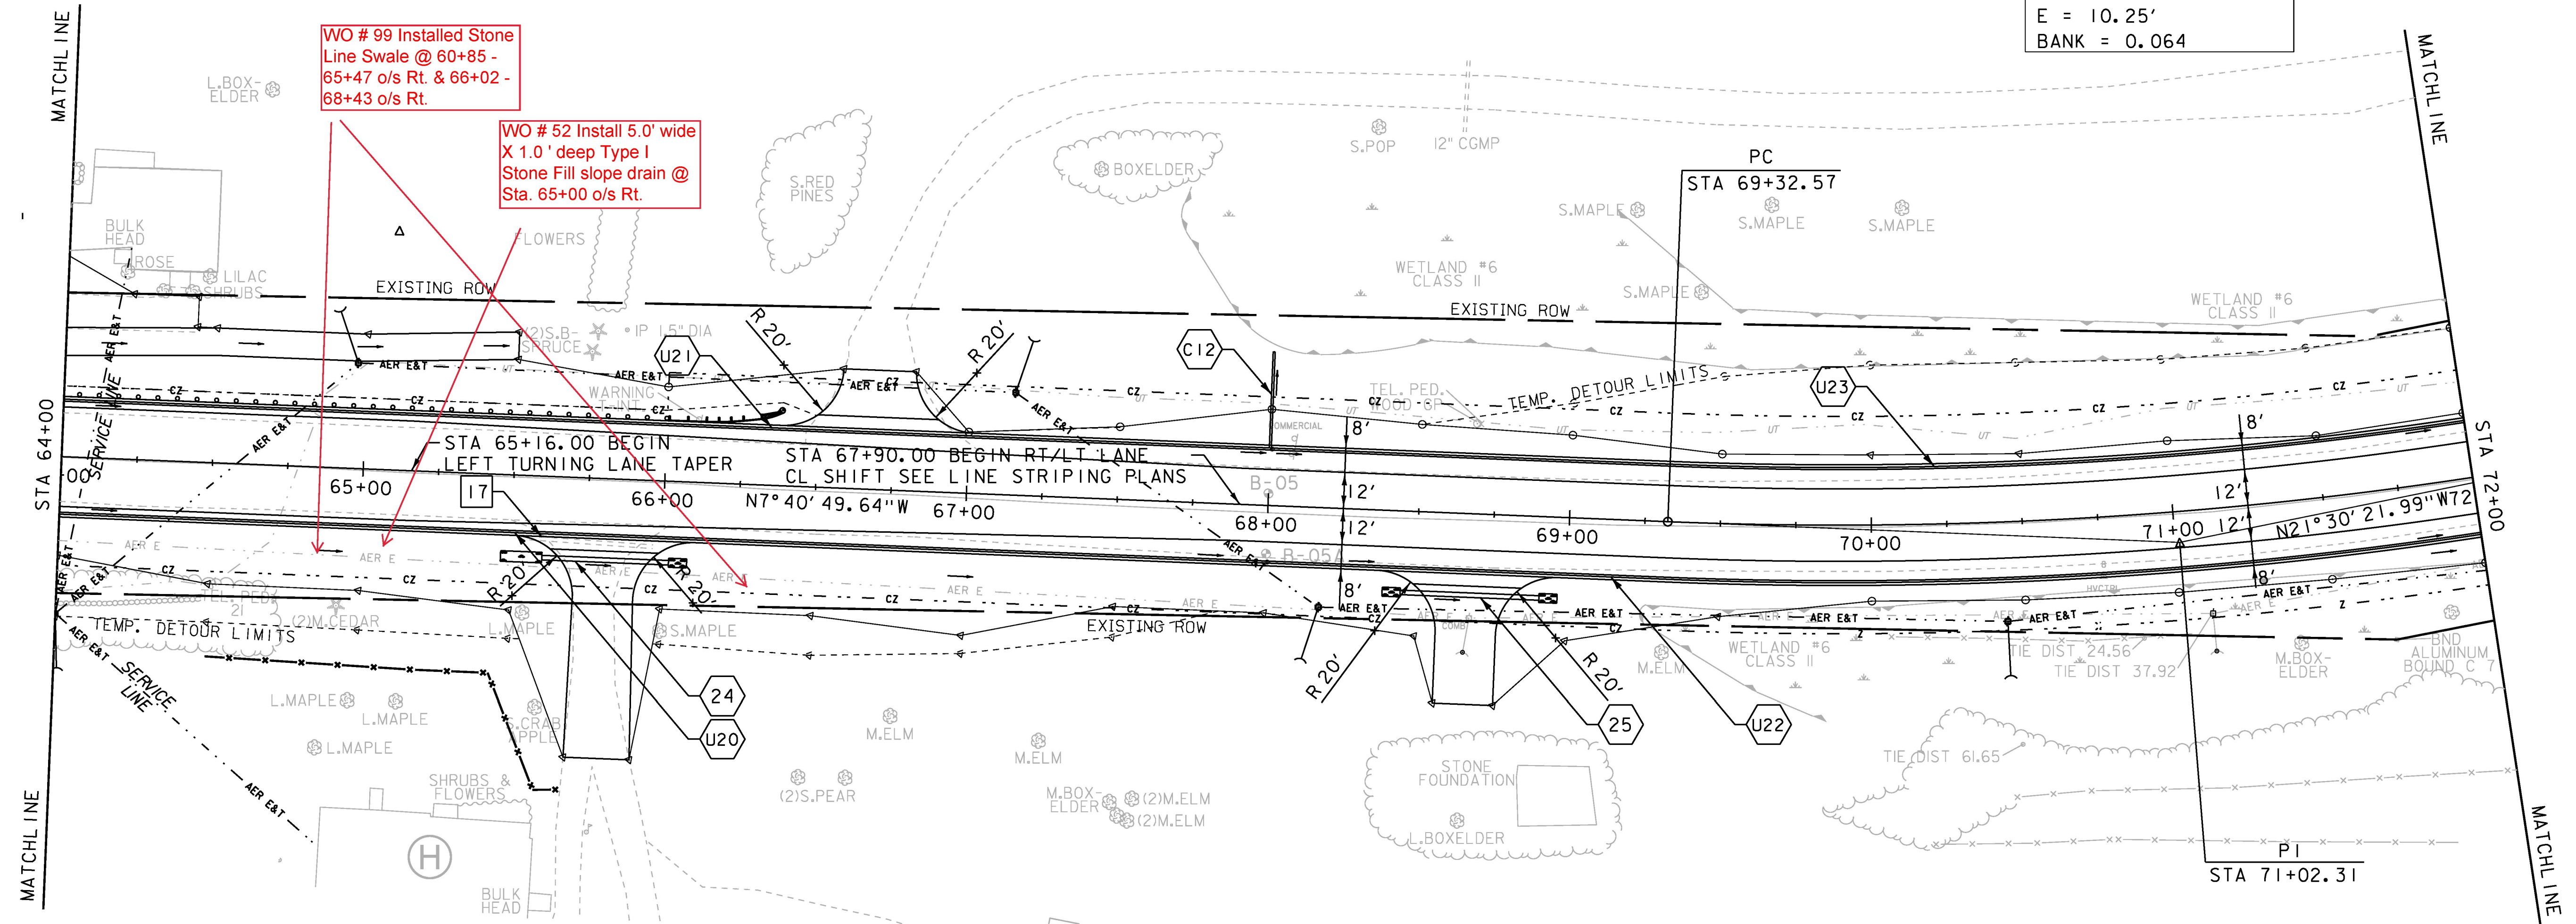


**EXISTING DRAINAGE**  
 17 STA 65+56 - 65+97 RT  
 REMOVE EXISTING 15" CGMP

**NEW DRAINAGE**  
 24 STA 65+60 - 66+02 RT  
 NEW 18" X 42' CPEP  
 W/STONE PAD AT INLET & OUTLET  
 25 STA 68+45 - 68+91 RT  
 NEW 18" X 46' CPEP  
 W/STONE PAD AT INLET & OUTLET

**8-INCH UNDERDRAIN**  
 U20 STA 64+00 - 68+00 RT  
 NEW 8" X 400' UNDERDRAIN  
 W/FLUSHING BASIN AT 61+50 RT  
 U21 STA 64+00 - 68+00 LT  
 NEW 8" X 400' UNDERDRAIN  
 W/FLUSHING BASIN AT 61+50 LT  
 U22 STA 68+00 - 72+00 RT  
 NEW 6" X 400' UNDERDRAIN  
 W/FLUSHING BASIN AT 68+00 RT  
 U23 STA 68+00 - 72+00 LT  
 NEW 6" X 400' UNDERDRAIN  
 W/FLUSHING BASIN AT 68+00 LT

**8-INCH UNDERDRAIN CARRIER PIPE**  
 C12 STA 68+00 LT  
 NEW 8" X 32' UD CARRIER PIPE

48.0'

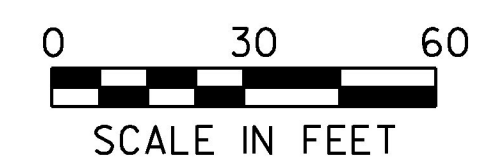

PROJECT NAME:	CHARLOTTE	PLOT DATE:	15-MAR-2016
PROJECT NUMBER:	F EGC 019-4(20)	DRAWN BY:	B. KIPP
FILE NAME:	d78d062_nul_bdr.dgn	CHECKED BY:	C. LEACH
DESIGNED BY:	B. KIPP	SHEET	77 OF 499
PLAN SHEET 8			