


# TH #49 HIGBEE ROAD

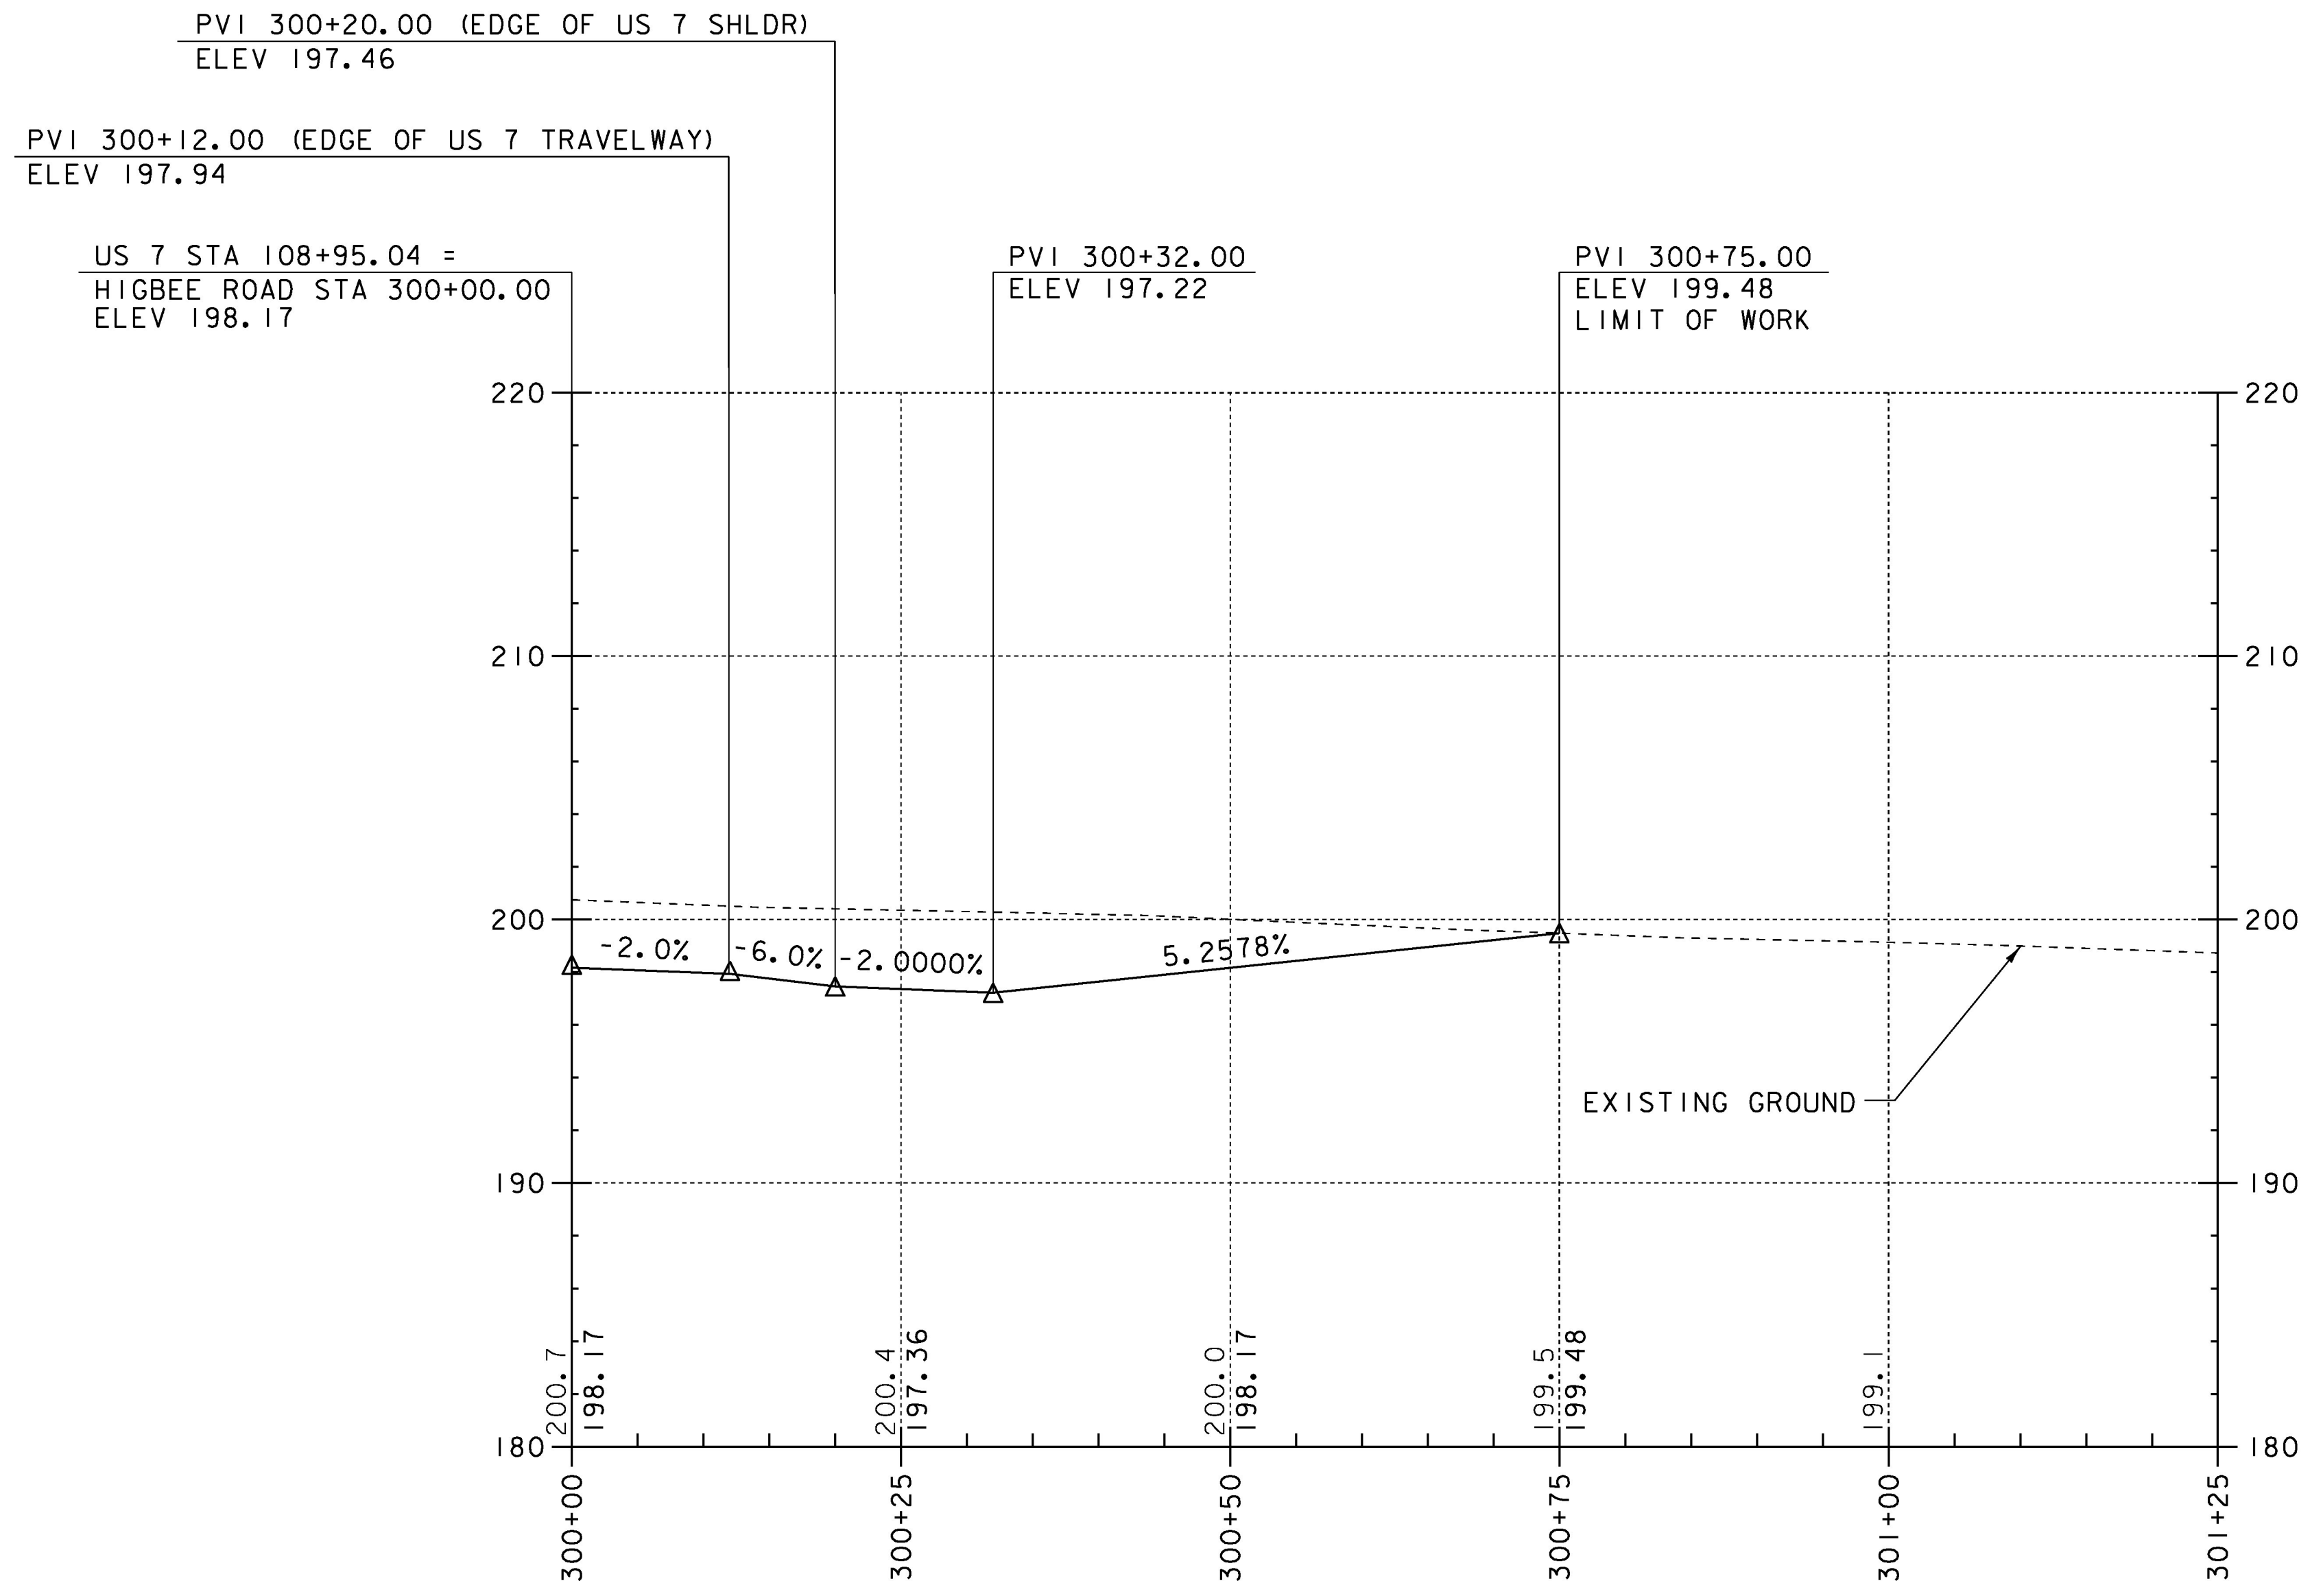

SCALE IN FEET

THE GRADES SHOWN TO THE NEAREST TENTH ARE THE OLD GROUND ALONG CENTERLINE. THE GRADES SHOWN TO THE NEAREST HUNDREDTH ARE THE PROPOSED FINISHED GRADE ALONG THE CENTERLINE.

PROJECT NAME: CHARLOTTE	
PROJECT NUMBER: F EGC 019-4(20)	
FILE NAME: d78d062_pro.dgn	PLOT DATE: 15-MAR-2016
PROJECT LEADER: K. UPMAL	DRAWN BY: B. KIPP
DESIGNED BY: B. KIPP	CHECKED BY: C. LEACH
TH #49 HIGBEE ROAD PROFILE	SHEET 105 OF 499