


SOIL CLASSIFICATION
STOCKBRIDGE AND NELLIS
STONEY LOAMS
3-8% SLOPES
K = 0.28
MEDIUM EROSION POTENTIAL

SOIL CLASSIFICATION
STOCKBRIDGE AND NELLIS
EXTREMELY STONEY LOAMS
8-15% SLOPES
K = 0.28
MEDIUM EROSION POTENTIAL

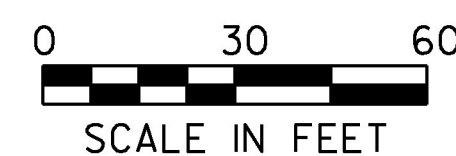

PROJECT NAME:	CHARLOTTE
PROJECT NUMBER:	F EGC 019-4(20)
FILE NAME:	d78d062_ero_existing_bdr.dgn
PLOT DATE:	15-MAR-2016
PROJECT LEADER:	K. UPMAL
DRAWN BY:	B .KIPP
DESIGNED BY:	C. LEACH
CHECKED BY:	C. LEACH
EPSC EXISTING CONDITIONS SHEET 2	SHEET 119 OF 499