


SOIL CLASSIFICATION  
 STOCKBRIDGE AND NELLIS  
 STONEY LOAMS  
 3-8% SLOPES  
 K = 0.28  
 MEDIUM EROSION POTENTIAL

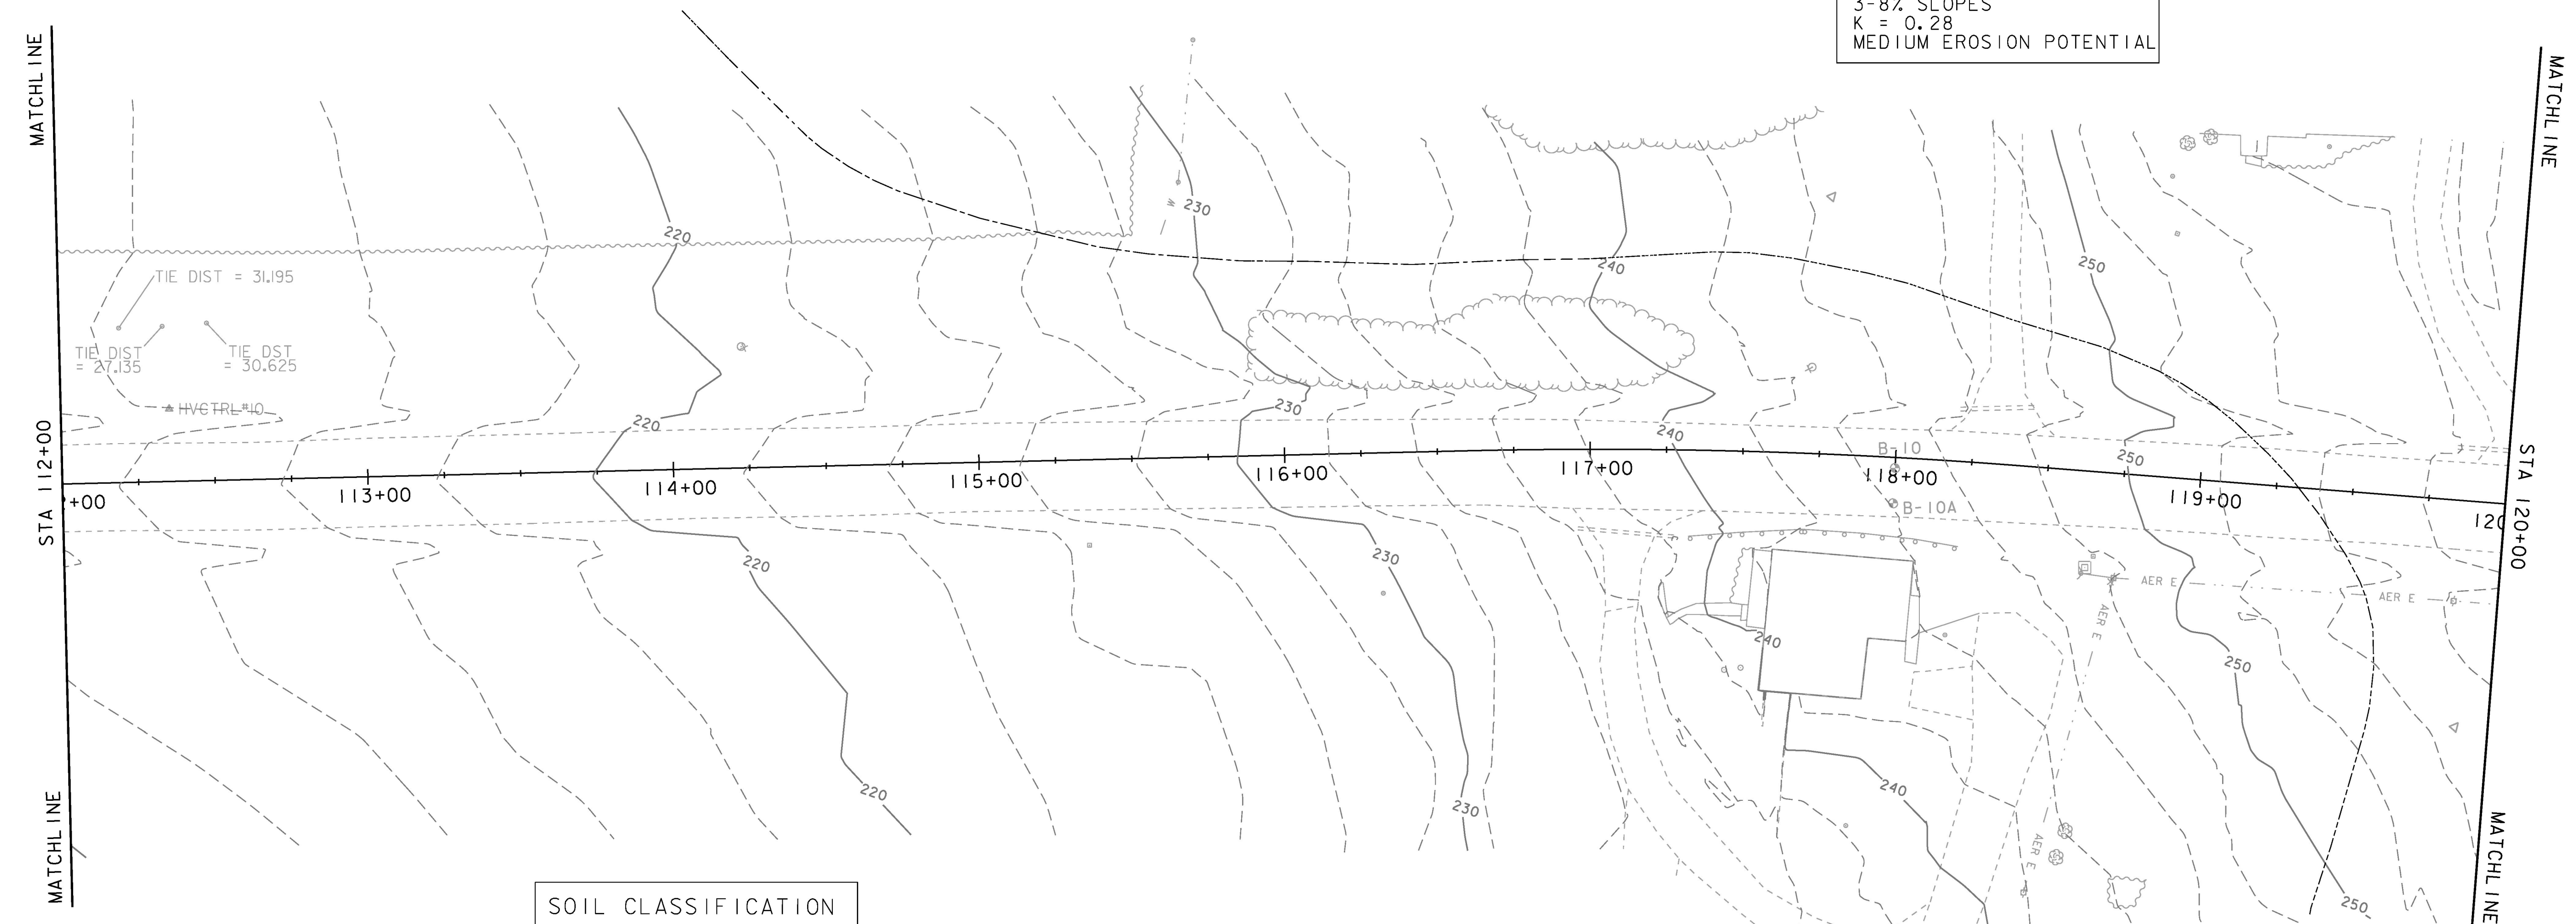

SOIL CLASSIFICATION  
 VERGENNES CLAY  
 2-6% SLOPES  
 K = 0.49  
 MEDIUM EROSION POTENTIAL



PROJECT NAME:	CHARLOTTE
PROJECT NUMBER:	F EGC 019-4(20)
FILE NAME: d78d062_ero_existing_bdr.dgn	PLOT DATE: 15-MAR-2016
PROJECT LEADER: K. UPMAL	DRAWN BY: B. KIPP
DESIGNED BY: C. LEACH	CHECKED BY: C. LEACH
EPSC EXISTING CONDITIONS SHEET 14	SHEET 131 OF 499