

GEOTEXTILE FOR SILT FENCE

STA 32+00 - 32+44 LT
 STA 32+44 - 33+00 LT
 STA 32+99 - 33+37 LT
 STA 33+37 - 33+59 LT
 STA 33+83 LT
 STA 34+04 LT
 STA 34+33 LT
 STA 34+45 - 35+49 LT
 STA 35+49 - 36+07 LT
 STA 36+27 - 36+63 LT

GEOTEXTILE FOR SILT FENCE, WOVEN WIRE REINFORCED

STA 37+26 LT
 STA 37+53 LT
 STA 37+80 LT
 STA 38+00 LT
 STA 38+29 LT
 STA 38+43 - 40+00 LT (5)

TEMPORARY EROSION MATTING

STA 32+00 - 35+86 RT
 STA 36+08 - 37+82 RT
 STA 37+94 - 40+00 RT
 STA 38+22 - 40+00 LT

TEMPORARY STONE CHECK DAM, TYPE I

STA 32+00 - 35+68 RT
 STA 36+20 - 37+73 RT
 STA 38+22 - 40+00 RT

INLET PROTECTION DEVICE, TYPE I



STA 35+72 RT (PIPE INLET PROTECTION)
 STA 37+70 RT (PIPE INLET PROTECTION)

BARRIER FENCE

STA 37+54 TO 39+57 LT
 STA 39+18 TO 40+00 RT

PROJECT DEMARCATION FENCE

STA 32+00 - 36+13 LT
 STA 32+00 - 35+87 RT
 STA 36+30 - 36+64 LT
 STA 36+92 - 37+54 LT
 STA 37+89 - 39+18 RT
 STA 39+57 - 40+00 LT

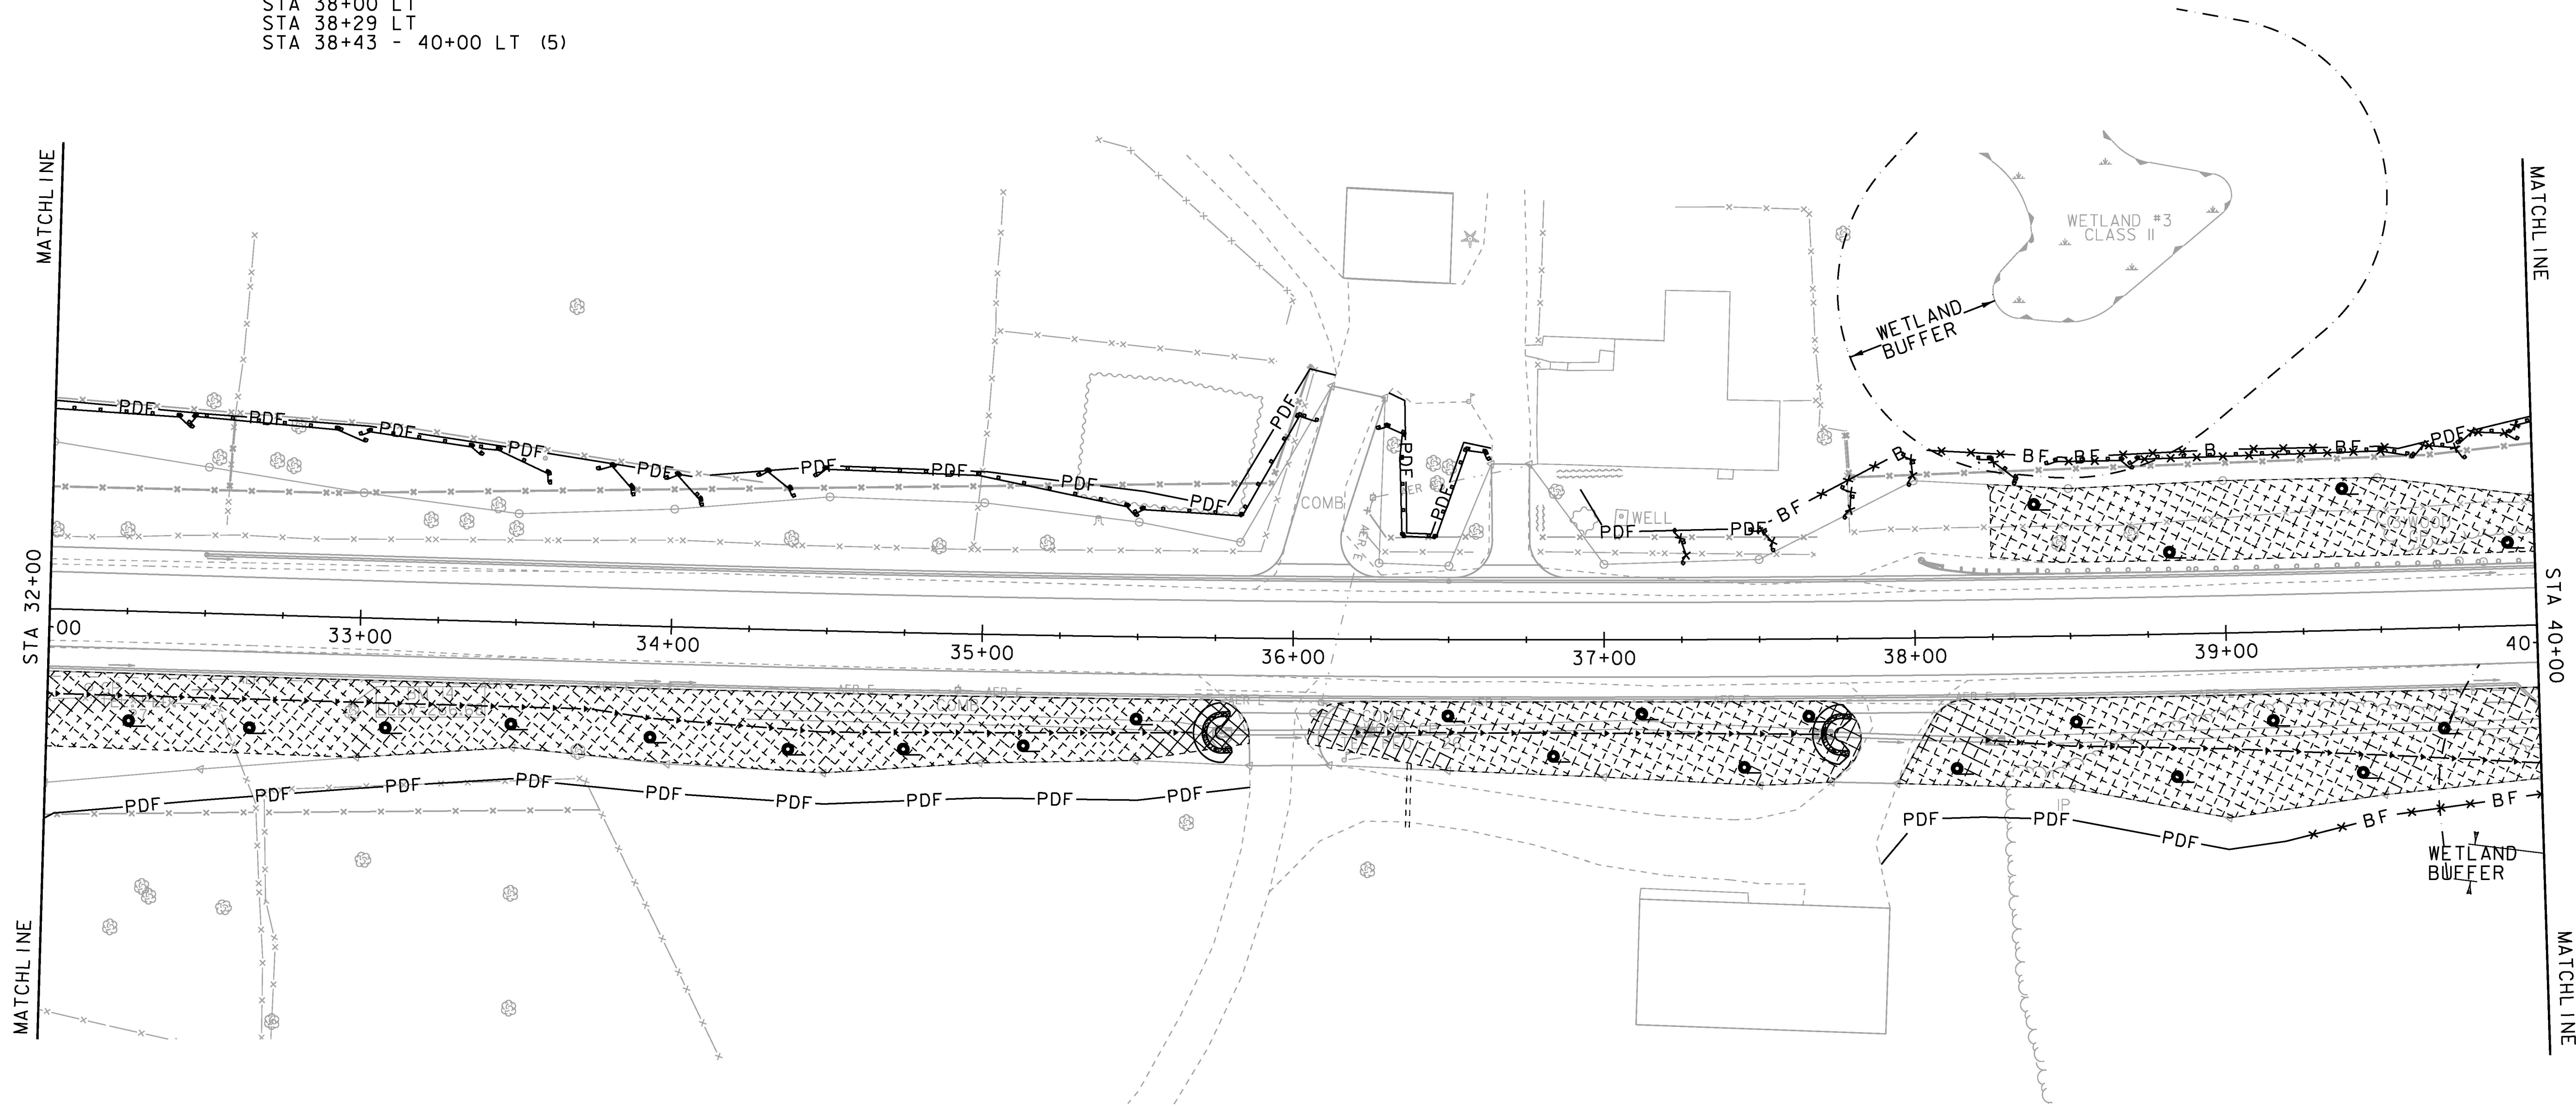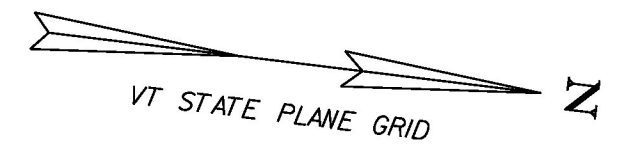

LEGEND	
	DETOUR SLOPE LIMITS
	STONE & BLOCK DROP, INLET PROTECTION TYPE I
	PIPE INLET PROTECTION, INLET PROTECTION TYPE I



PROJECT NAME:	CHARLOTTE
PROJECT NUMBER:	F EGC 019-4(20)
FILE NAME:	d78d062_ero_construction_bdr.dgn
PLOT DATE:	15-MAR-2016
PROJECT LEADER:	K. UPMAL
DRAWN BY:	N. PAPPAS
DESIGNED BY:	N. PAPPAS
CHECKED BY:	C. LEACH
EPSC CONSTRUCTION SHEET 4	SHEET 141 OF 499