

**GEOTEXTILE FOR SILT FENCE**

STA 88+09 - 88+18 LT  
 STA 88+27 - 88+33 LT  
 STA 88+42 - 88+49 LT  
 STA 88+64 - 88+69 LT  
 STA 88+96 - 89+08 LT  
 STA 89+43 - 89+50 LT  
 STA 89+52 - 90+09 LT

**GEOTEXTILE FOR SILT FENCE, WOVEN WIRE REINFORCED**

STA 93+00 LT  
 STA 93+21 LT  
 STA 93+44 LT  
 STA 93+54 - 93+66 LT  
 STA 93+86 - 94+12 LT  
 STA 94+22 - 94+35 LT  
 STA 94+56 - 94+60 LT  
 STA 94+98 - 95+06 LT  
 STA 95+43 - 95+53 LT  
 STA 95+53 - 96+00 LT

**TEMPORARY STONE CHECK DAM, TYPE I**

STA 11+87 - 12+15 LT (BIKE-PATH WEST)  
 STA 12+23 - 13+36 RT (BIKE-PATH WEST)  
 STA 11+87 - 11+97 RT (BIKE-PATH WEST)  
 STA 12+20 - 13+36 LT (BIKE-PATH WEST)  
 STA 3+50 - 4+00 LT (BIKE-PATH EAST)  
 STA 3+50 - 6+00 RT (BIKE-PATH EAST)  
 STA 4+35 - 6+00 LT (BIKE-PATH EAST)  
 STA 20+20 - 20+75 RT & LT (PATH ACCESS)

**TEMPORARY EROSION MATTING**

STA 88+00 - 91+44 RT  
 STA 88+00 - 92+64 LT  
 STA 91+37 - 92+21 RT  
 STA 91+56 - 92+44 RT  
 STA 91+56 - 92+71 LT  
 STA 93+00 - 96+00 LT  
 STA 92+52 - 96+00 RT

**INLET PROTECTION DEVICE, TYPE I**



STA 89+00 LT (STONE & DROP BLOCK)  
 STA 89+00 RT (STONE & DROP BLOCK)  
 STA 91+40 LT & RT (STONE & DROP BLOCK)  
 STA 91+60 LT (2-STONE & DROP BLOCK)  
 STA 91+60 RT (STONE & DROP BLOCK)  
 STA 93+23 LT (STONE & DROP BLOCK)  
 STA 20+20 LT (PIPE INLET PROTECTION, BIKE PATH ACCESS)

**BARRIER FENCE**

STA 92+52 - 93+24 RT  
 STA 92+74 - 93+90 LT  
 STA 93+35 - 94+58 RT  
 STA 94+00 - 95+20 LT

**PROJECT DEMARCATION FENCE**

STA 88+00 - 91+21 RT  
 STA 88+00 - 92+74 LT  
 STA 91+35 - 92+40 RT  
 STA 94+58 - 96+00 RT  
 STA 95+20 - 96+00 LT

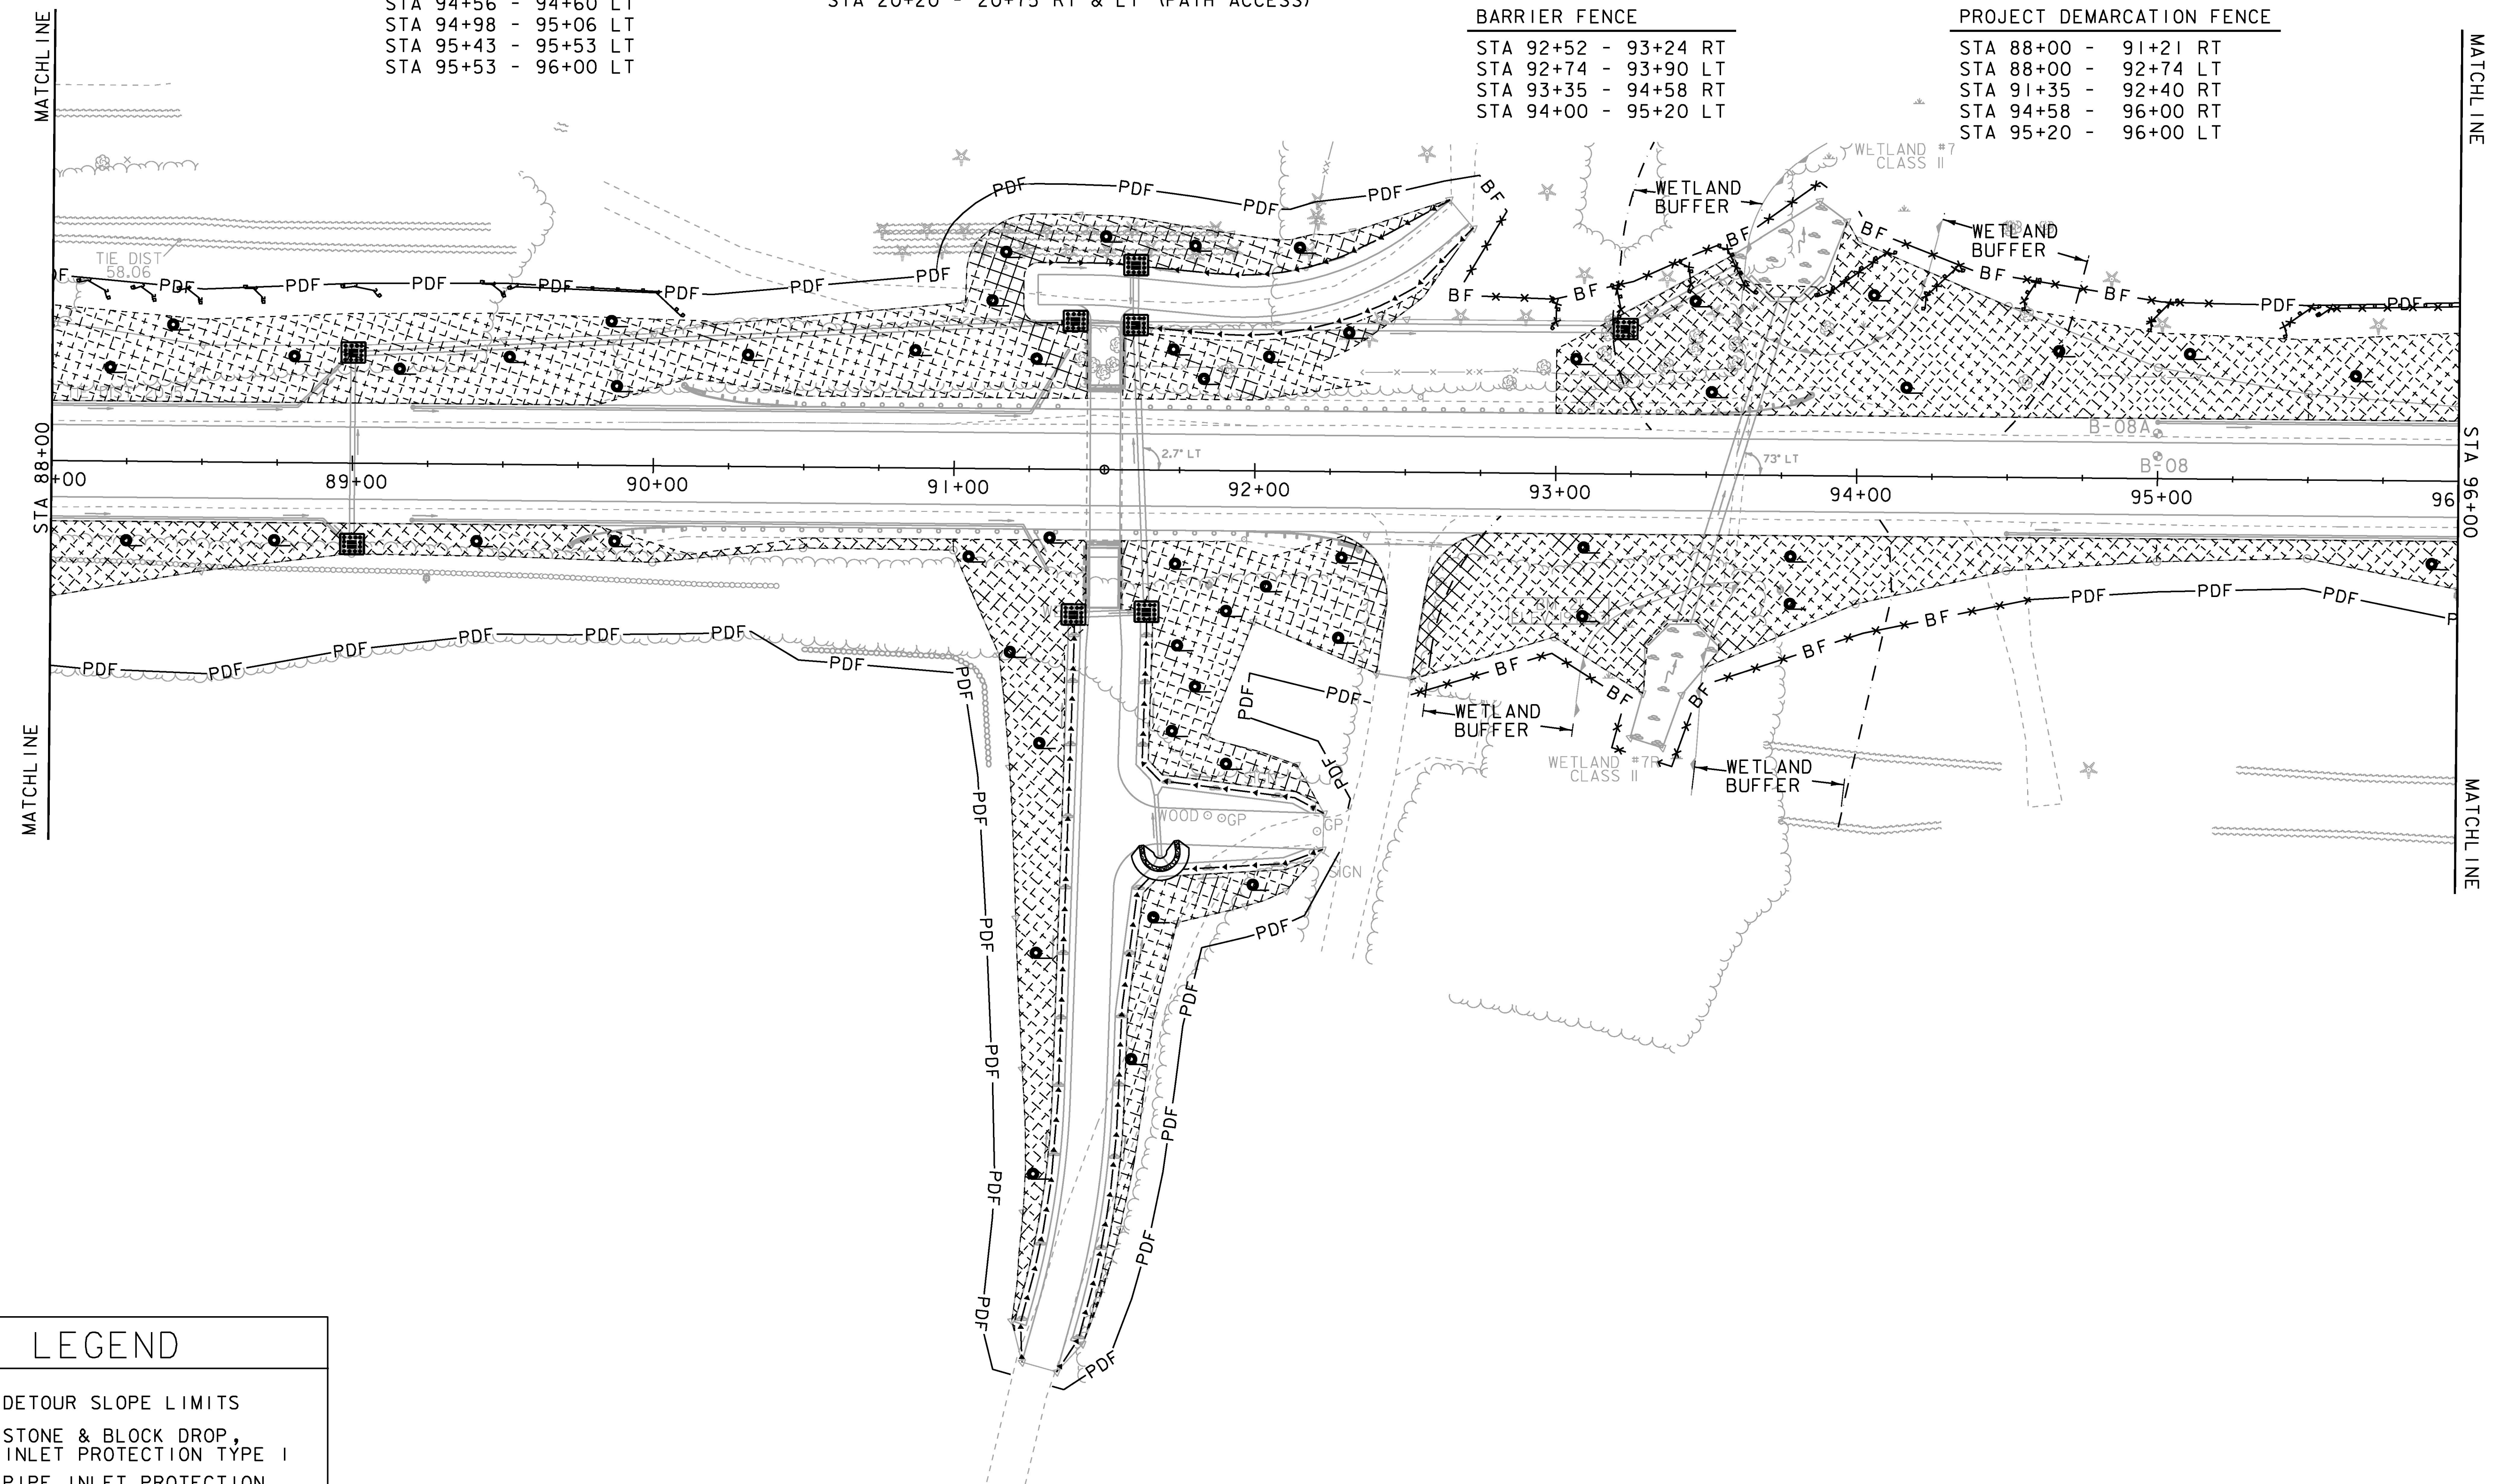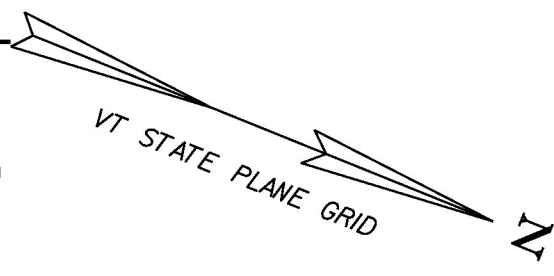

**LEGEND**

- DETOUR SLOPE LIMITS
- STONE & BLOCK DROP, INLET PROTECTION TYPE I
- PIPE INLET PROTECTION, INLET PROTECTION TYPE I



PROJECT NAME:	CHARLOTTE
PROJECT NUMBER:	F EGC 019-4(20)
FILE NAME:	d78d062_ero_construction_bdr.dgn
PLOT DATE:	15-MAR-2016
PROJECT LEADER:	K. UPMAL
DRAWN BY:	B. KIPP
DESIGNED BY:	B. KIPP
CHECKED BY:	C. LEACH
EPSC CONSTRUCTION SHEET II	SHEET 148 OF 499