


LEGEND	
	DISTURBED AREAS REQUIRING RE-VEGETATION

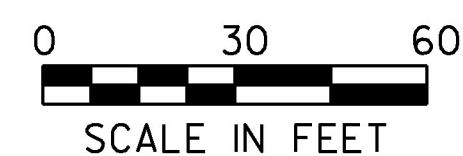

PROJECT NAME: CHARLOTTE	PLOT DATE: 15-MAR-2016
PROJECT NUMBER: F EGC 019-4(20)	DRAWN BY: N. PAPPAS
FILE NAME: d78d062_ero_final_bdr.dgn	CHECKED BY: C. LEACH
DESIGNED BY: N. PAPPAS	SHEET 159 OF 499
EPSC FINAL CONDITIONS SHEET 2	