


LEGEND

 DISTURBED AREAS
REQUIRING RE-VEGETATION

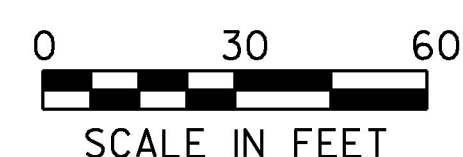

PROJECT NAME:	CHARLOTTE
PROJECT NUMBER:	F EGC 019-4(20)
FILE NAME: d78d062_ero_final_bdr.dgn	PLOT DATE: 15-MAR-2016
PROJECT LEADER: K. UPMAL	DRAWN BY: N. PAPPAS
DESIGNED BY: N. PAPPAS	CHECKED BY: C. LEACH
EPSC FINAL CONDITIONS SHEET 4	SHEET 161 OF 499