


LEGEND	
	DISTURBED AREAS REQUIRING RE-VEGETATION

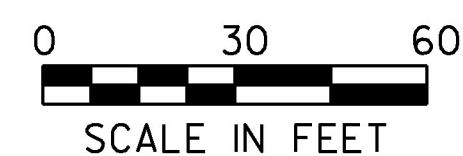

PROJECT NAME:	CHARLOTTE
PROJECT NUMBER:	F EGC 019-4(20)
FILE NAME:	d78d062_ero_final_bdr.dgn
PROJECT LEADER:	K. UPMAL
DESIGNED BY:	N. PAPPAS
EPSC FINAL CONDITIONS SHEET 6	
PLOT DATE:	15-MAR-2016
DRAWN BY:	N. PAPPAS
CHECKED BY:	C. LEACH
SHEET	163 OF 499