


LEGEND

 DISTURBED AREAS
REQUIRING RE-VEGETATION

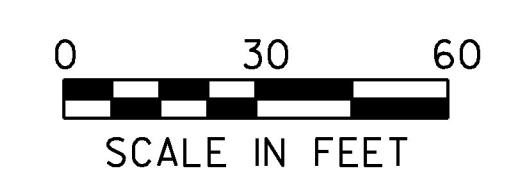

PROJECT NAME:	CHARLOTTE	PLOT DATE:	15-MAR-2016
PROJECT NUMBER:	F EGC 019-4(20)	DRAWN BY:	N. PAPPAS
FILE NAME:	d78d062_ero_final.bdr.dgn	CHECKED BY:	C. LEACH
PROJECT LEADER:	K. UPMAL	EPSC FINAL CONDITIONS SHEET 17	SHEET 174 OF 499