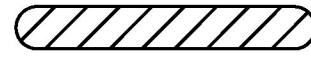


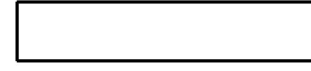



- LEGEND**
-  PROPOSED WOODY SHRUBS/HEDGE
 -  PROPOSED DECIDUOUS TREE
 -  PROPOSED CONIFEROUS TREE
 -  LANDSCAPE BACKFILL MIX
 -  DENOTES TREE OR STUMP REMOVAL



PROJECT NAME:	CHARLOTTE
PROJECT NUMBER:	F EGC 019-4(20)
FILE NAME:	d78d062_landscape_bdr.dgn
PROJECT LEADER:	K. UPMAL
DESIGNED BY:	C. LEACH
LANDSCAPE LAYOUT SHEET 9	
PLOT DATE:	15-MAR-2016
DRAWN BY:	S. ZWICK
CHECKED BY:	C. LEACH
SHEET	189 OF 499