
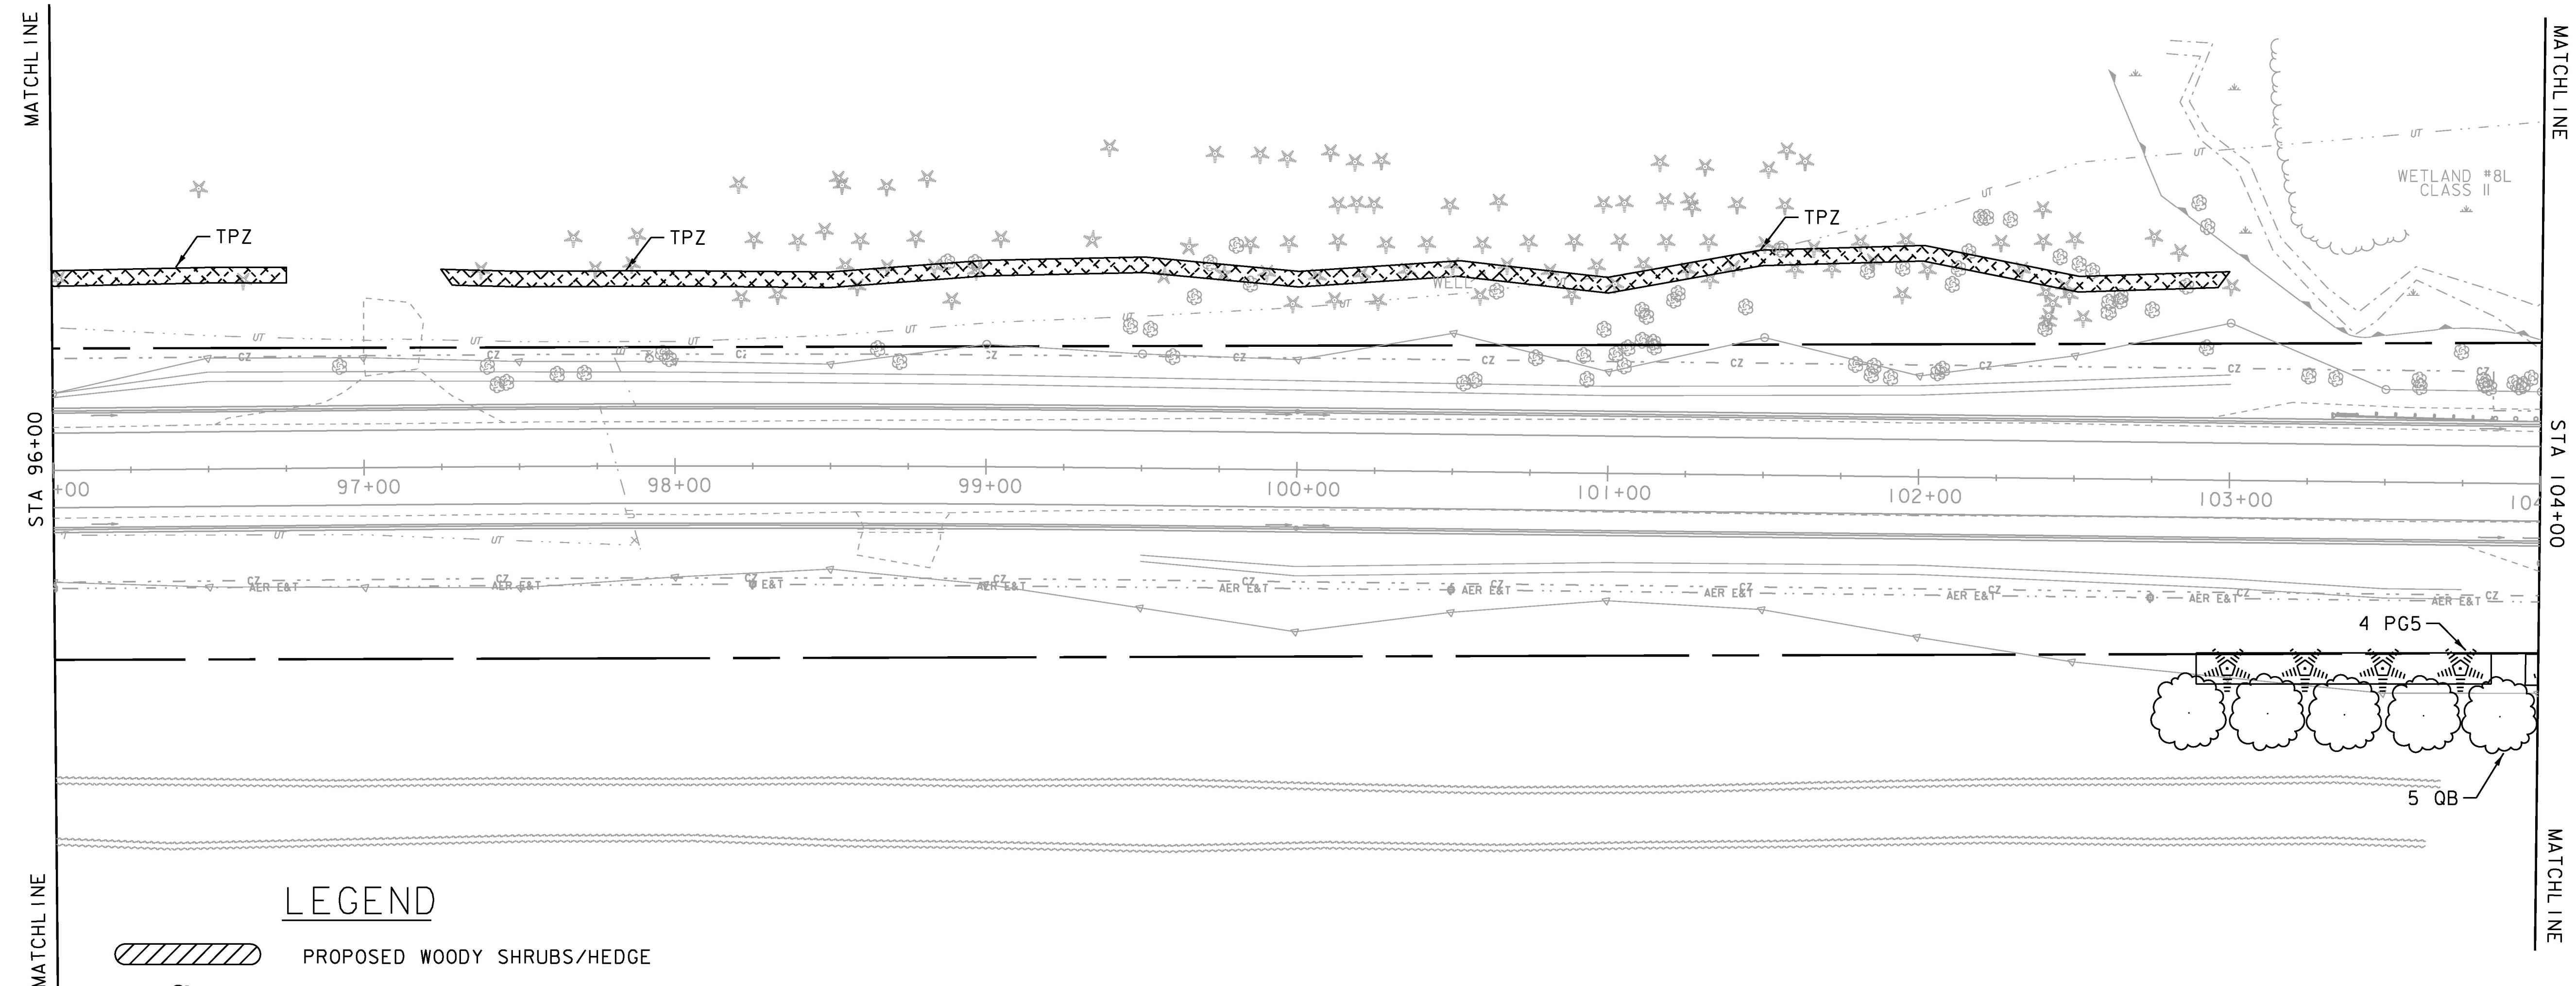


EVERGREEN TREES  
 STA 103+00 - 103+75 RT - 4 PG5

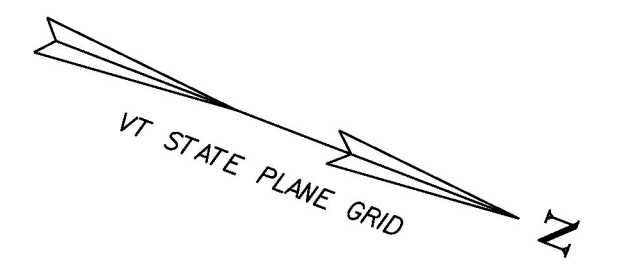




DECIDUOUS TREES  
 STA 102+88 - 103+38 RT - 5 QB


TREE PROTECTION  
 STA 96+00 - 96+75 LT  
 STA 97+25 - 103+00 LT

LANDSCAPE BACKFILL, TRUCK MEASUREMENT  
 STA 102+90 - STA 103+85 RT - 95 FT x 10 FT x 2 FT  
 STA 103+96 - STA 104+00 RT - 4 FT x 10 FT x 2 FT

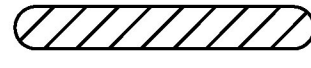

**LEGEND**

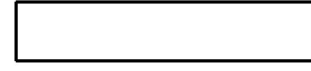-  PROPOSED WOODY SHRUBS/HEDGE
-  PROPOSED DECIDUOUS TREE
-  PROPOSED CONIFEROUS TREE
-  LANDSCAPE BACKFILL MIX
-  DENOTES TREE OR STUMP REMOVAL

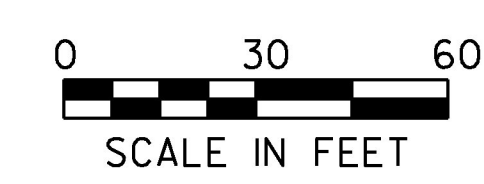

PROJECT NAME: CHARLOTTE	
PROJECT NUMBER: F EGC 019-4(20)	
FILE NAME: d78d062_landscape_bdr.dgn	PLOT DATE: 15-MAR-2016
PROJECT LEADER: K. UPMAL	DRAWN BY: S. ZWICK
DESIGNED BY: C. LEACH	CHECKED BY: C. LEACH
LANDSCAPE LAYOUT SHEET 12	SHEET 192 OF 499