
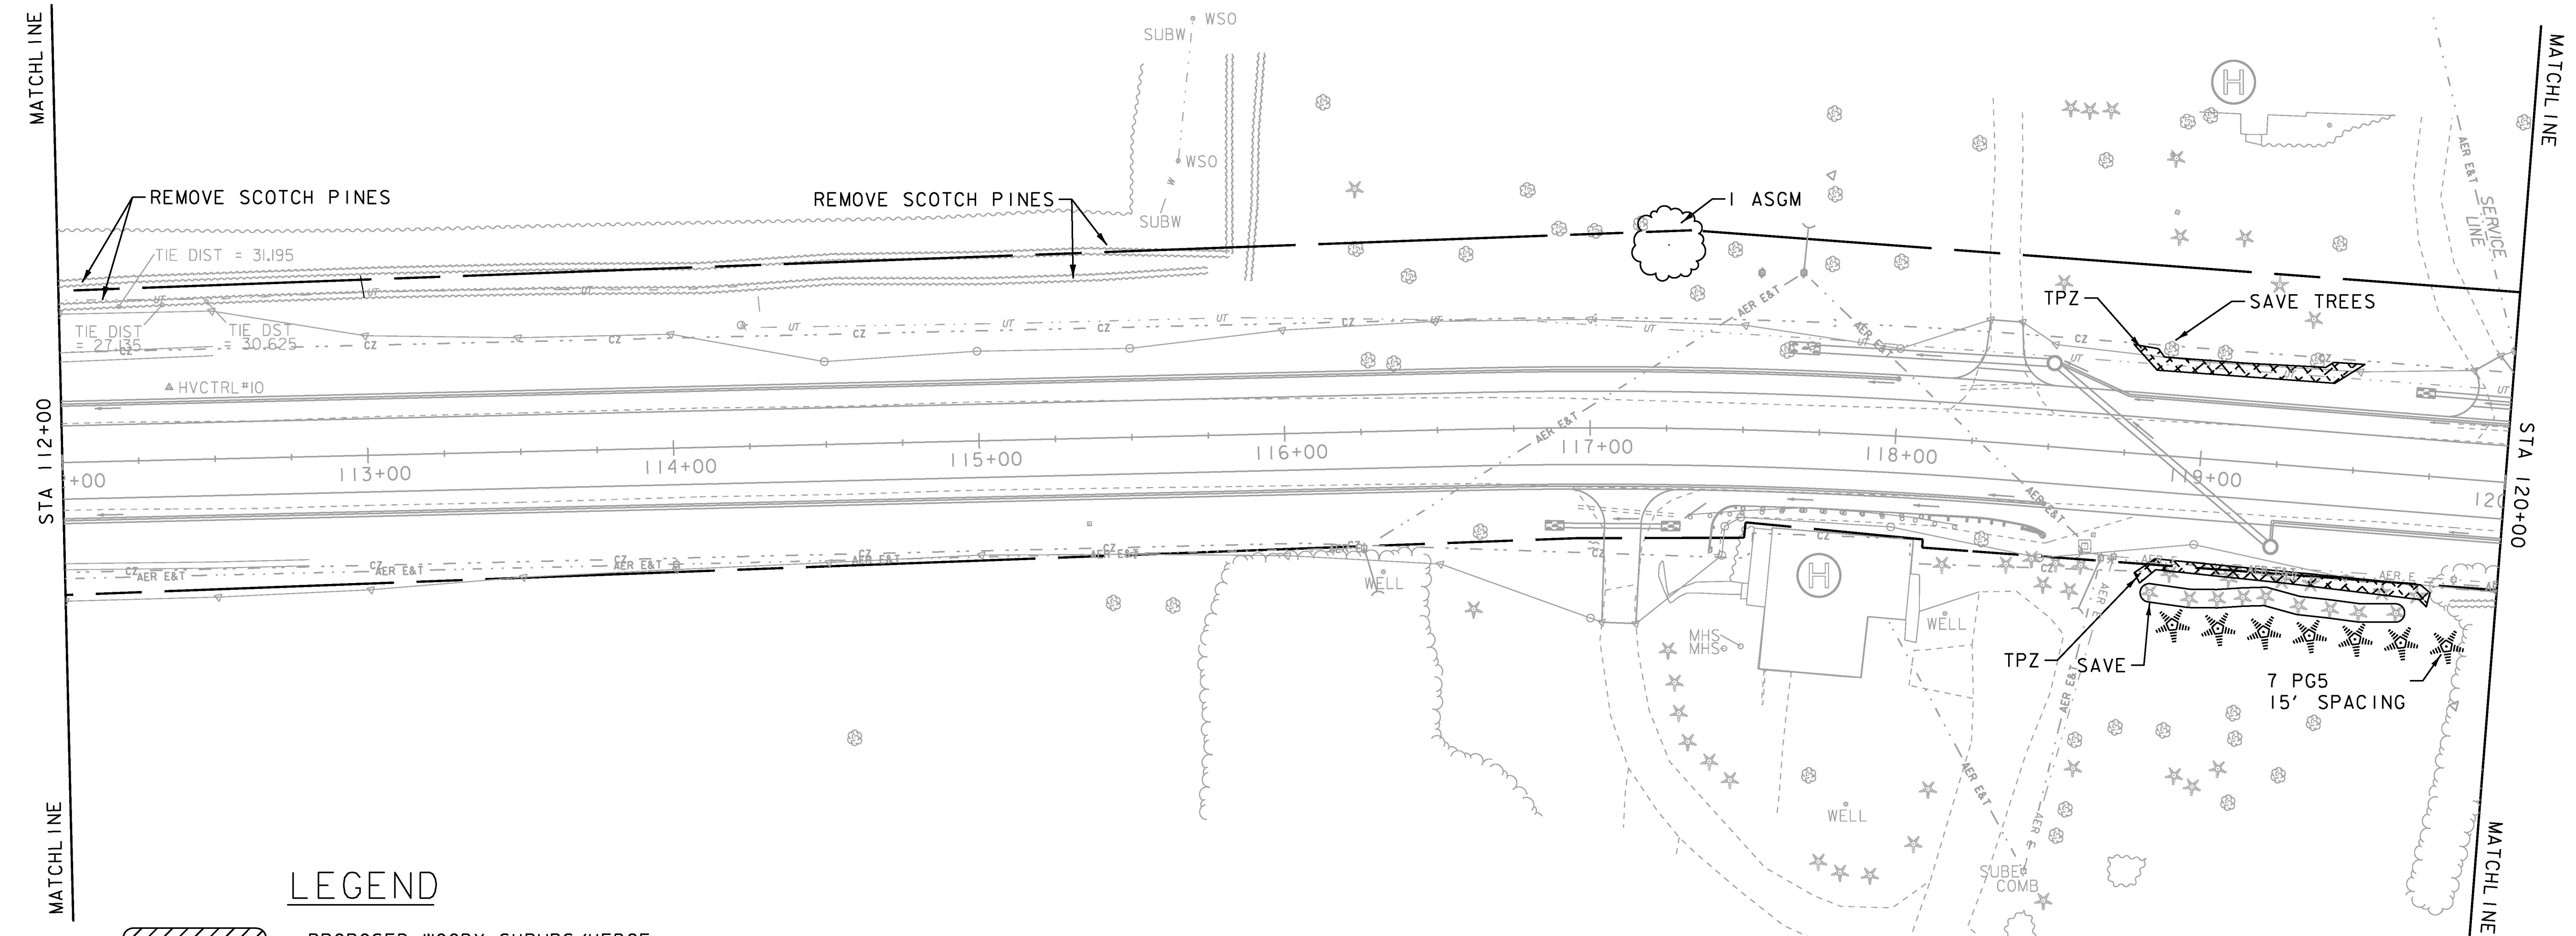


EVERGREEN TREES
 STA 118+95 - 119+85 RT - 7 PG5

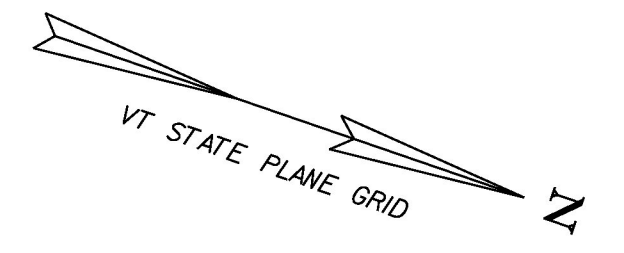




DECIDUOUS TREES
 STA 117+25 LT - 1 ASGM

TREE PROTECTION
 STA 118+72 - 119+42 LT
 STA 118+81 - 119+79 RT

SAVE TREES
 STA 118+87 - 119+68 RT - 9 SPRUCE
 STA 118+88 LT - L. MAPLE
 STA 119+05 LT - L. MAPLE
 STA 119+36 LT - L. MAPLE

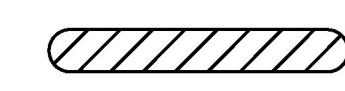

LEGEND

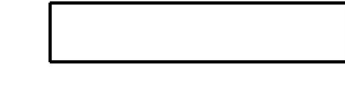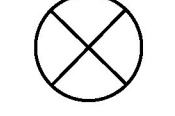-  PROPOSED WOODY SHRUBS/HEDGE
-  PROPOSED DECIDUOUS TREE
-  PROPOSED CONIFEROUS TREE
-  LANDSCAPE BACKFILL MIX
-  DENOTES TREE OR STUMP REMOVAL



PROJECT NAME:	CHARLOTTE
PROJECT NUMBER:	F EGC 019-4(20)
FILE NAME:	d78d062_landscape_bdr.dgn
PROJECT LEADER:	K. UPMAL
DESIGNED BY:	C. LEACH
LANDSCAPE LAYOUT SHEET 14	
PLOT DATE:	15-MAR-2016
DRAWN BY:	S. ZWICK
CHECKED BY:	C. LEACH
SHEET	194 OF 499