





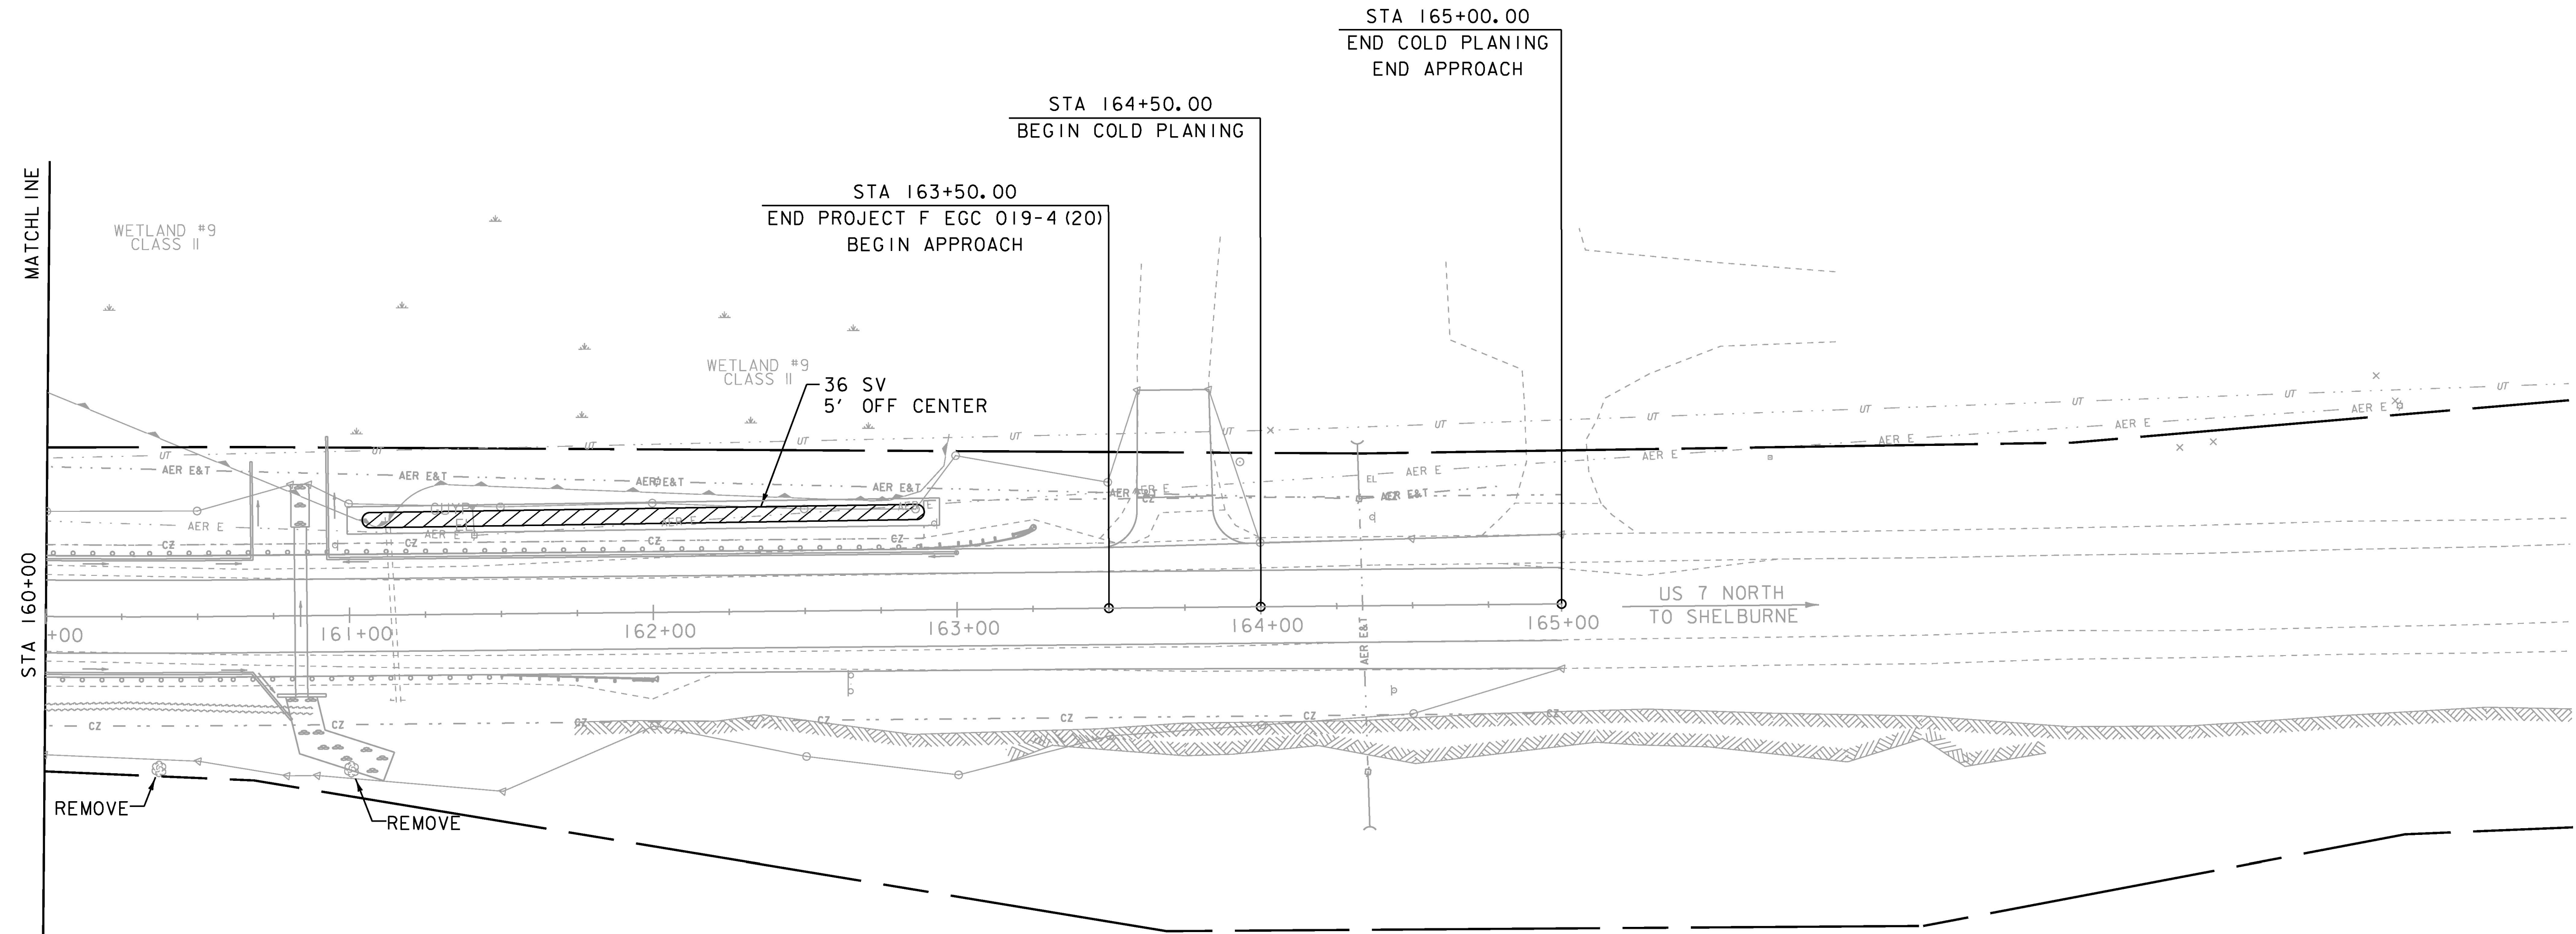


DECIDUOUS SHRUBS
 STA 161+35 - 163+25 LT - 36 SV

LANDSCAPE BACKFILL - TRUCK MEASUREMENT
 STA 160+99 - 162+94 LT - 195 FT x 9 FT x 2 FT

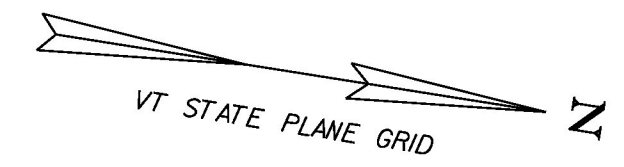

MATCH LINE
STA 160+00
MATCH LINE

LEGEND

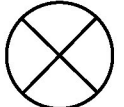-  PROPOSED WOODY SHRUBS/HEDGE
-  PROPOSED DECIDUOUS TREE
-  PROPOSED CONIFEROUS TREE
-  LANDSCAPE BACKFILL MIX
-  DENOTES TREE OR STUMP REMOVAL



PROJECT NAME: CHARLOTTE	PLOT DATE: 15-MAR-2016
PROJECT NUMBER: F EGC 019-4(20)	DRAWN BY: S. ZWICK
FILE NAME: d78d062_landscape_bdr.dgn	DESIGNED BY: C. LEACH
LANDSCAPE LAYOUT SHEET 20	CHECKED BY: C. LEACH
	SHEET 200 OF 499