



INLET HEADWALL ELEVATION VIEW

SCALE 1/2" = 1'-0"

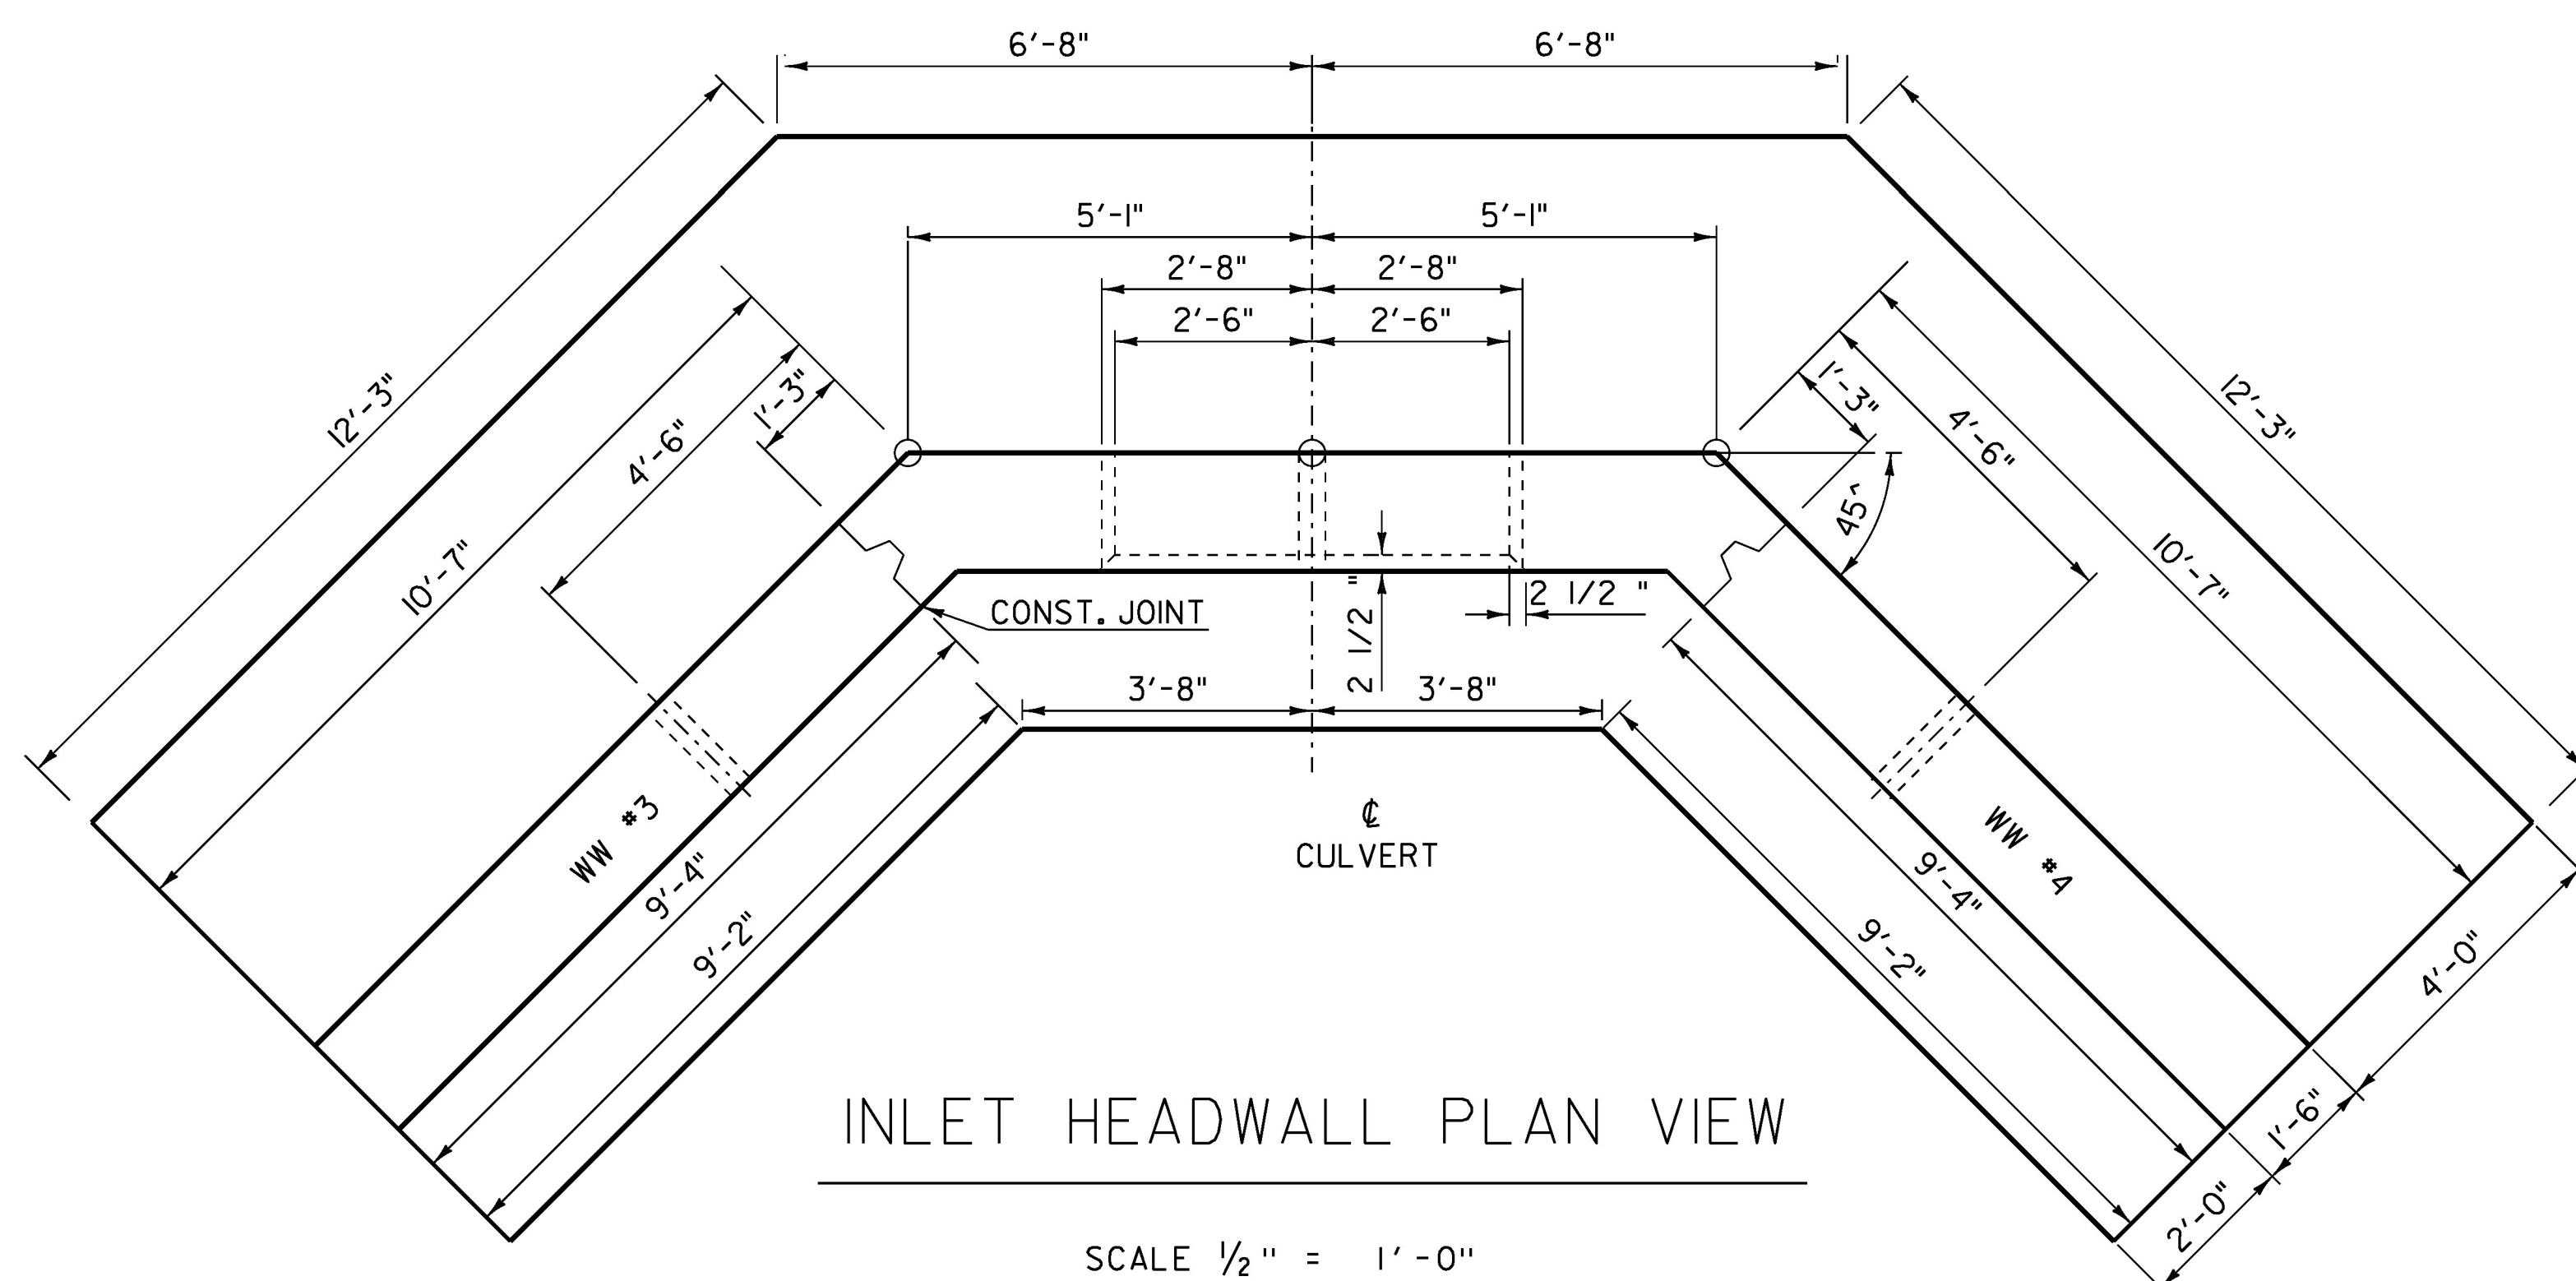

INLET HEADWALL PLAN VIEW

SCALE 1/2" = 1'-0"

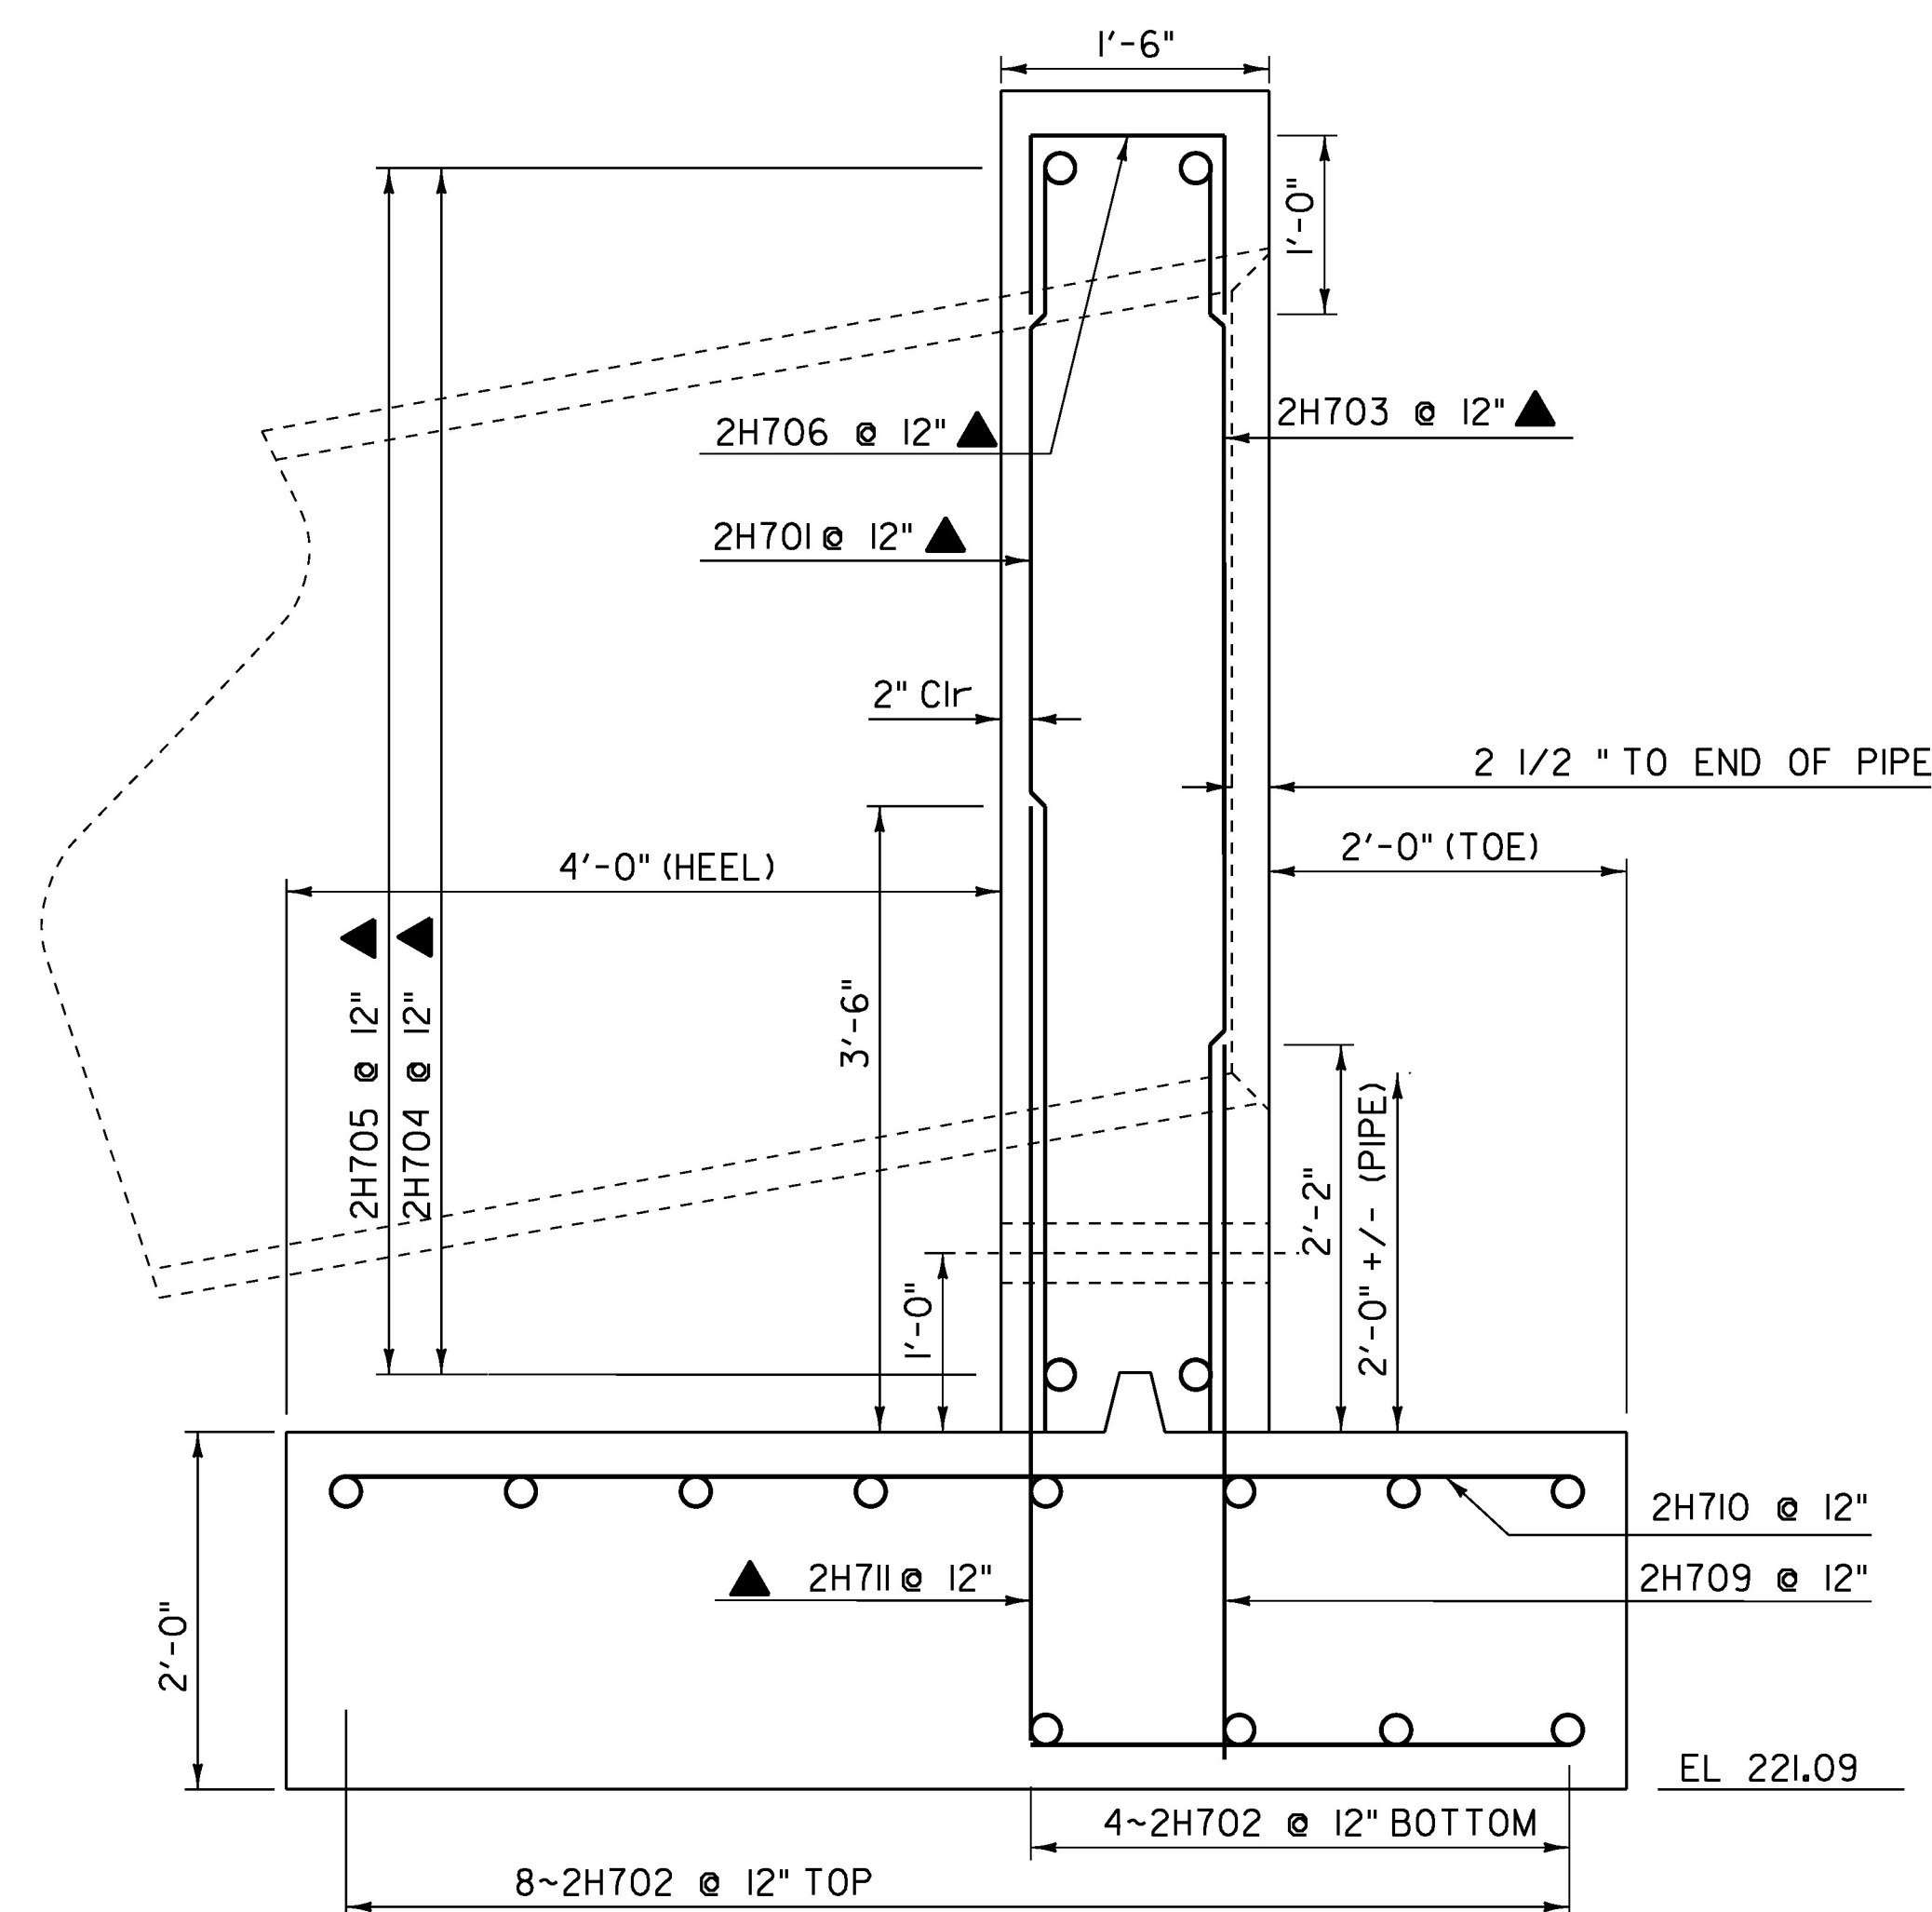

INLET HEADWALL SECTION

SCALE 1" = 1'-0"

NOTE:
 NF = NEAR FACE
 FF = FAR FACE
 EF = EACH FACE
 ▲ = CUT TO FIT IN FIELD
 3" CLR. UNLESS OTHERWISE SPECIFIED ON THE PLANS.

PROJECT NAME: CHARLOTTE	PLOT DATE: 15-MAR-2016
PROJECT NUMBER: F EGC 019-4(20)	DRAWN BY: A. KEMPTON
FILE NAME: d78d062.typ.dgn	CHECKED BY: C. LEACH
PROJECT LEADER: K. UPMAL	STA 40+42 INLET HEADWALL DETAILS SHEET SHEET 240 OF 499
DESIGNED BY: A. KEMPTON	