



SECTION B-B

SCALE 1 1/2" = 1'-0"
 9 6 3 0

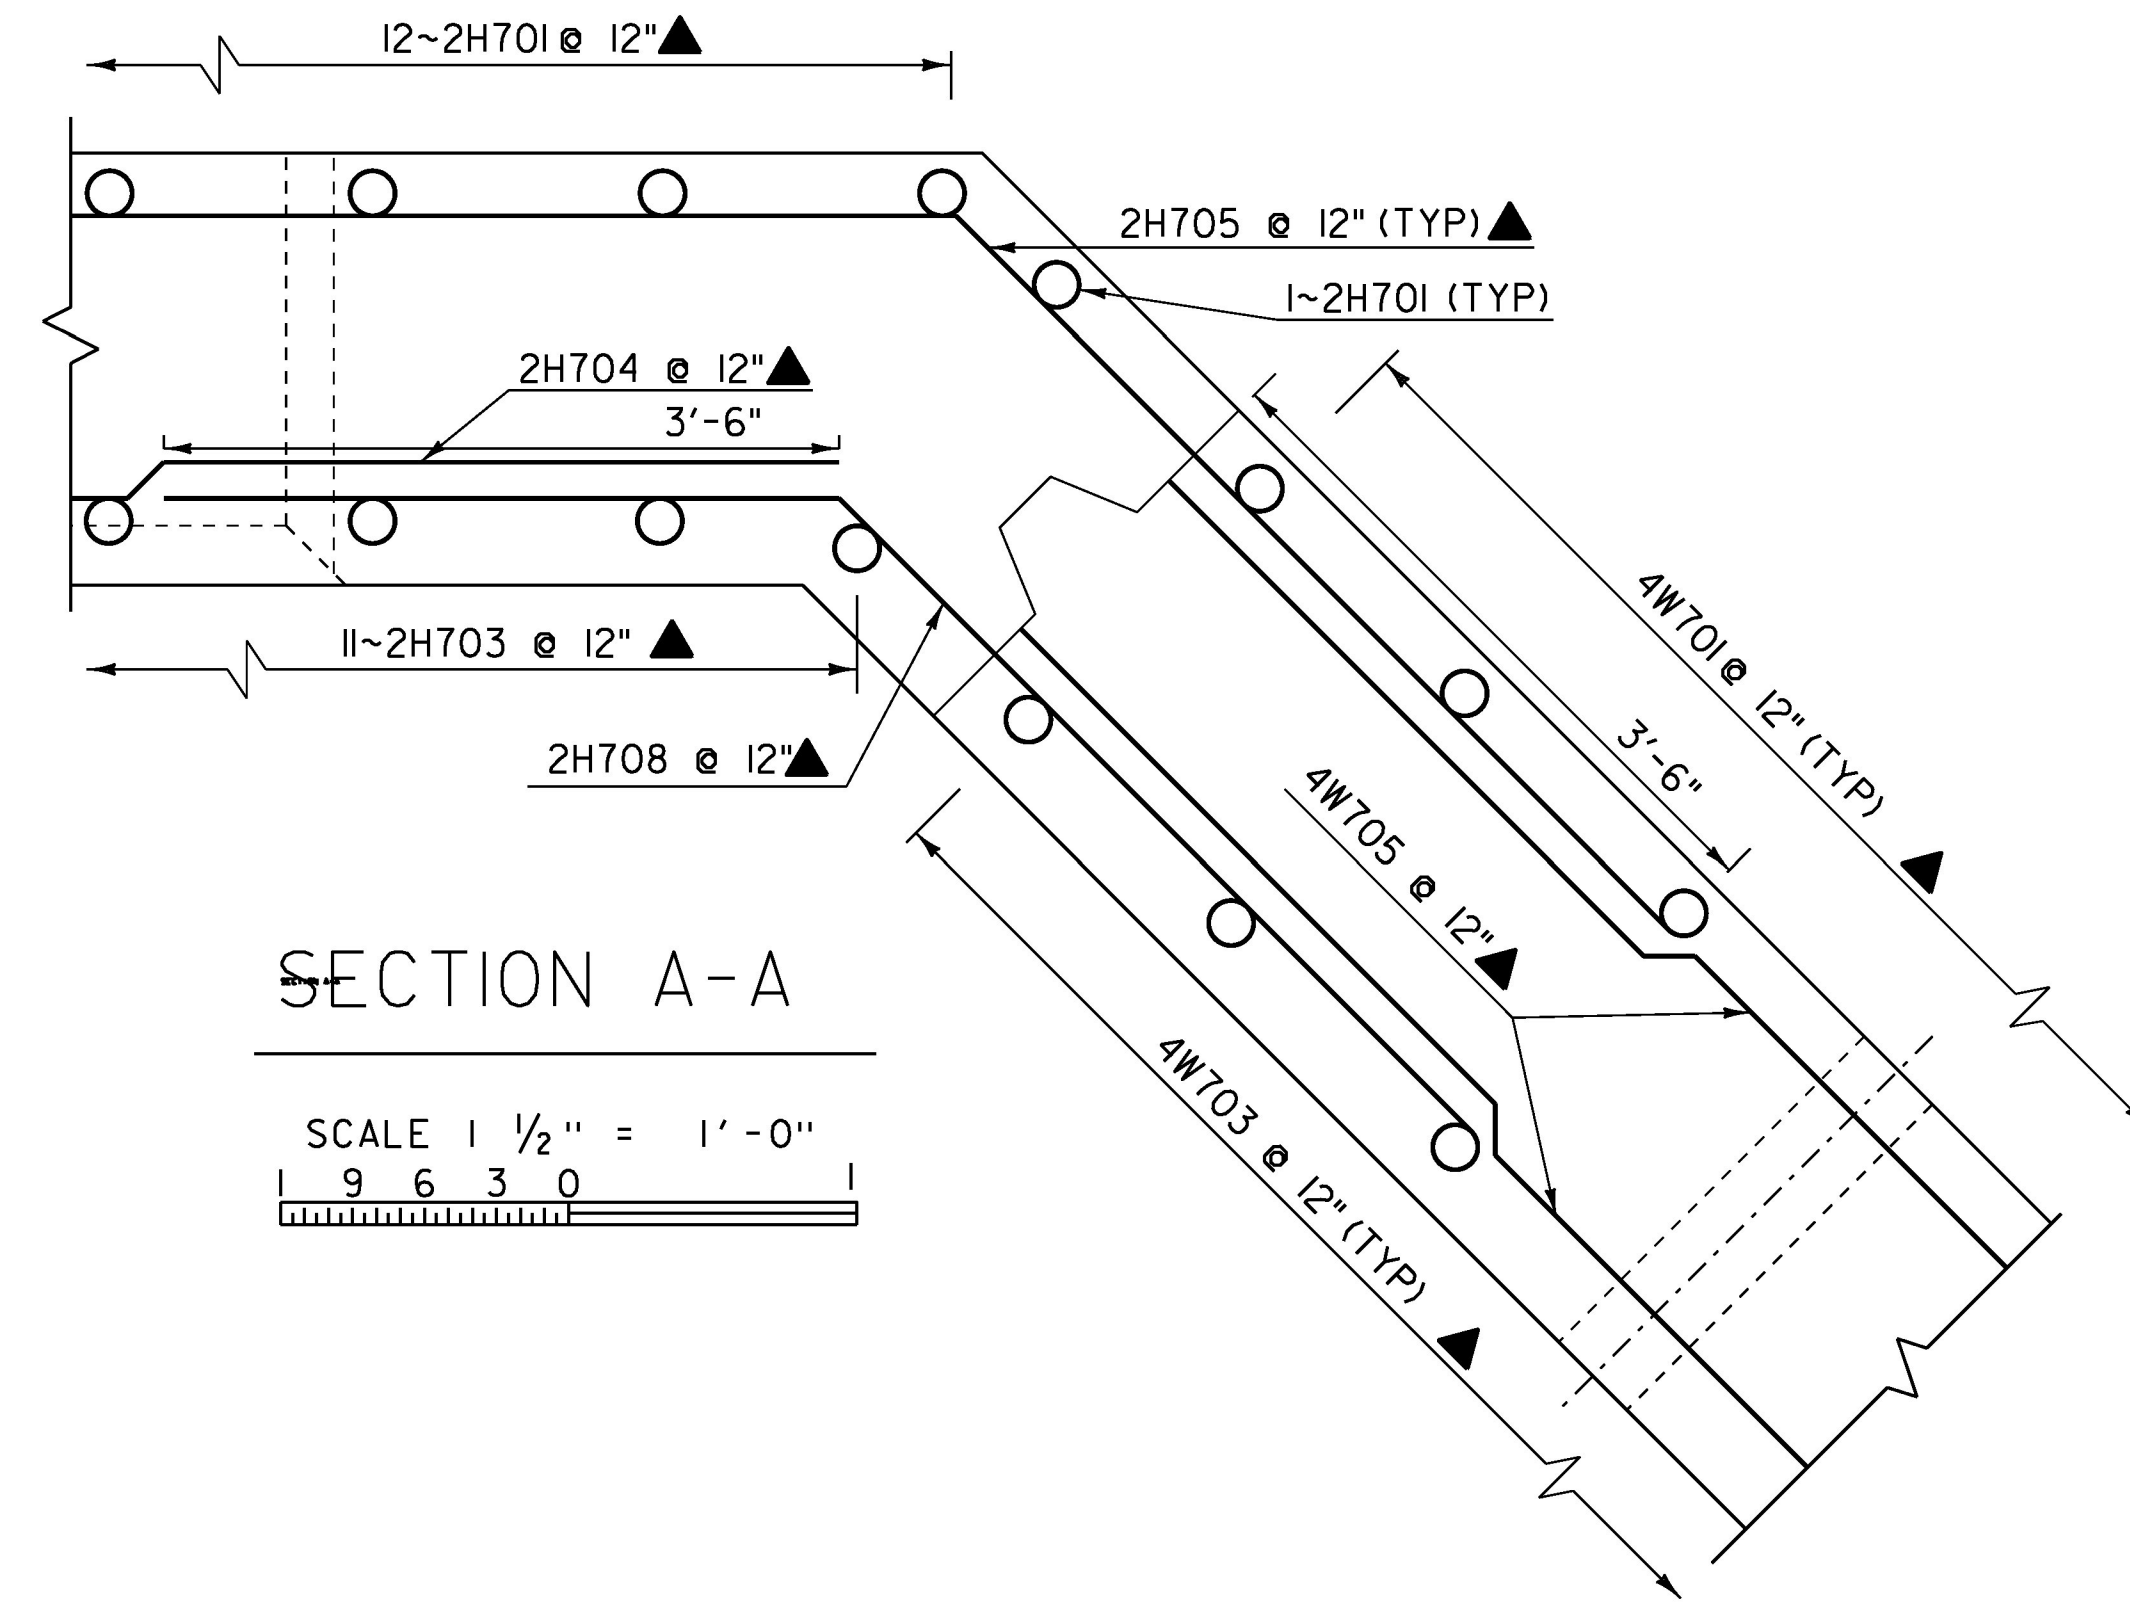

SECTION A-A

SCALE 1 1/2" = 1'-0"
 9 6 3 0

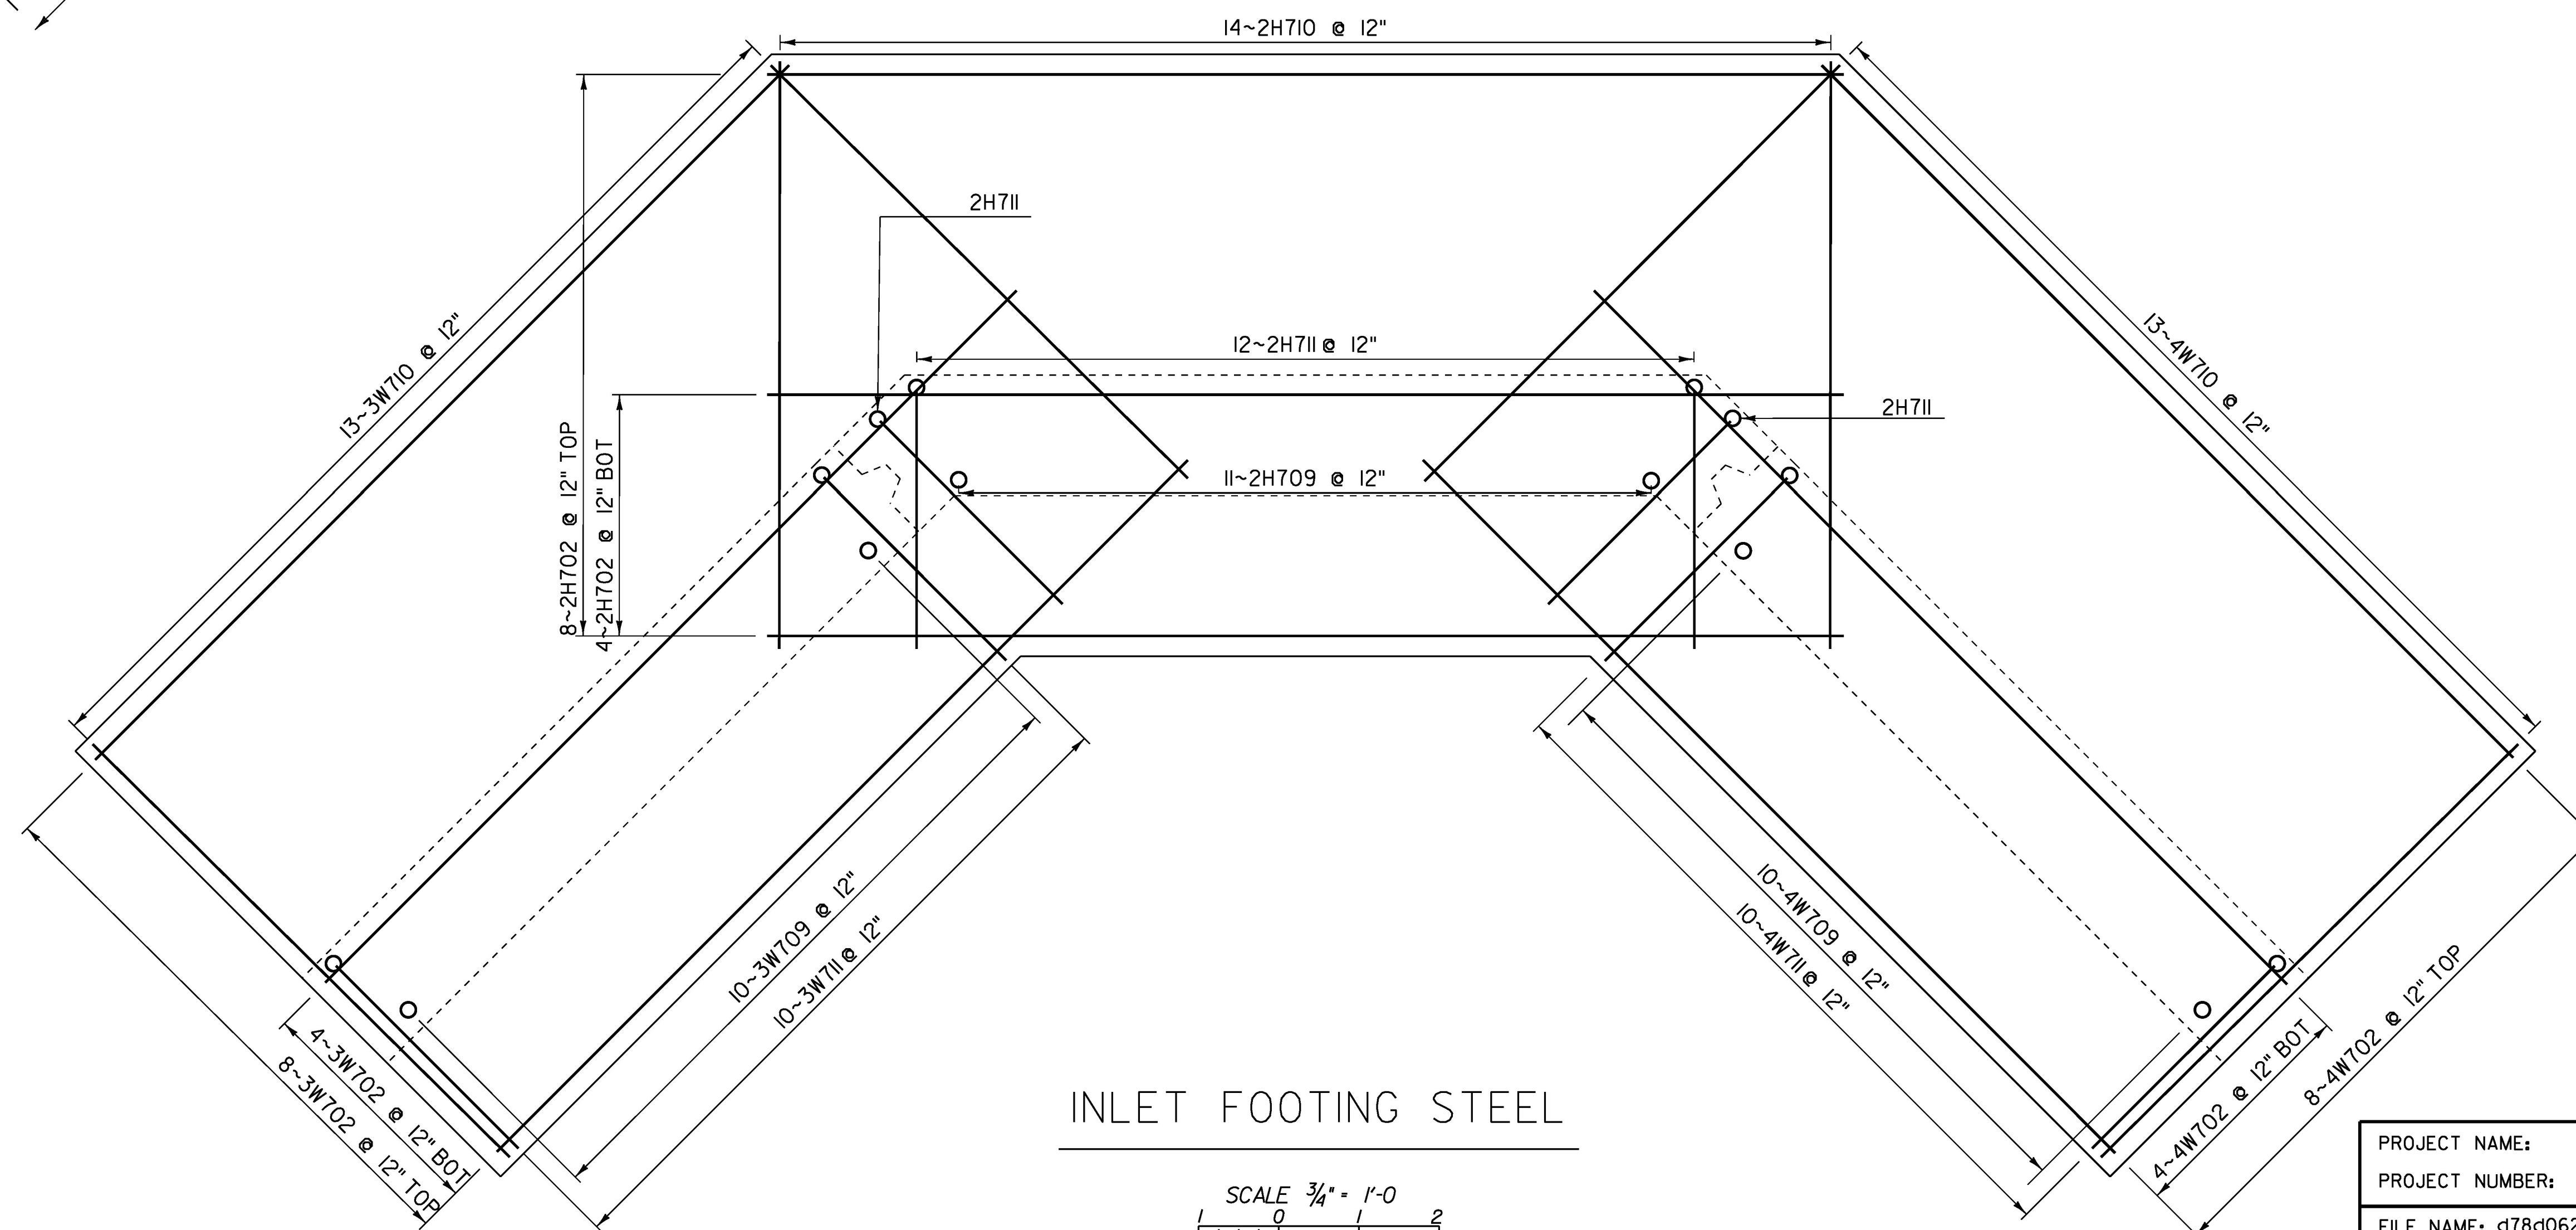

INLET FOOTING STEEL

SCALE 3/4" = 1'-0"
 0 1 2

NOTE:
 NF = NEAR FACE
 FF = FAR FACE
 EF = EACH FACE
 ▲ = CUT TO FIT IN FIELD
 3" CLR. UNLESS OTHERWISE
 SPECIFIED ON THE PLANS.

PROJECT NAME:	CHARLOTTE
PROJECT NUMBER:	F EGC 019-4(20)
FILE NAME:	d78d062.typ.dgn
PROJECT LEADER:	K. UPMAL
DESIGNED BY:	A. KEMPTON
STA 40+42 INLET FOOTING DETAILS SHEET	SHEET 241 OF 499
PLOT DATE:	15-MAR-2016
DRAWN BY:	A. KEMPTON
CHECKED BY:	C. LEACH