




I+20

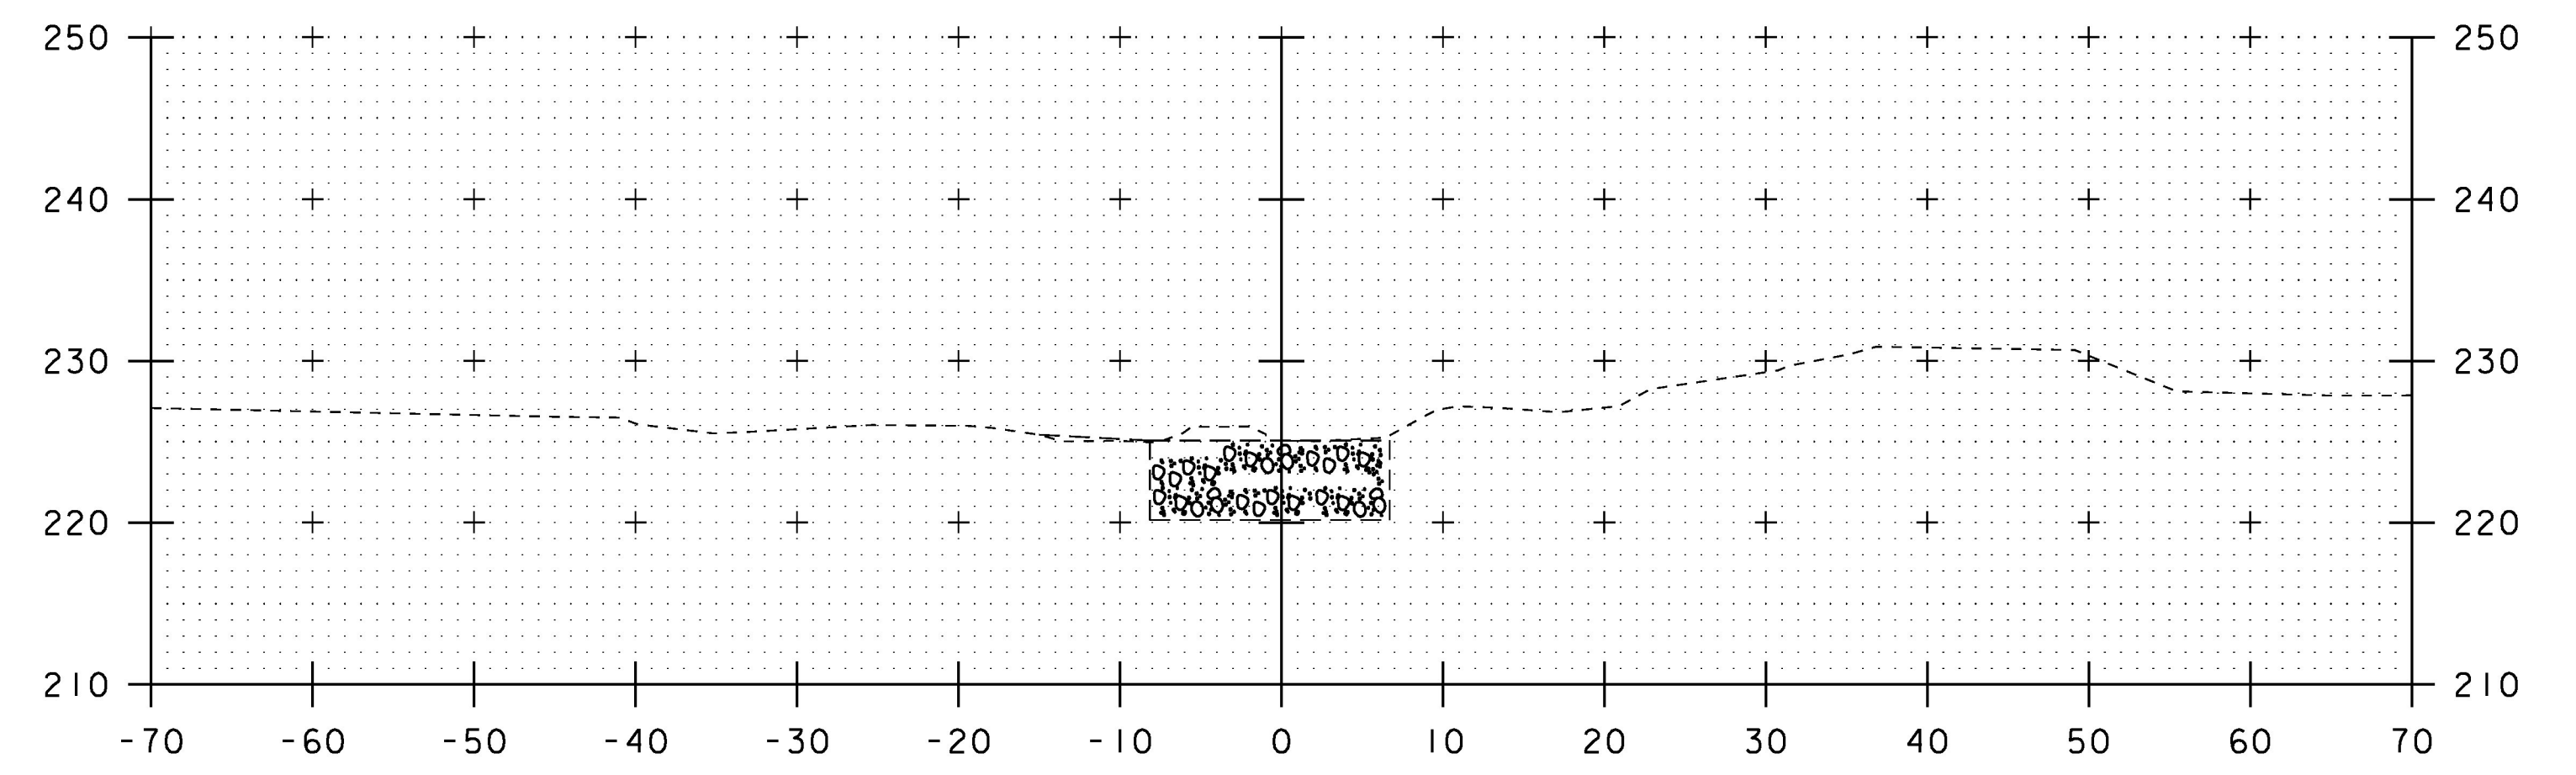


I+40

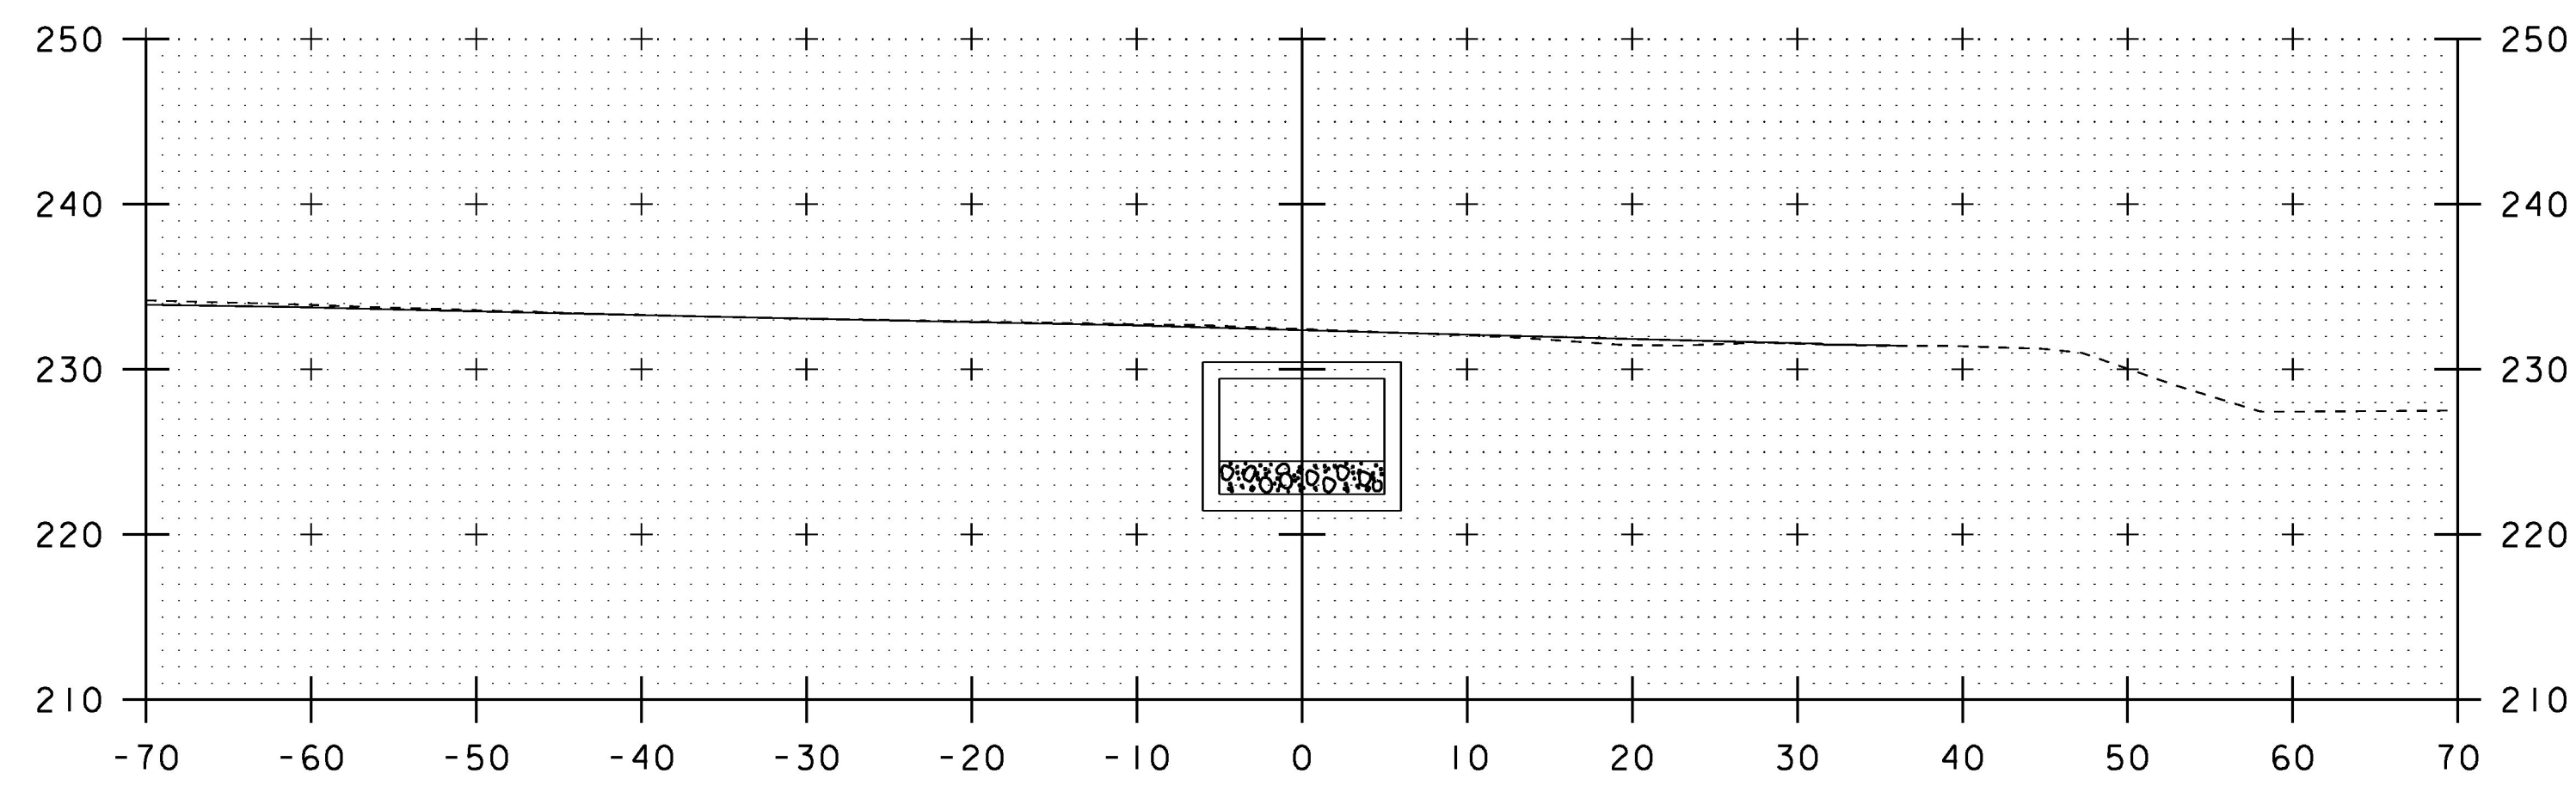


I+10

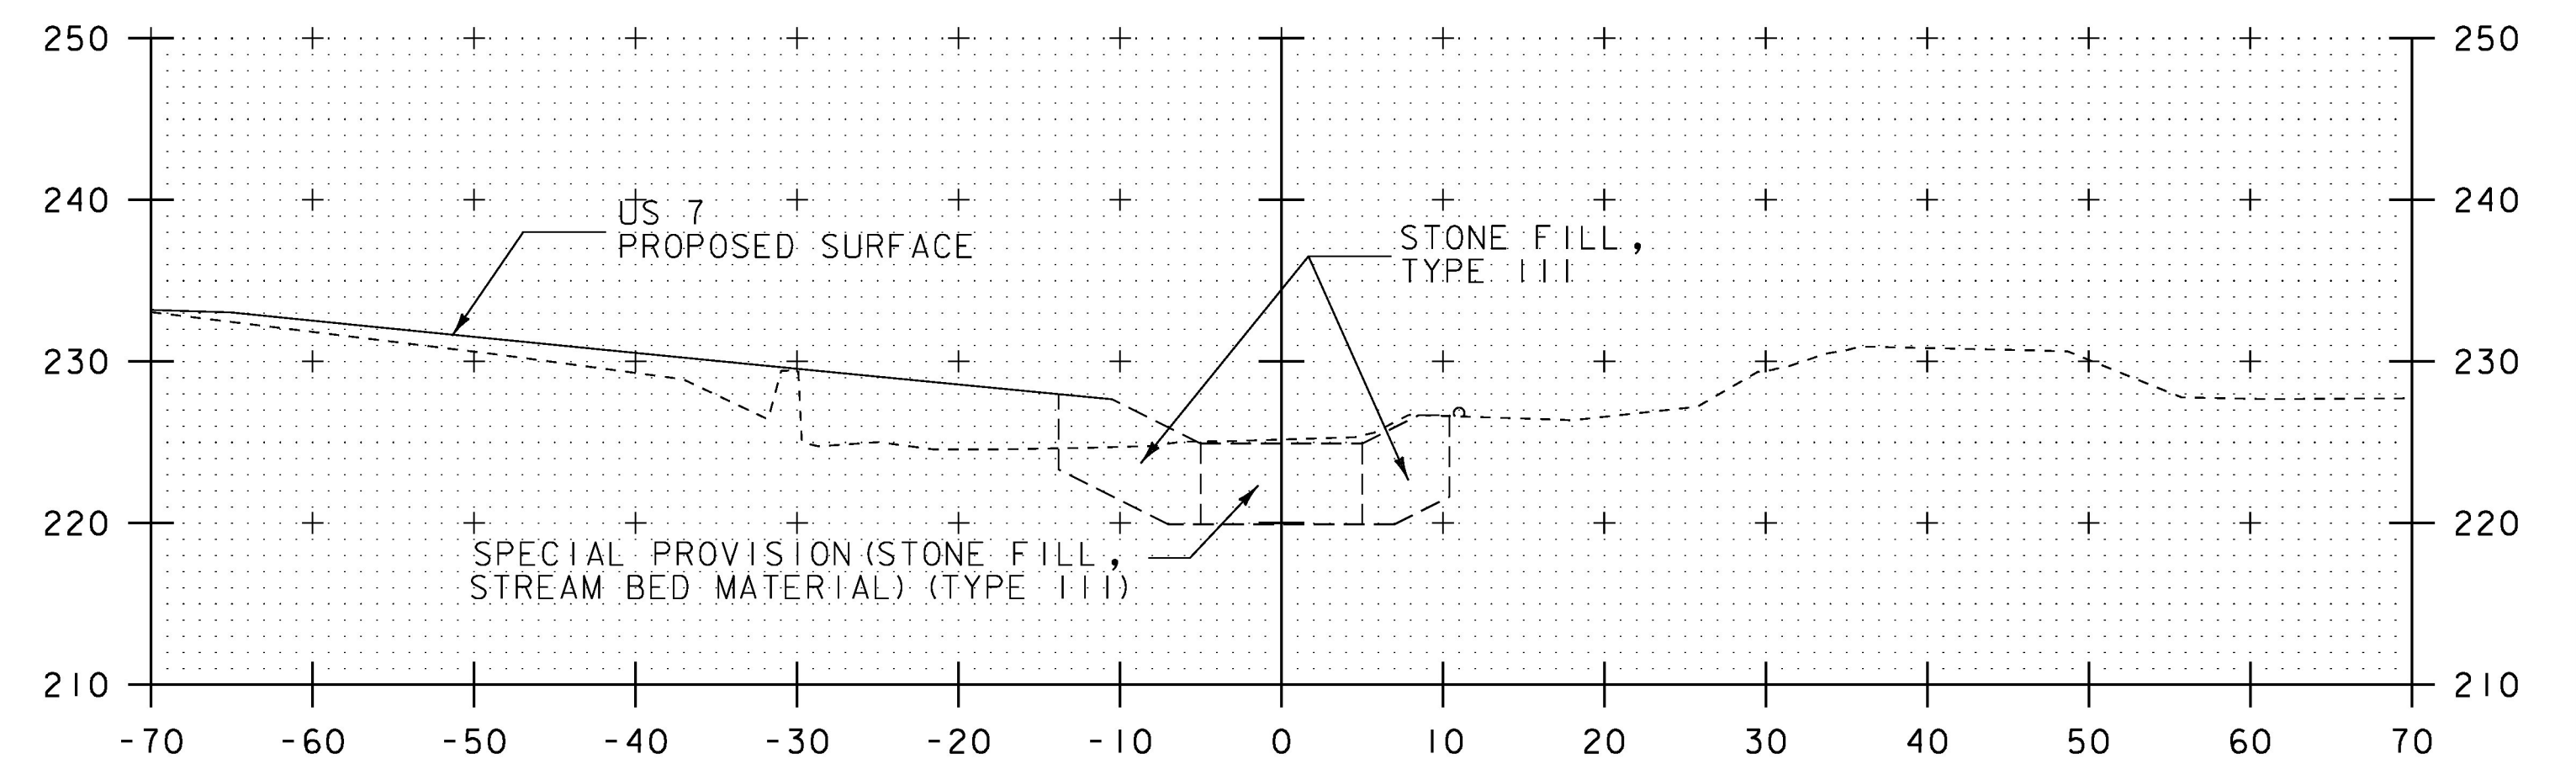

I+30

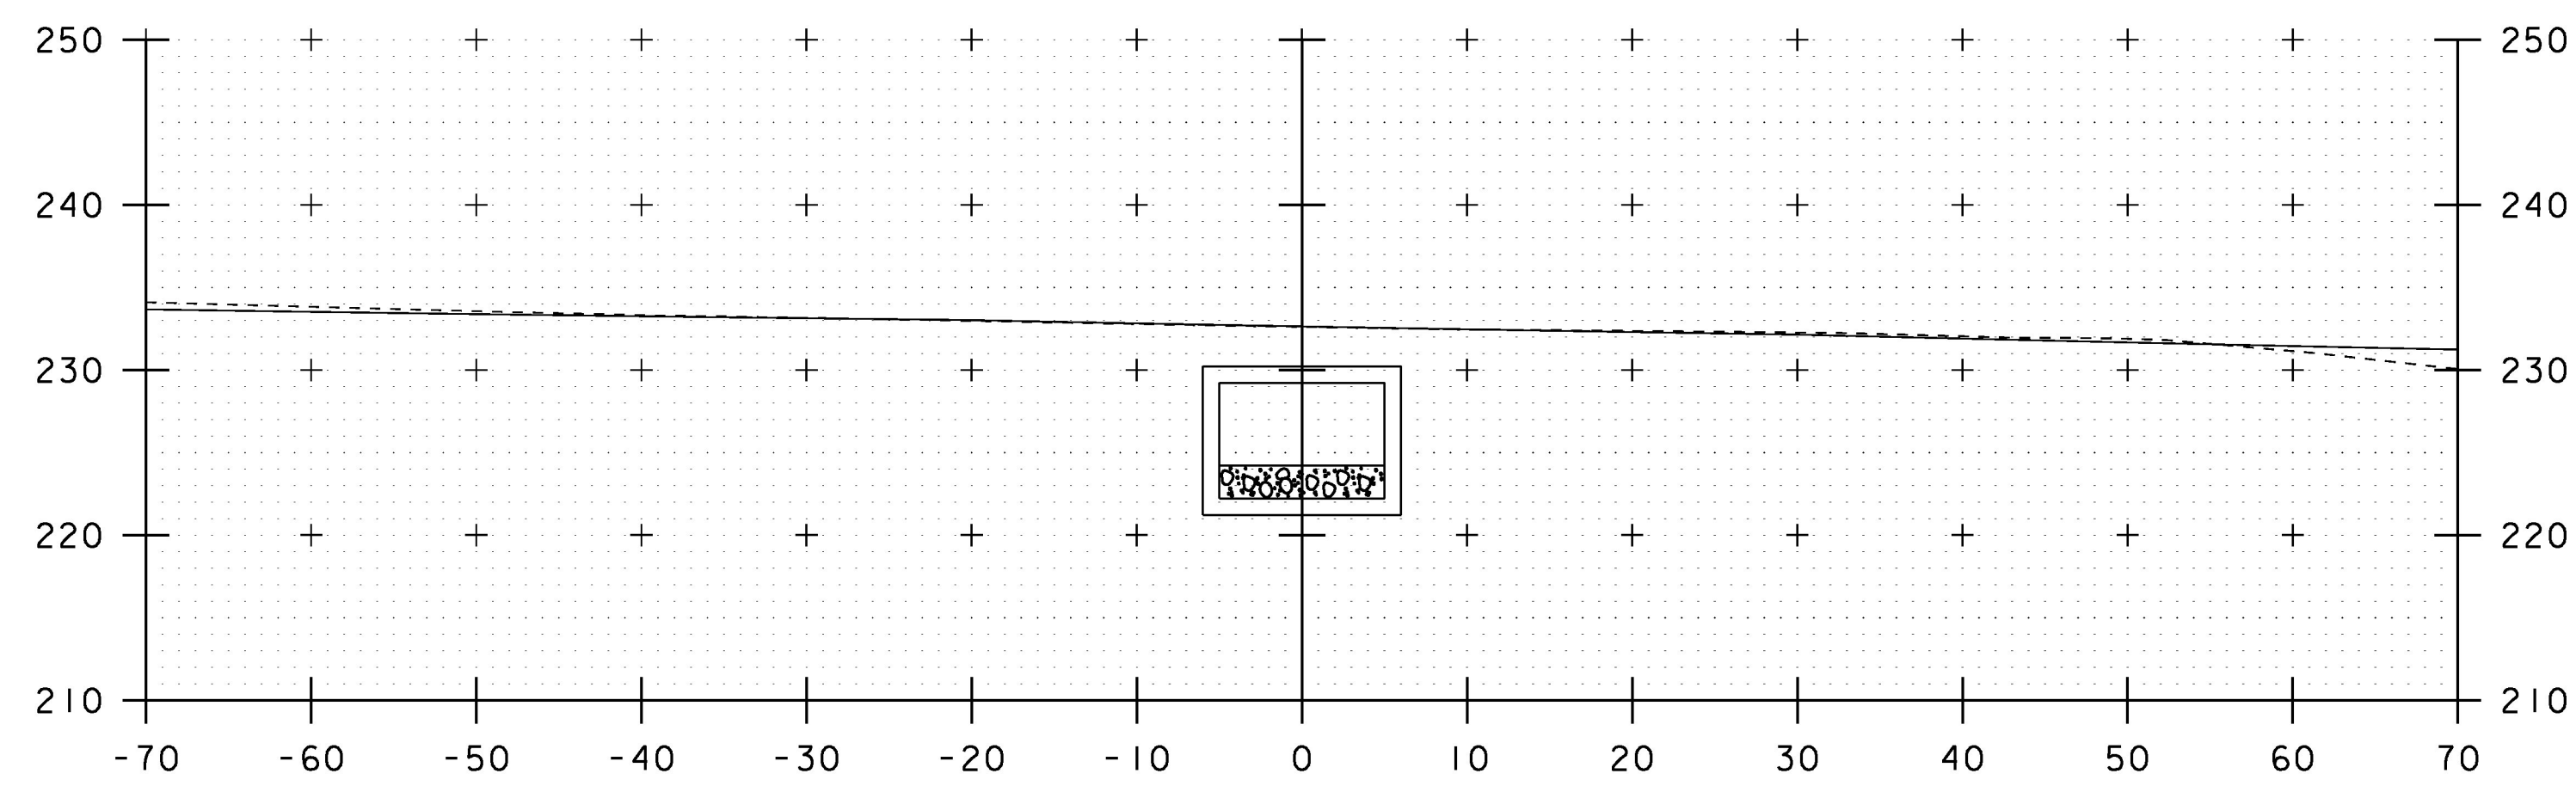

I+00

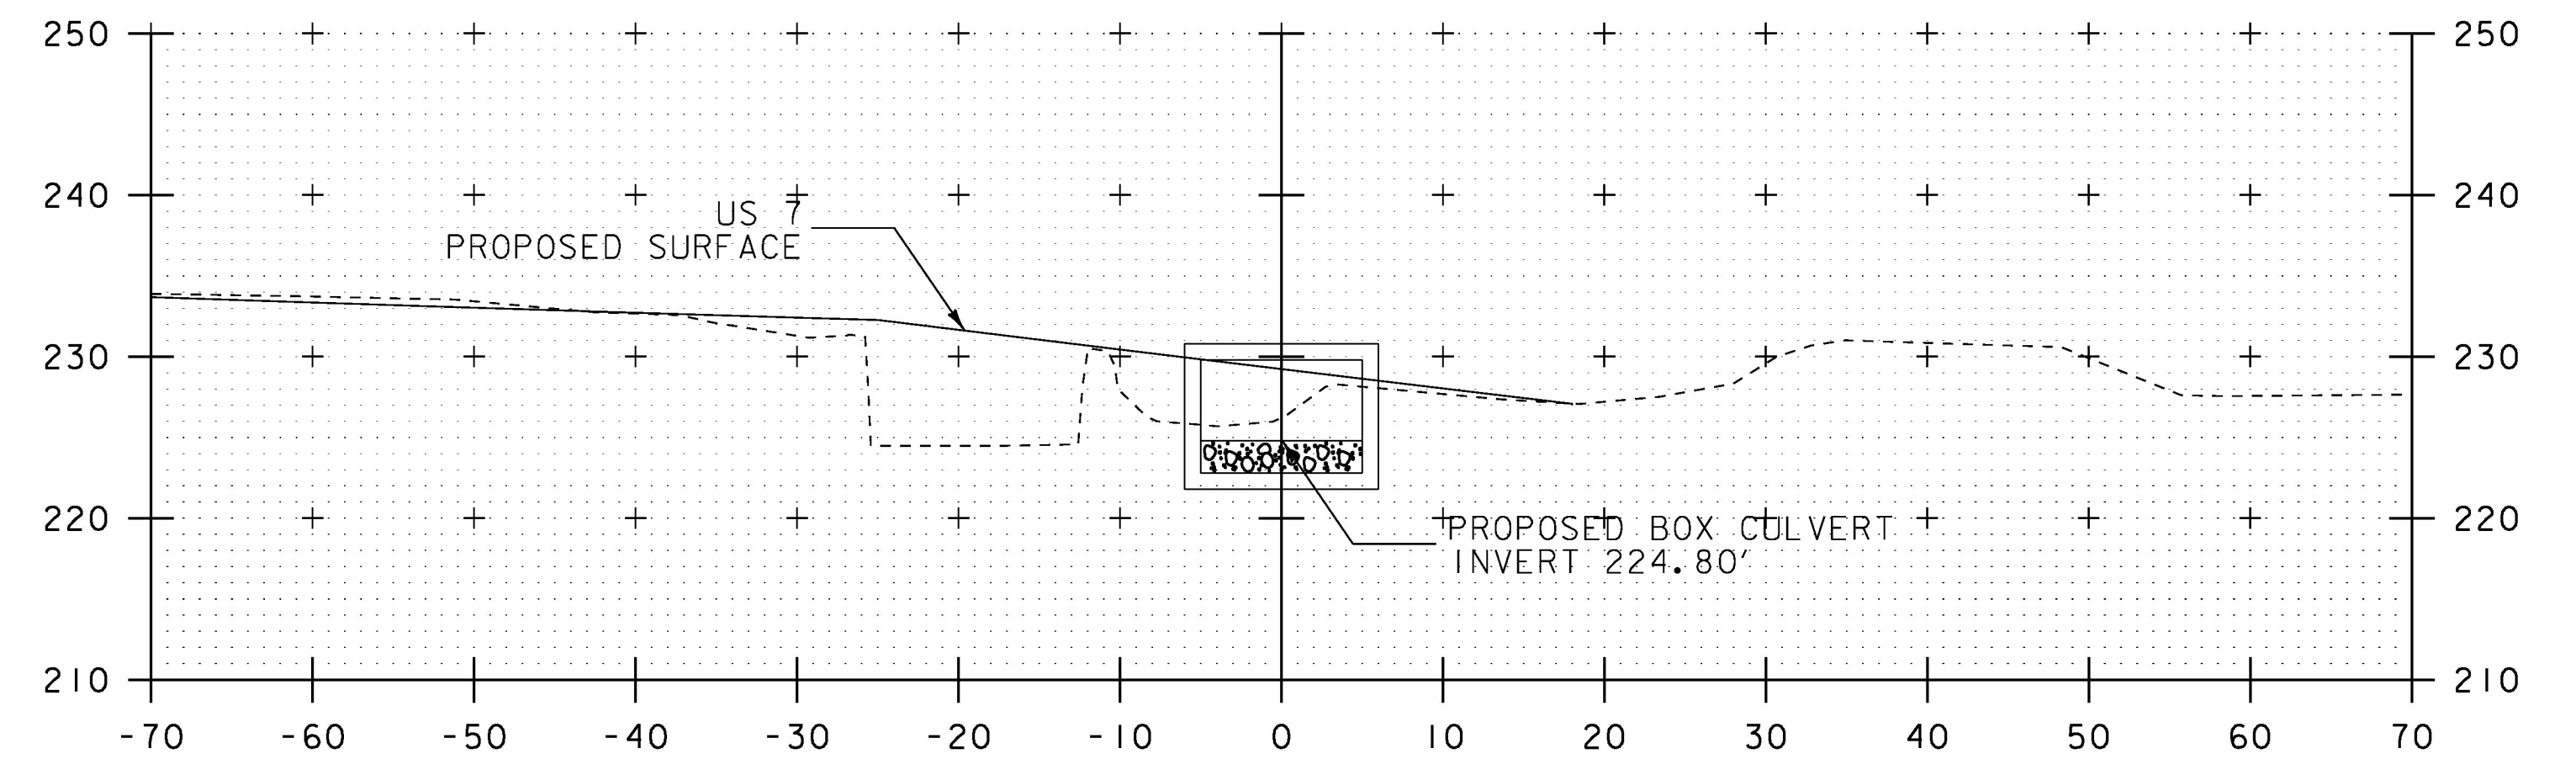

I+24.74
END BOX CULVERT
BR 141

STA. 1+00 TO STA. 1+40

PROJECT NAME: CHARLOTTE	
PROJECT NUMBER: F EGC 019-4(20)	
FILE NAME: d78d062_typ.dgn	PLOT DATE: 15-MAR-2016
PROJECT LEADER: K. UPMAL	DRAWN BY: C. LEACH
DESIGNED BY: B. KIPP	CHECKED BY: J. FLOOD
BR 141 CHANNEL CROSS SECTIONS	SHEET 249 OF 499