


WEST PATH PROFILE

HORIZONTAL SCALE: 1' = 20'
 VERTICAL SCALE: 1" = 10'

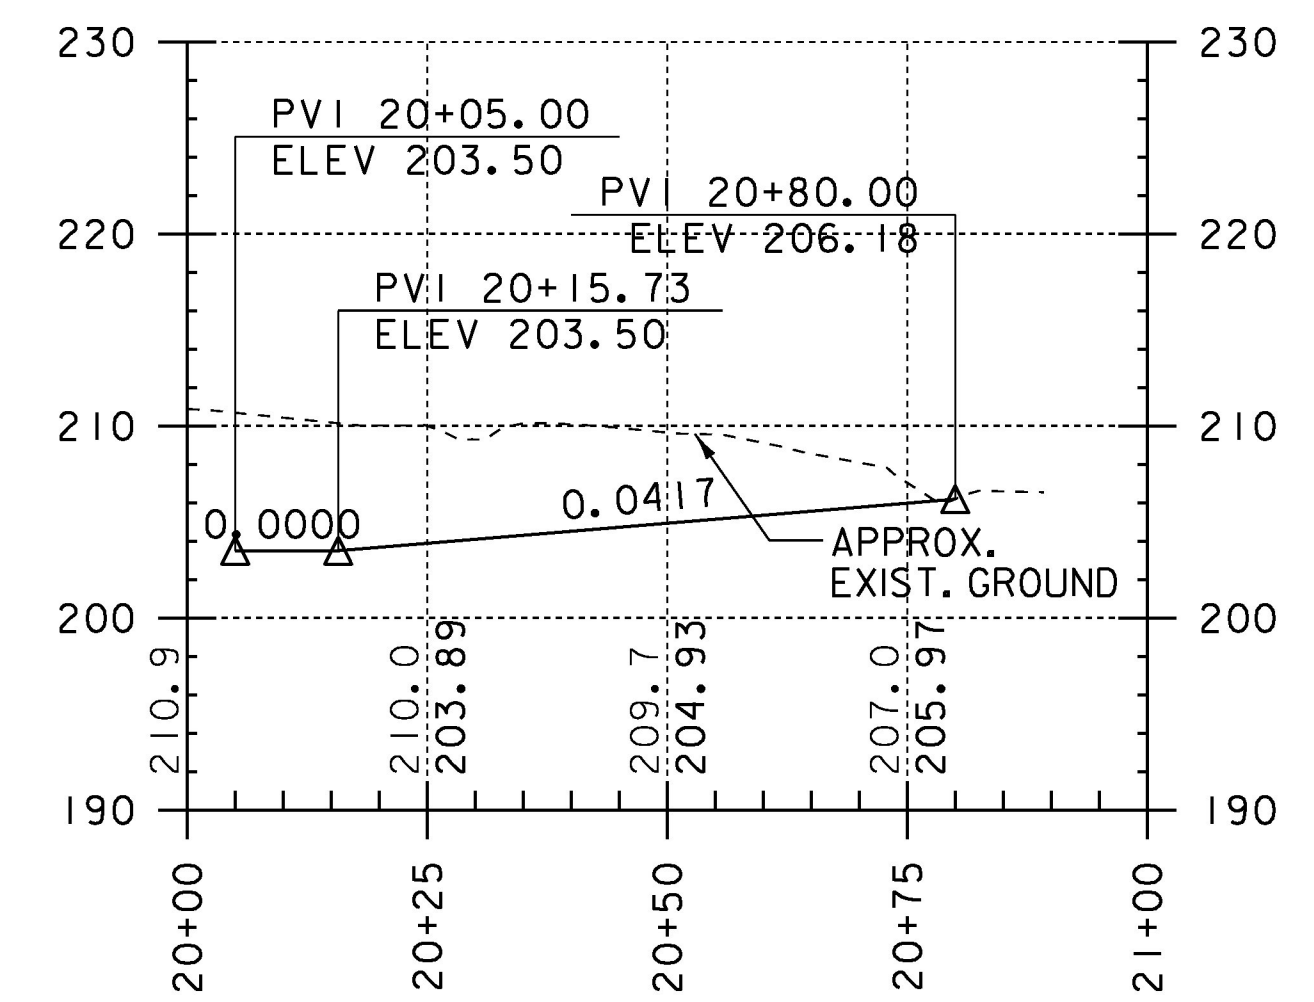

PATH ACCESS PROFILE

HORIZONTAL SCALE: 1' = 20'
 VERTICAL SCALE: 1" = 10'

NOTE: ELEVATIONS SHOWN TO THE NEAREST TENTH ARE EXISTING GROUND.
 ELEVATIONS SHOWN TO THE NEAREST HUNDREDTH ARE FINISH GRADE.

PROJECT NAME:	CHARLOTTE
PROJECT NUMBER:	F EGC 019-4(20)
FILE NAME: \$FILES*	PLOT DATE: 15-MAR-2016
PROJECT LEADER: G. BOGUE	DRAWN BY: L. BUXTON
DESIGNED BY: T. KNIGHT	CHECKED BY: G. BOGUE
WEST PATH & PATH ACCESS PROFILE SHEET SHEET 254 OF 499	

