



DRAINAGE PROFILE 2

HORIZONTAL SCALE: 1' = 30'
VERTICAL SCALE: 1" = 15'

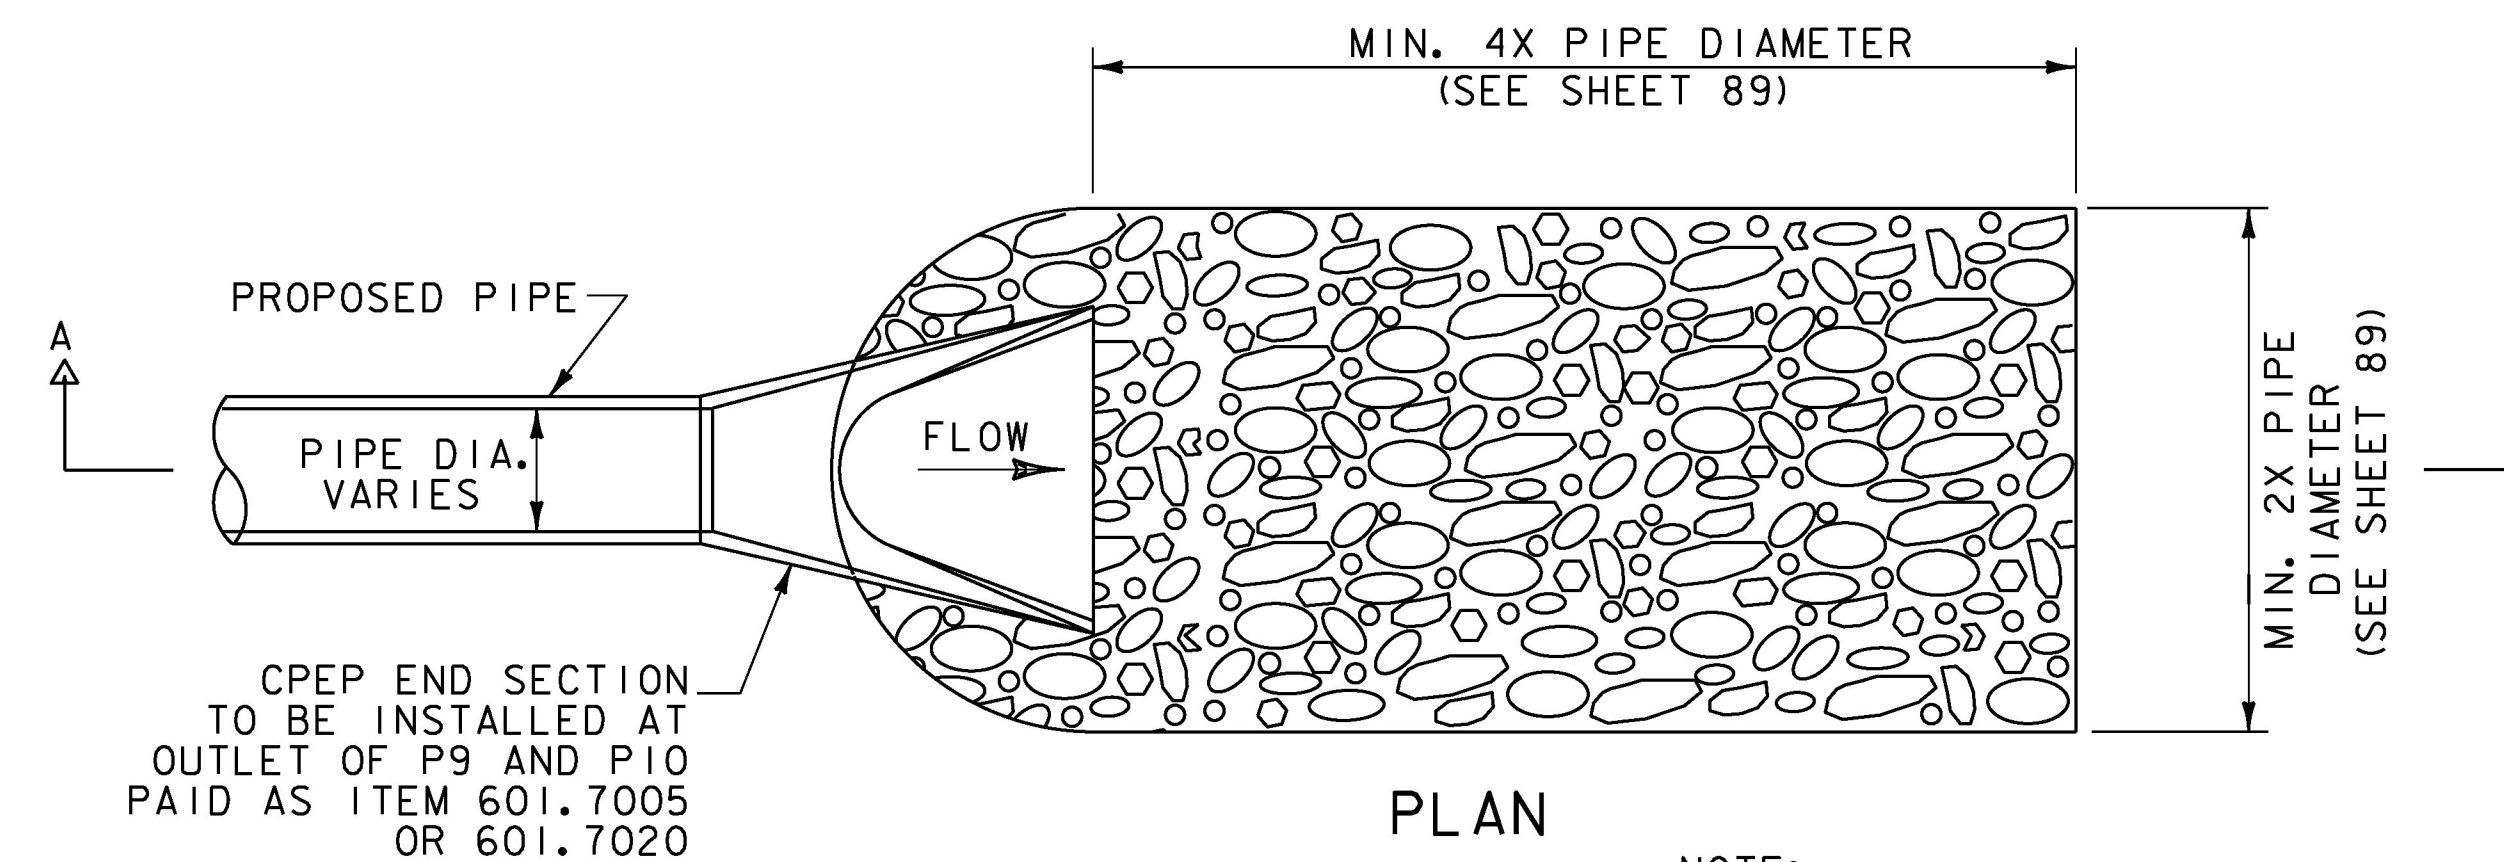

NOTE:
PAYMENT FOR STORM DRAIN
OUTLET PROTECTION EXCAVATION
WILL BE PAID AS ITEM 203.15.

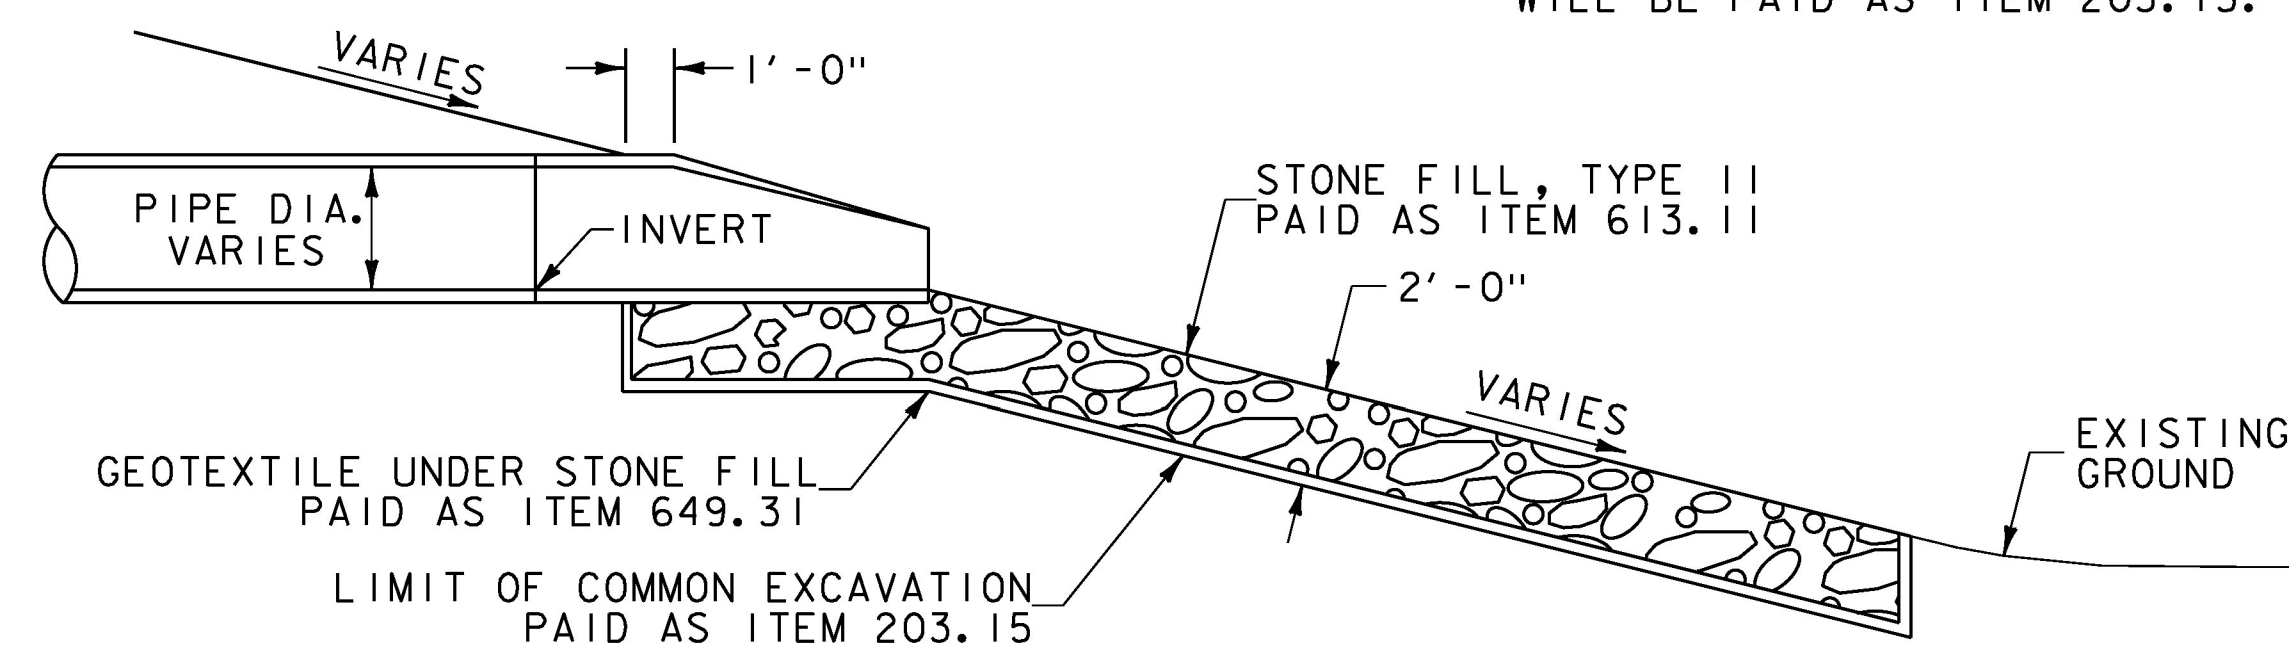

STORM DRAIN OUTLET PROTECTION
NOT TO SCALE

PROJECT NAME: CHARLOTTE
PROJECT NUMBER: F EGC 019-4(20)

FILE NAME: \$FILES\$
PROJECT LEADER: G. BOGUE
DESIGNED BY: T. KNIGHT
PATH DRAINAGE SHEET 2

PLOT DATE: 15-MAR-2016
DRAWN BY: L. BUXTON
CHECKED BY: G. BOGUE
SHEET 257 OF 499

