


13+36

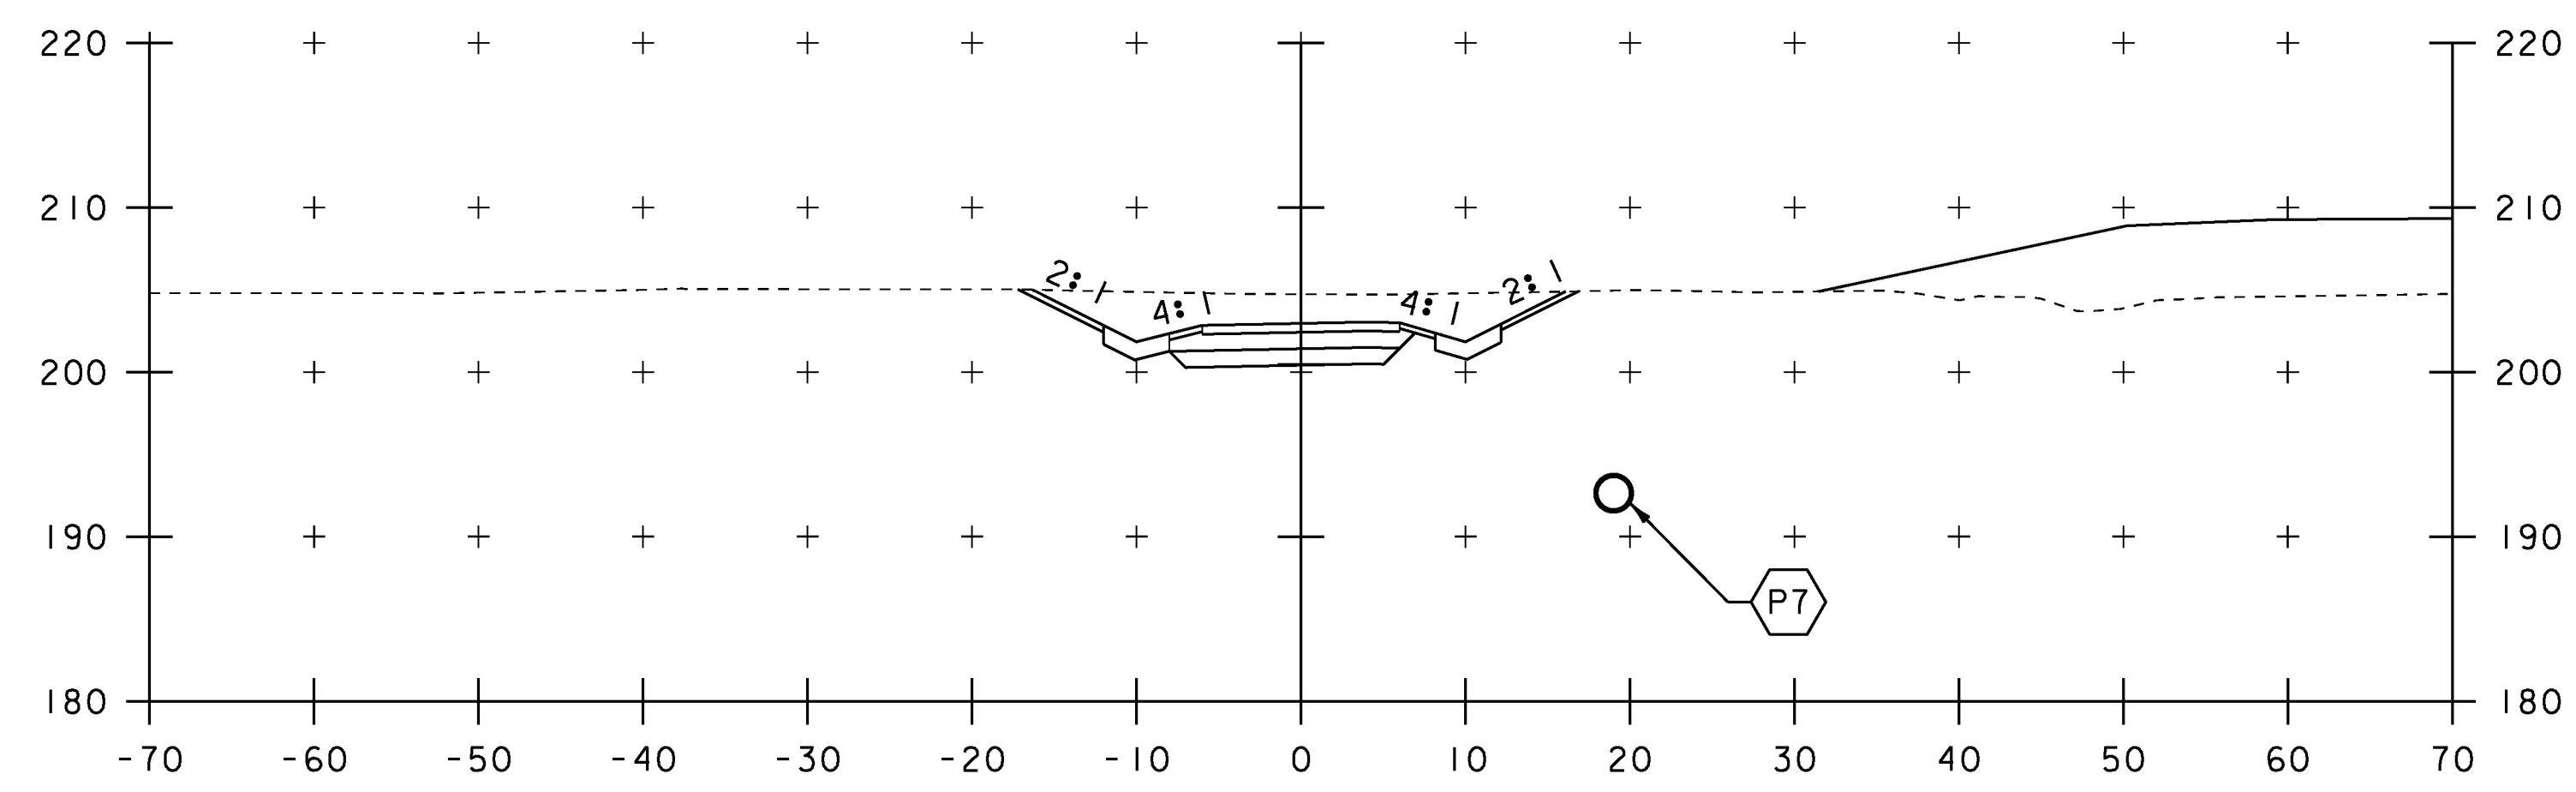

13+00

NOTE: SEE PROFILE FOR FINISH GRADE.

PROJECT NAME: CHARLOTTE	
PROJECT NUMBER: F EGC 019-4(20)	
FILE NAME: z78d062_Pathxs.dgn	PLOT DATE: 15-MAR-2016
PROJECT LEADER: G. BOGUE	DRAWN BY: L. BUXTON
DESIGNED BY: T. KNIGHT	CHECKED BY: G. BOGUE
PATH CROSS SECTIONS 4	SHEET 261 OF 499

STA. 13+00 TO STA. 13+36

