



20+89

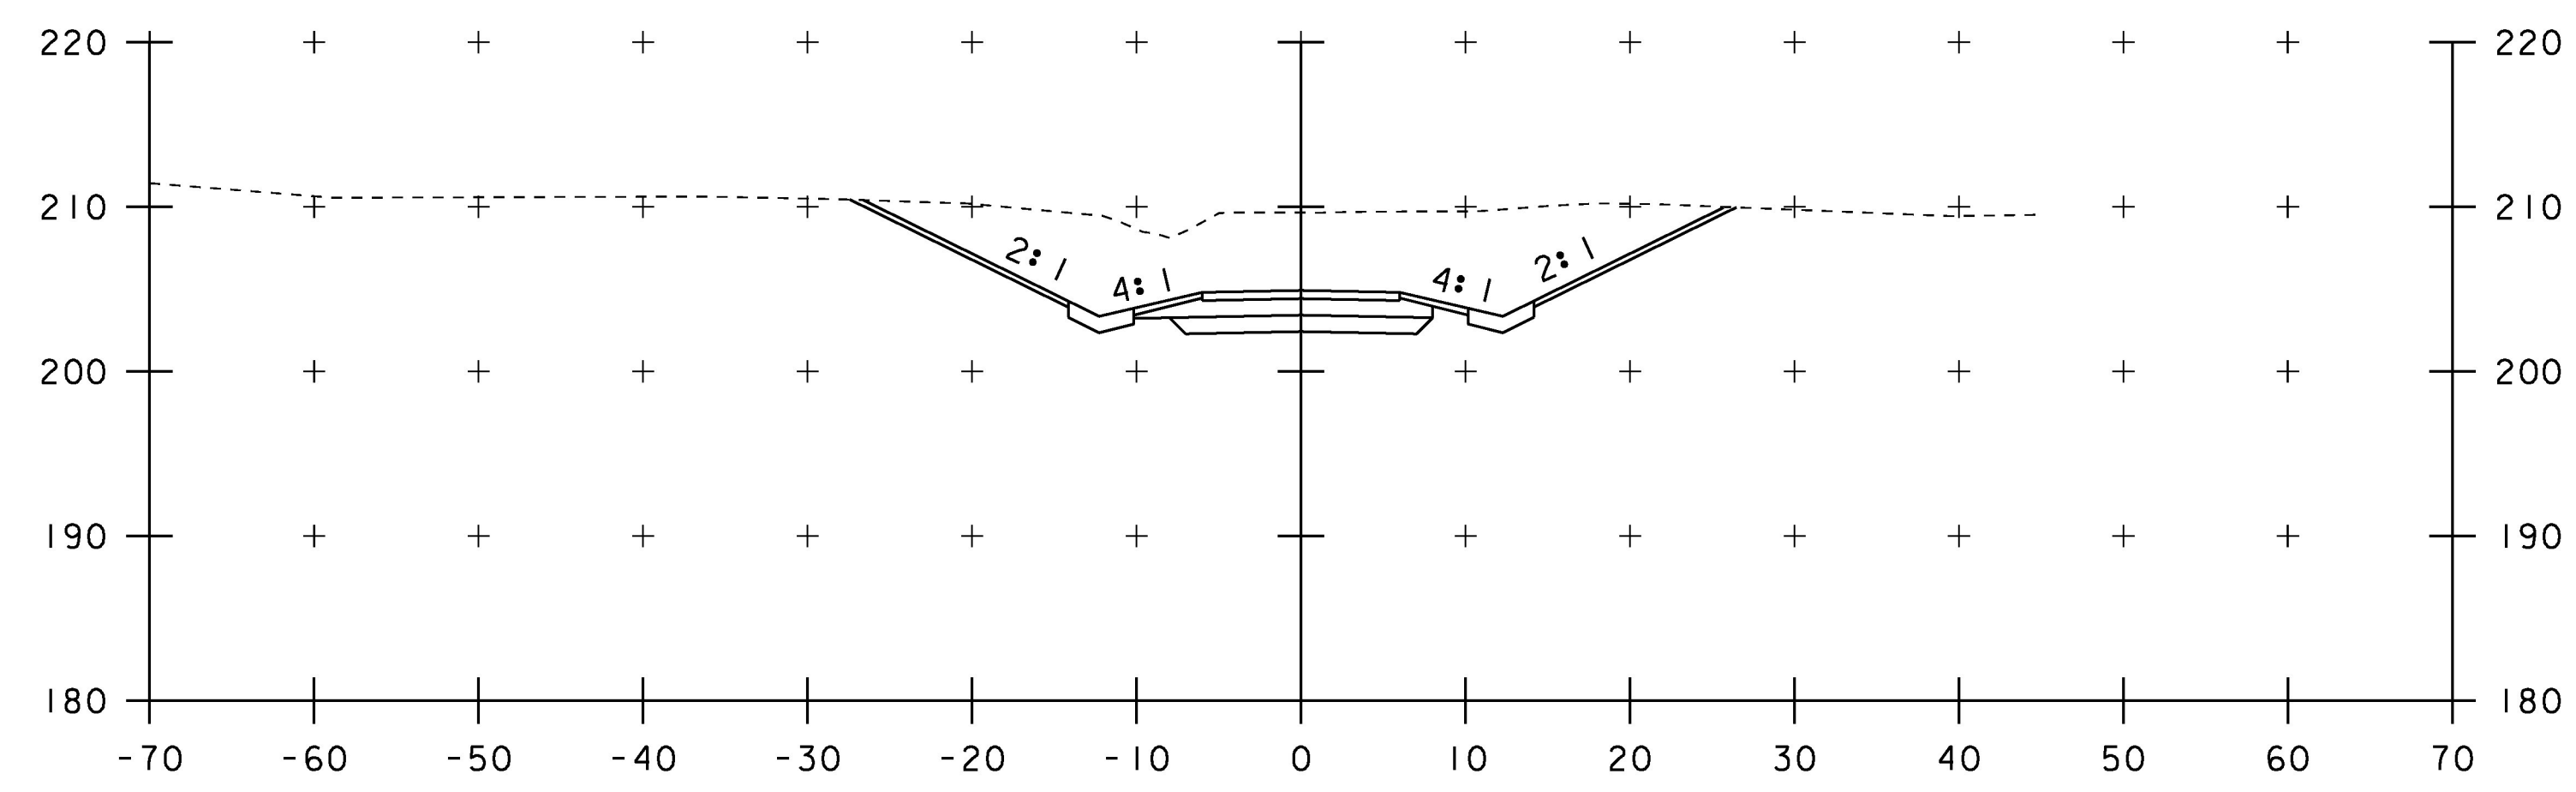

20+50

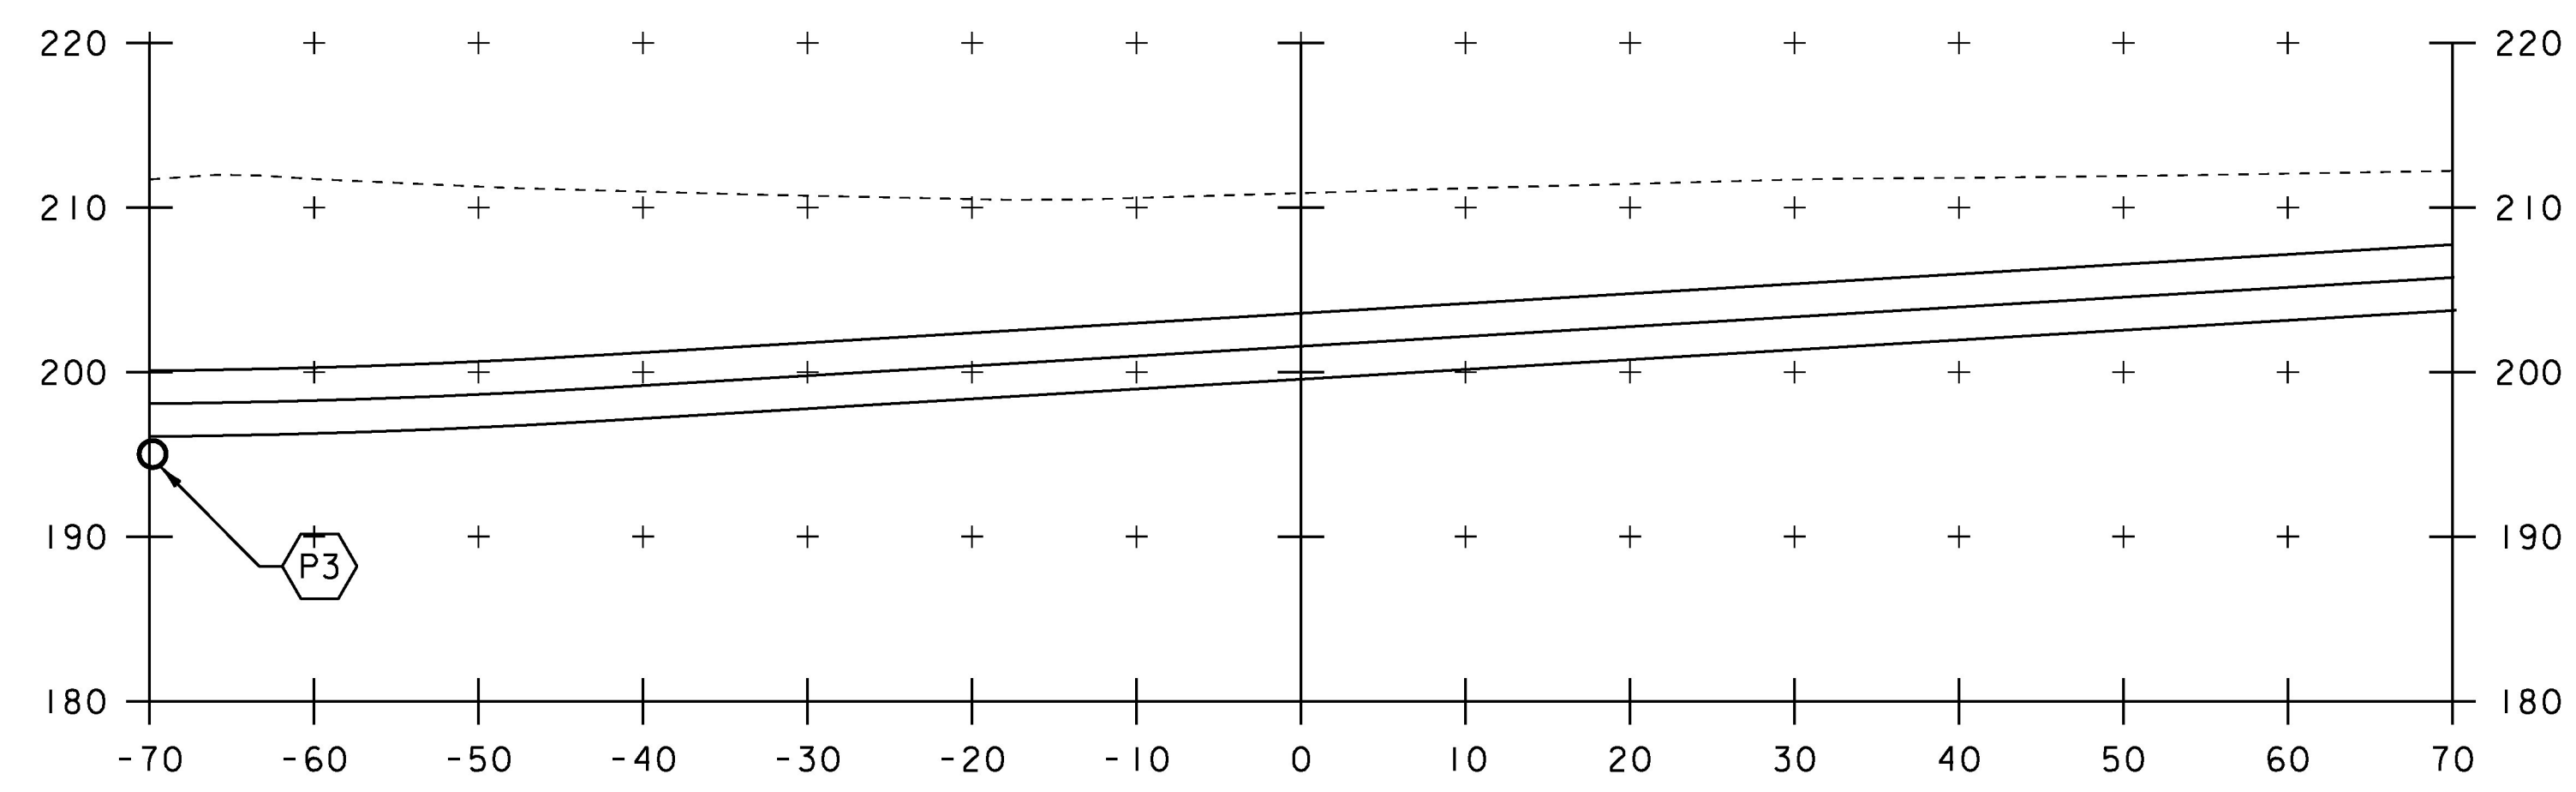

20+00

NOTE: SEE PROFILE FOR FINISH GRADE.

STA. 2+00 TO STA. 2+89



PROJECT NAME: CHARLOTTE	PLOT DATE: 15-MAR-2016
PROJECT NUMBER: F EGC 019-4(20)	DRAWN BY: L. BUXTON
FILE NAME: z78d062_Pathxs.dgn	DESIGNED BY: T. KNIGHT
PROJECT LEADER: G. BOGUE	CHECKED BY: G. BOGUE
PATH CROSS SECTIONS 5	SHEET 262 OF 499