



SECTION B-B

SCALE 1 1/2" = 1'-0"
 9 6 3 0

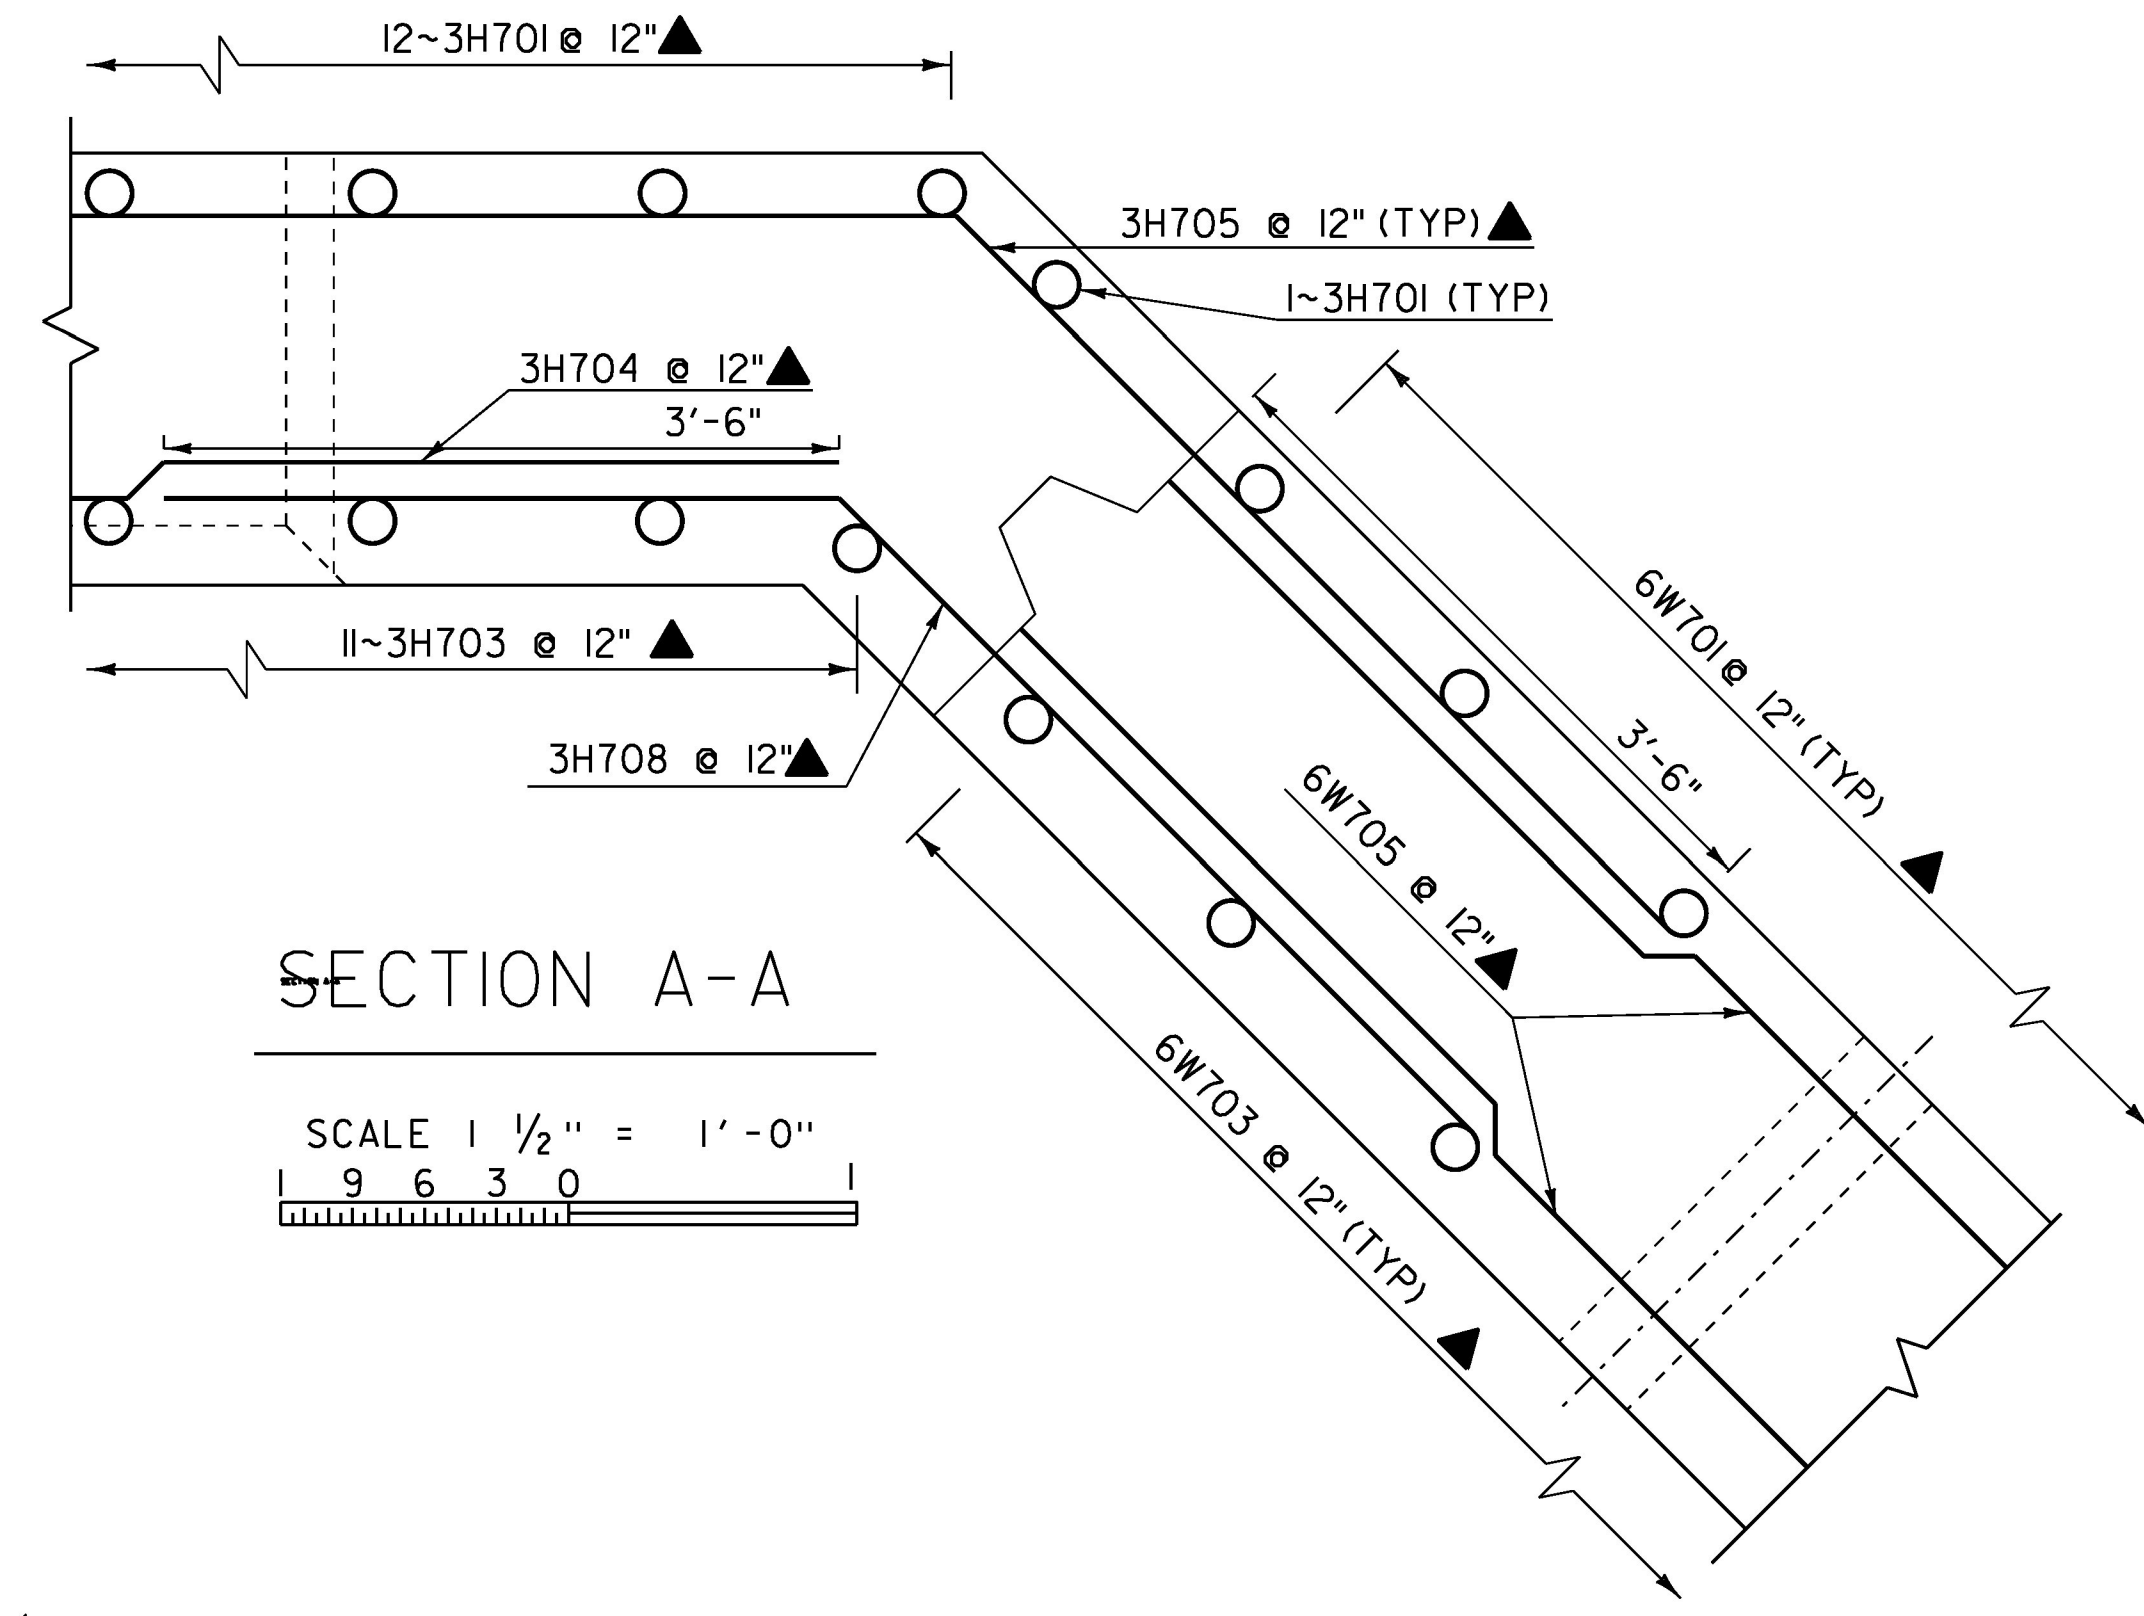

SECTION A-A

SCALE 1 1/2" = 1'-0"
 9 6 3 0

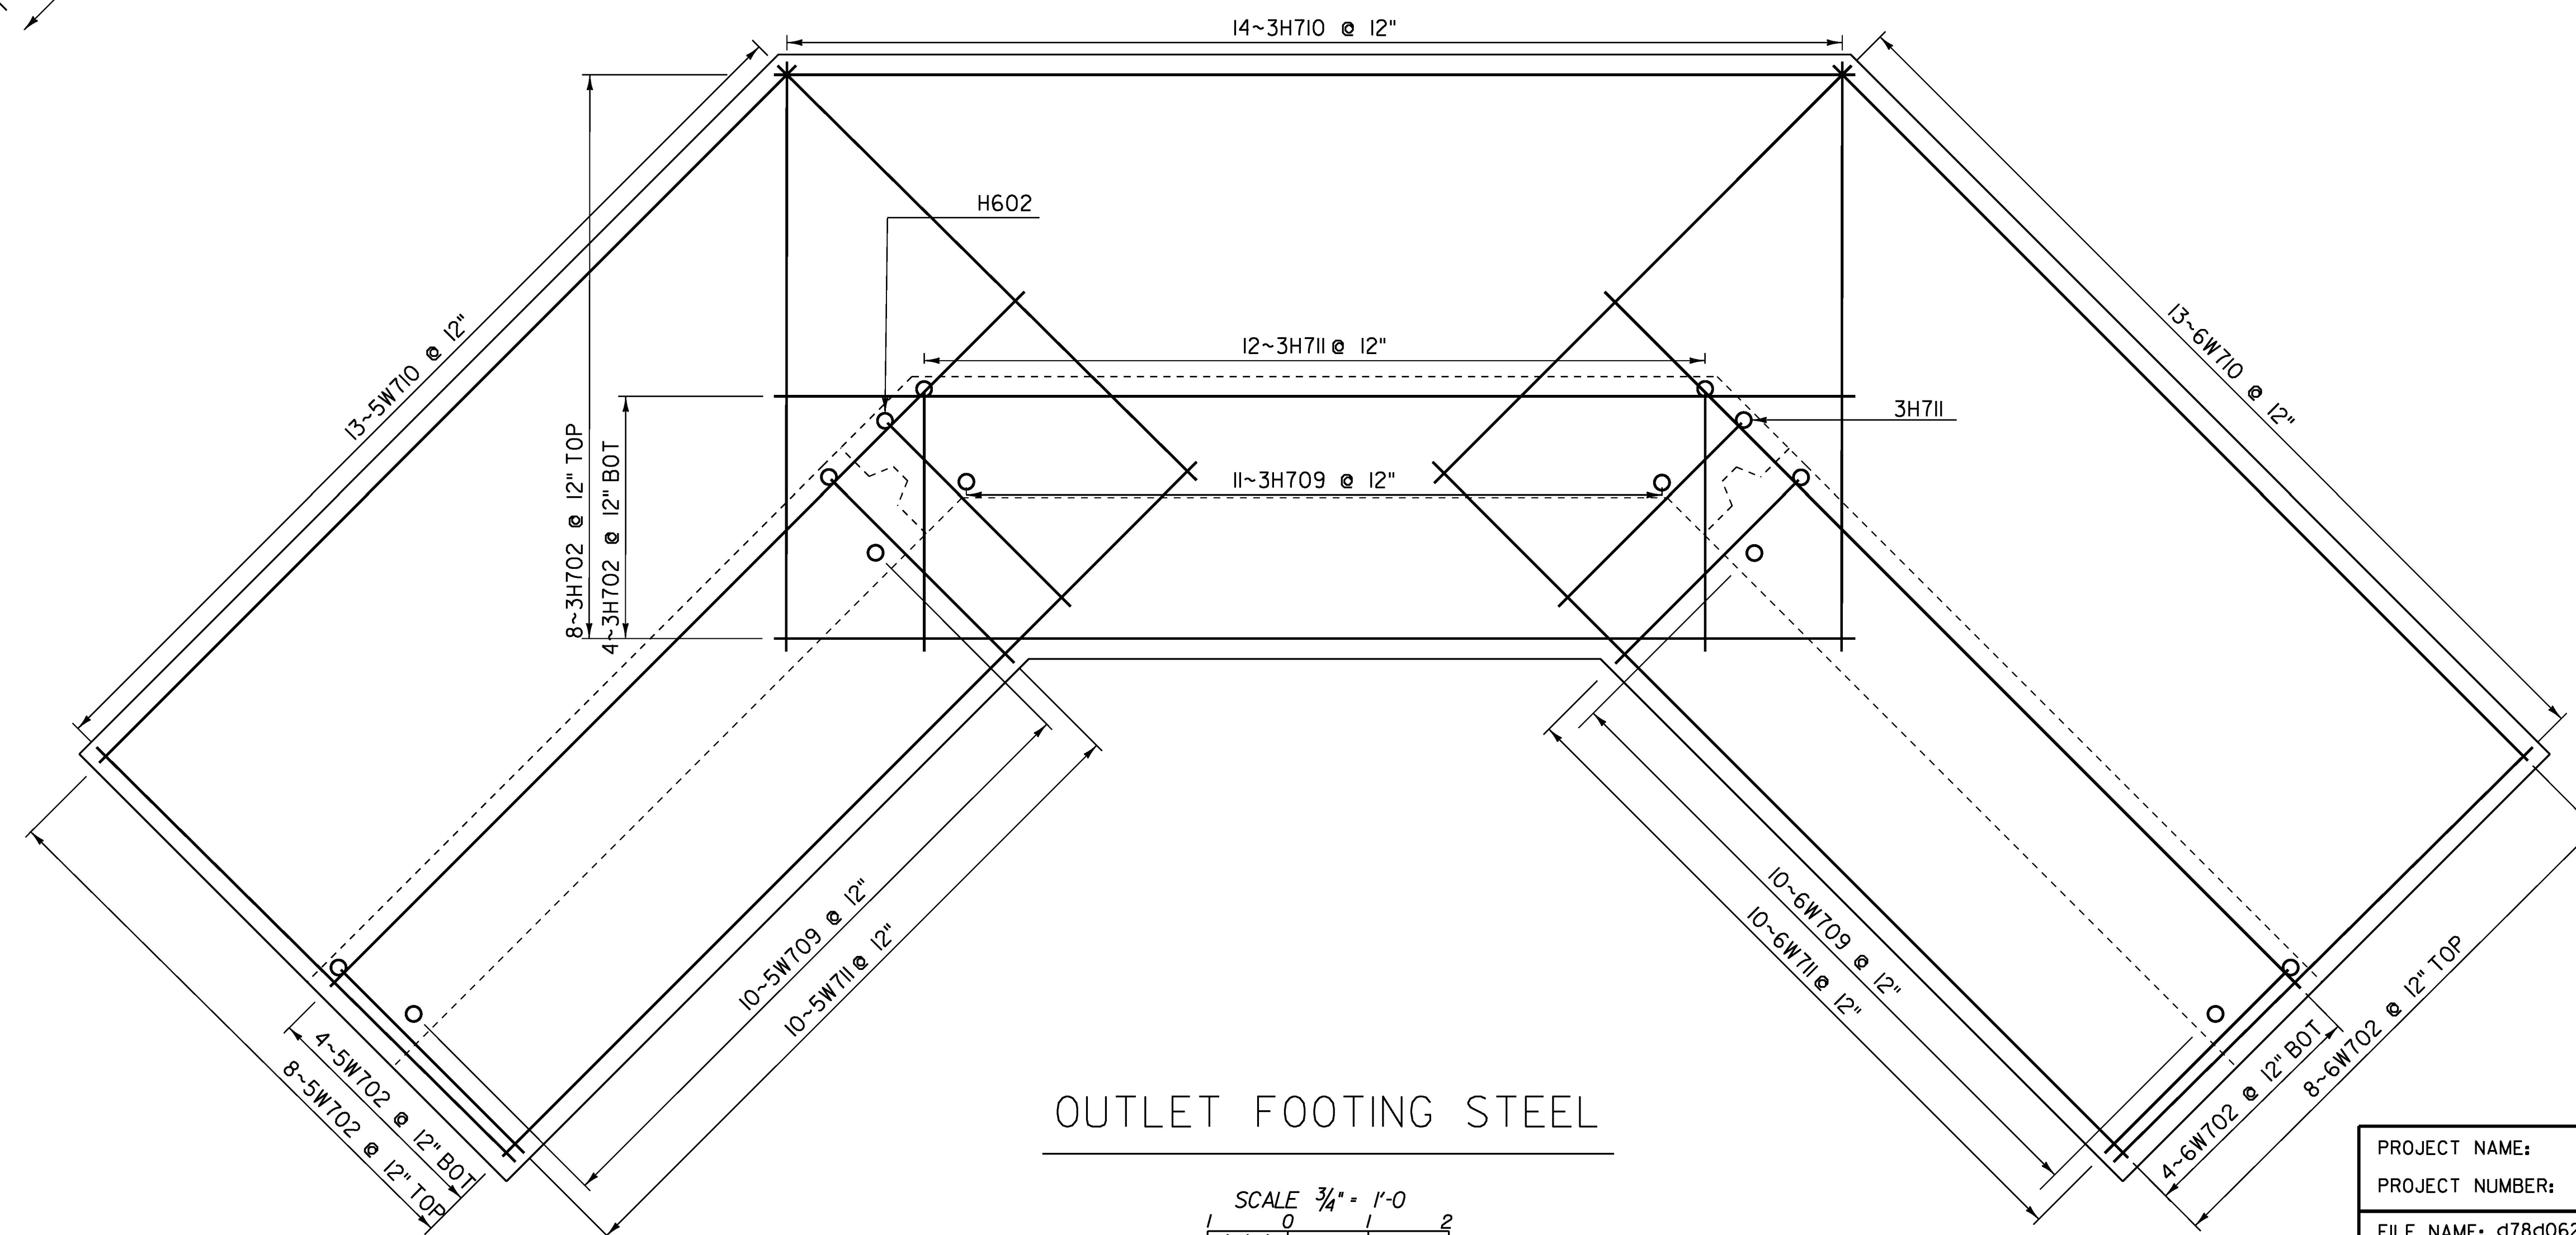

OUTLET FOOTING STEEL

SCALE 3/4" = 1'-0"
 0 1 2

NOTE:

- NF = NEAR FACE
- FF = FAR FACE
- EF = EACH FACE
- ▲ = CUT TO FIT IN FIELD
- 3" CLR. UNLESS OTHERWISE SPECIFIED ON THE PLANS.

PROJECT NAME:	CHARLOTTE
PROJECT NUMBER:	F EGC 019-4(20)
FILE NAME:	d78d062.typ.dgn
PROJECT LEADER:	K. UPMAL
DESIGNED BY:	A. KEMPTON
STA 93+58 OUTLET FOOTING DETAILS SHEET	SHEET 265 OF 499
PLOT DATE:	15-MAR-2016
DRAWN BY:	M. BOOKER
CHECKED BY:	C. LEACH