

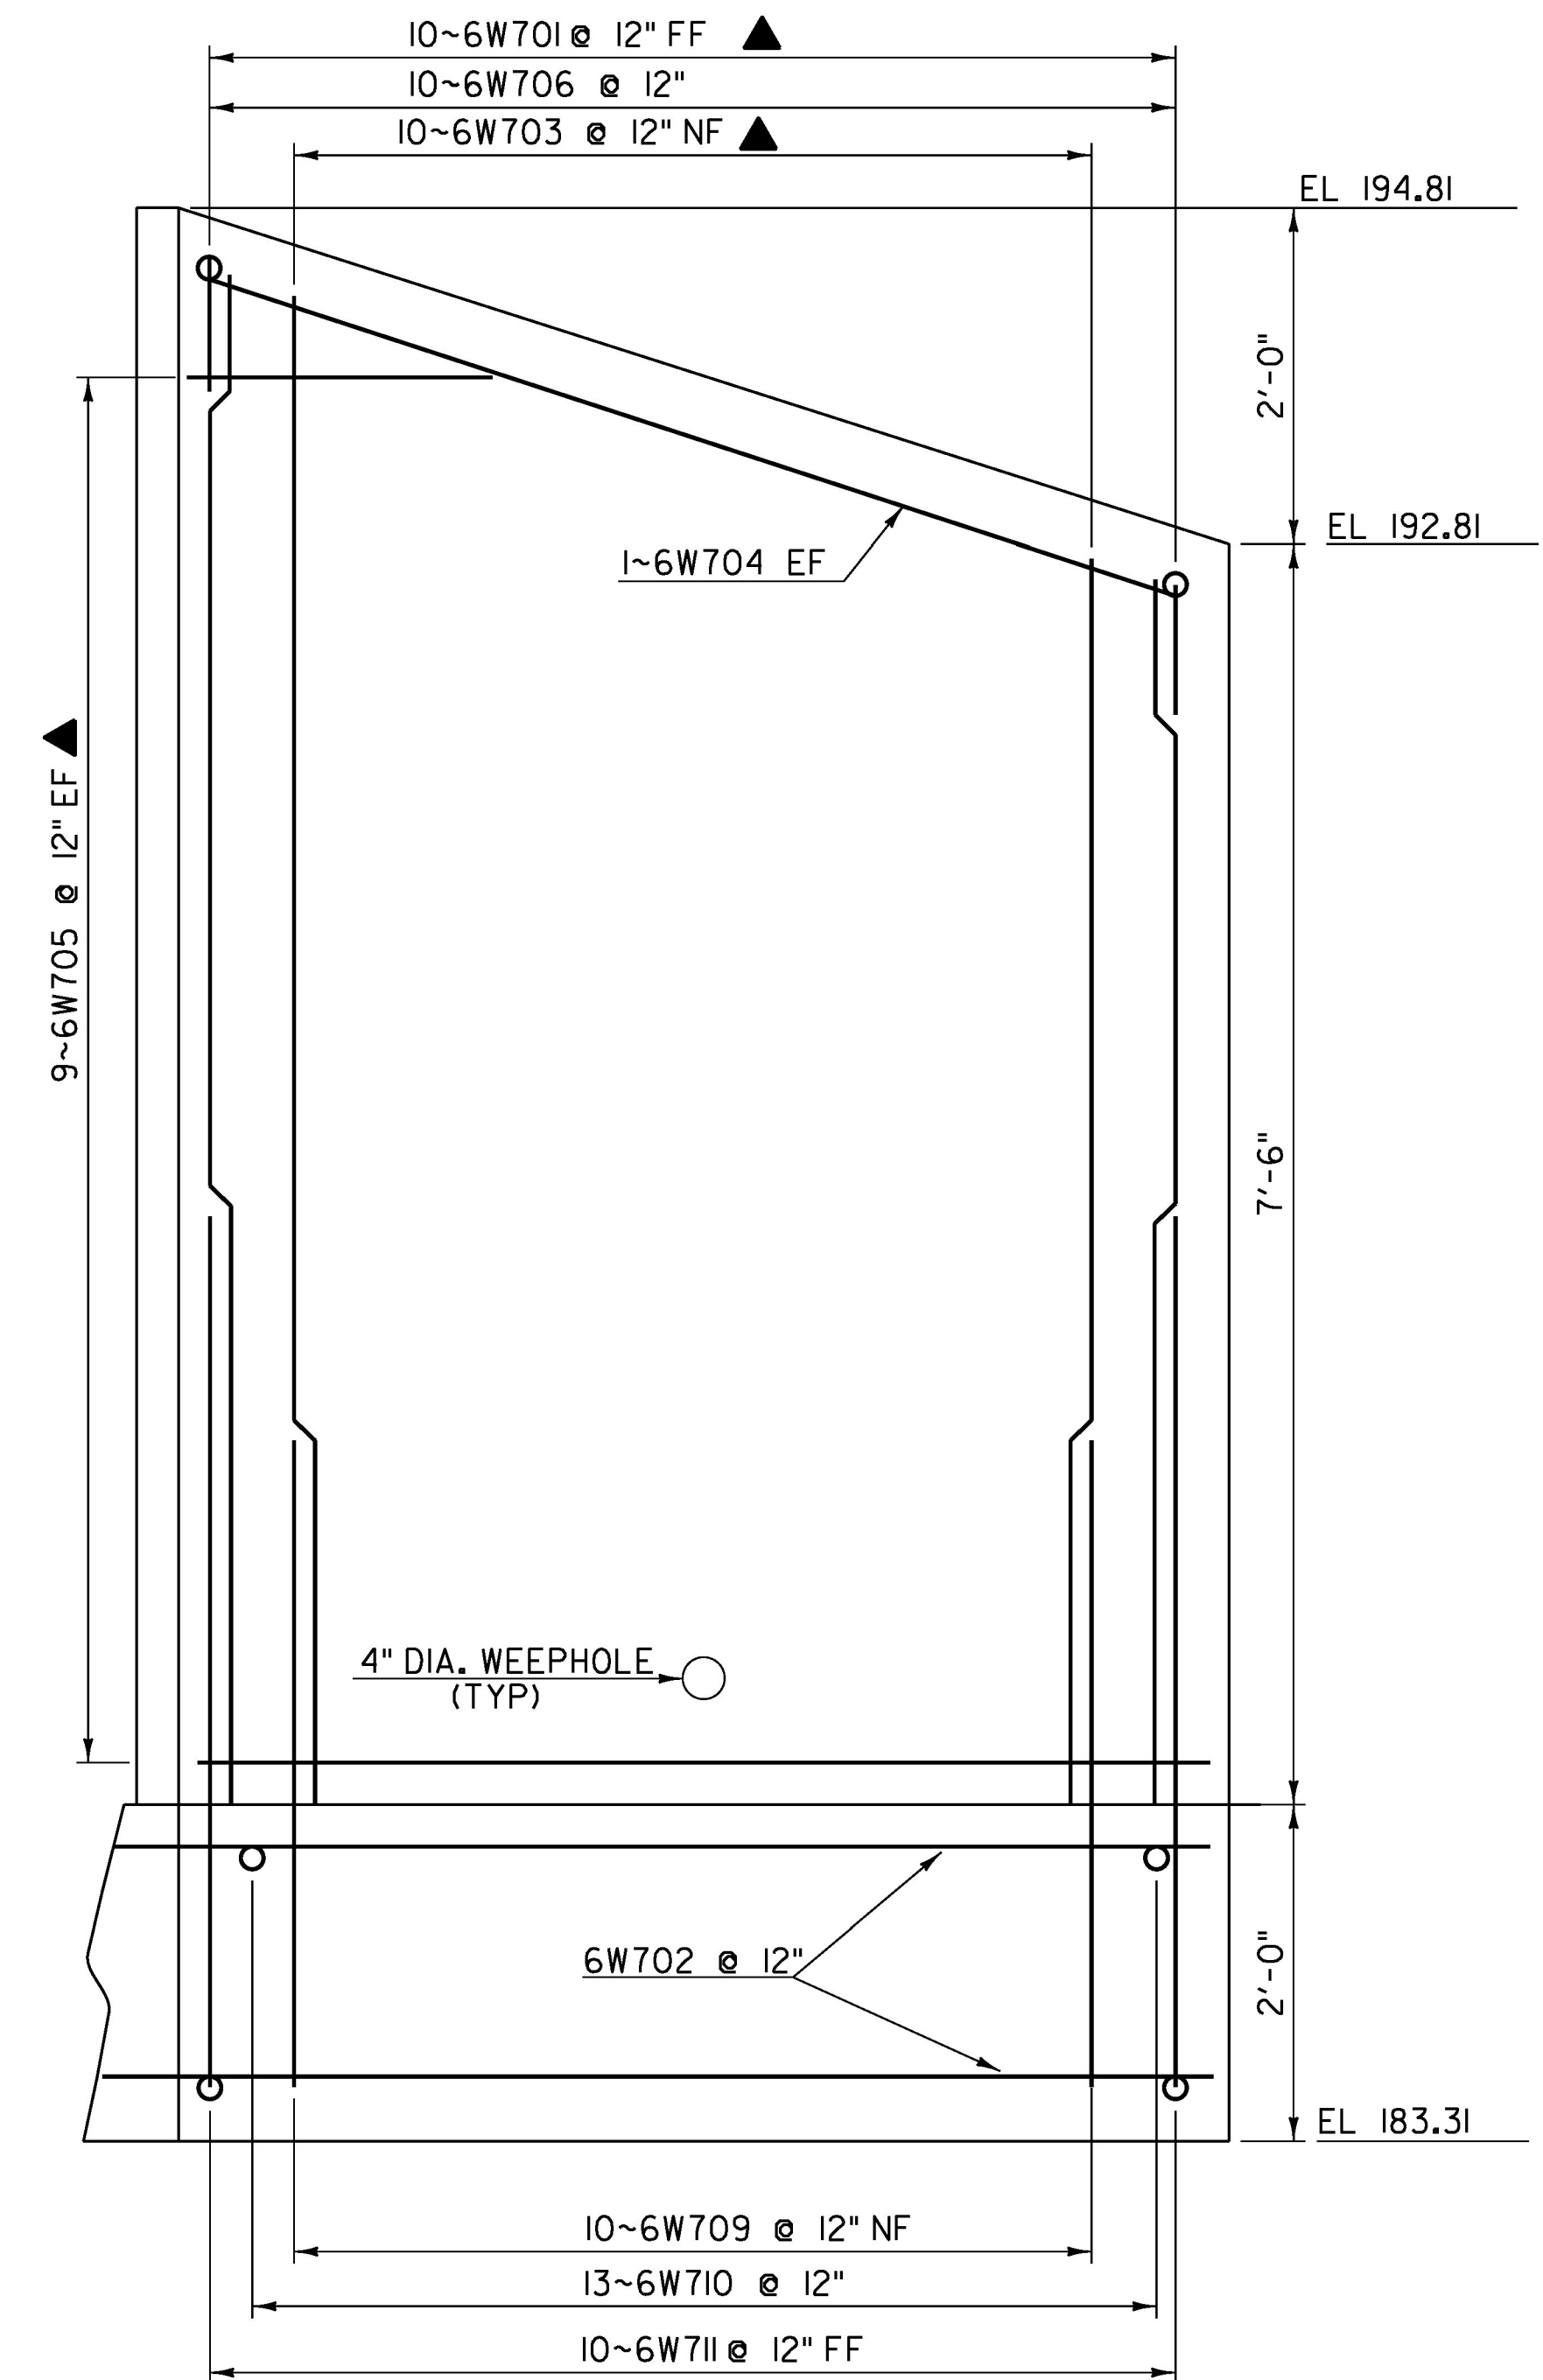
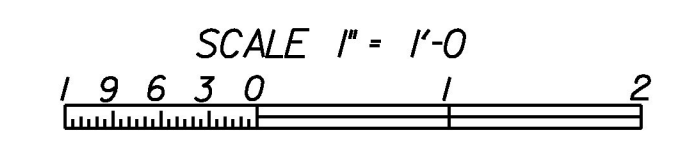



WINGWALL #1

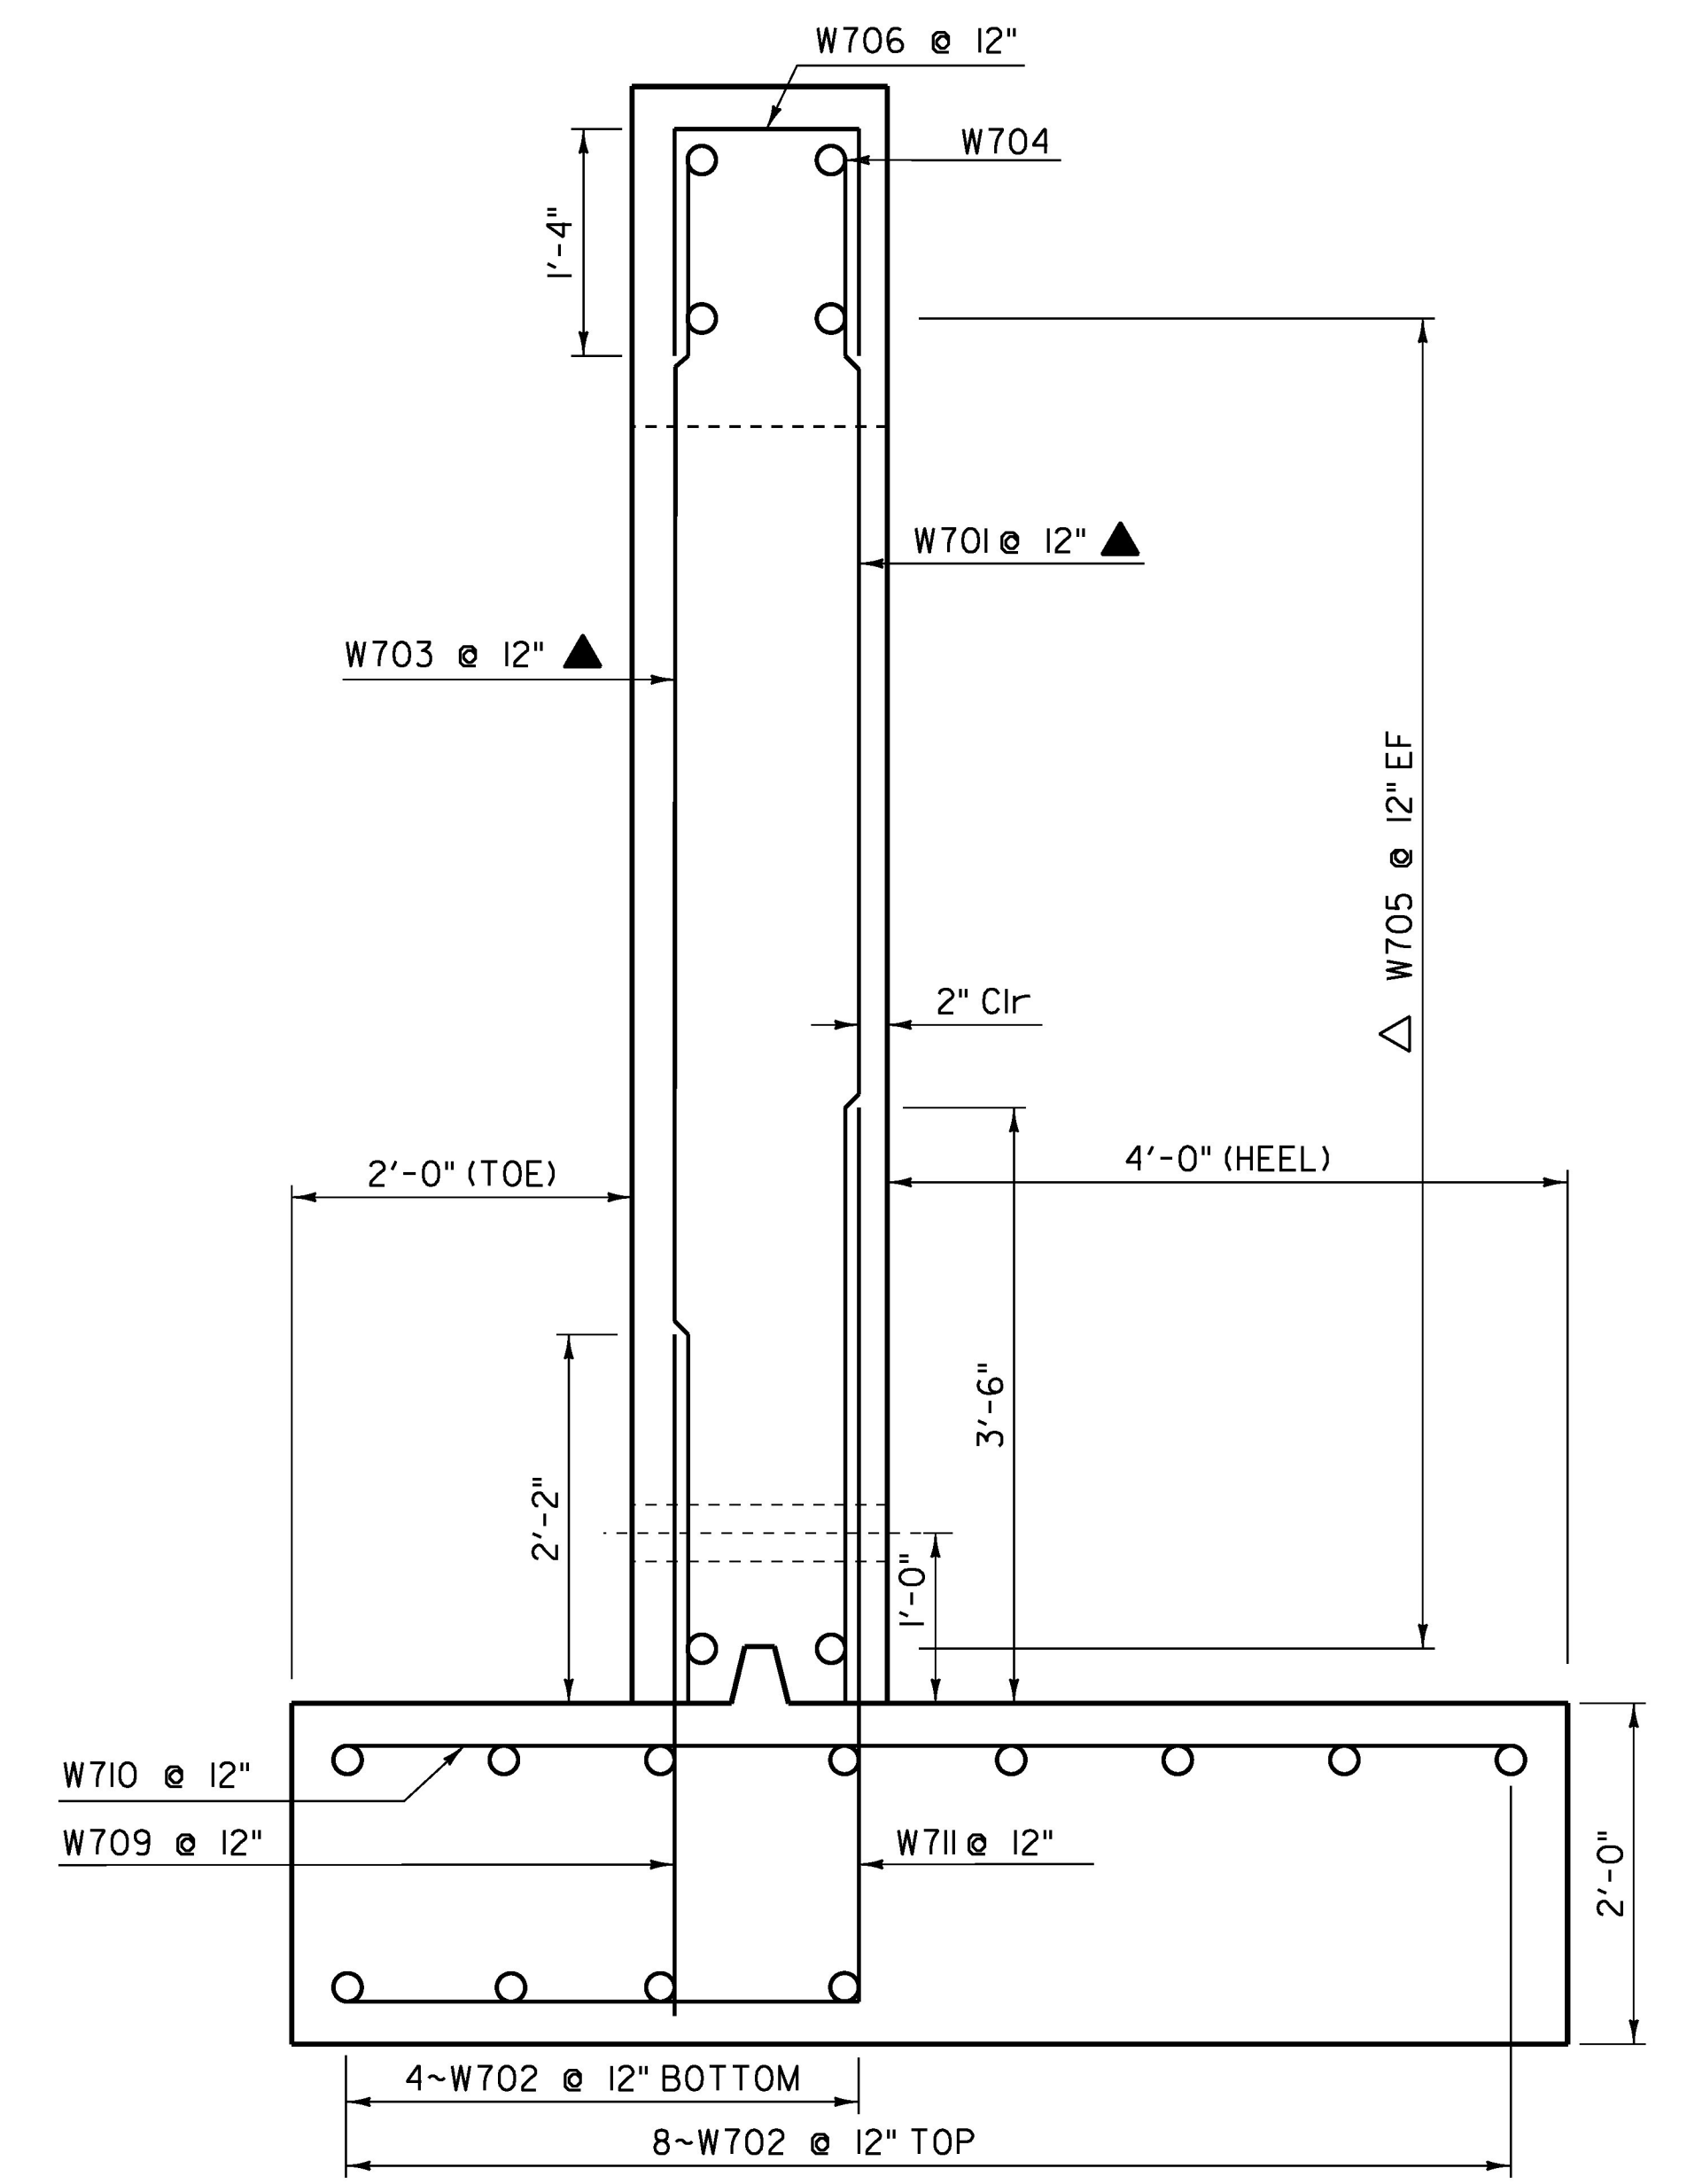

WINGWALL #2

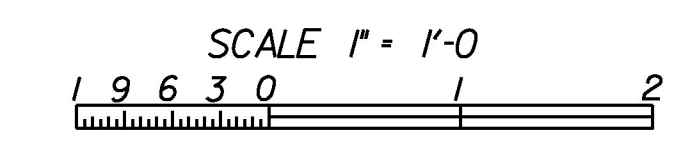

TYPICAL WINGWALL SECTION

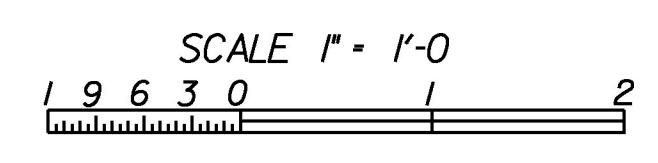

NOTE:
 NF = NEAR FACE
 FF = FAR FACE
 EF = EACH FACE
 ▲ = CUT TO FIT IN FIELD
 3" CLR. UNLESS OTHERWISE SPECIFIED ON THE PLANS.

| | |
|--|-----------------|
| PROJECT NAME: | CHARLOTTE |
| PROJECT NUMBER: | F EGC 019-4(20) |
| FILE NAME: | d78d062_typ.dgn |
| PROJECT LEADER: | K. UPMAL |
| DESIGNED BY: | A. KEMPTON |
| STA 93+58 OUTLET WINGWALL DETAILS SHEETSHEET | 266 OF 499 |
| PLOT DATE: | 15-MAR-2016 |
| DRAWN BY: | M. BOOKER |
| CHECKED BY: | C. LEACH |