



INLET HEADWALL ELEVATION VIEW

SCALE 1/2" = 1'-0"

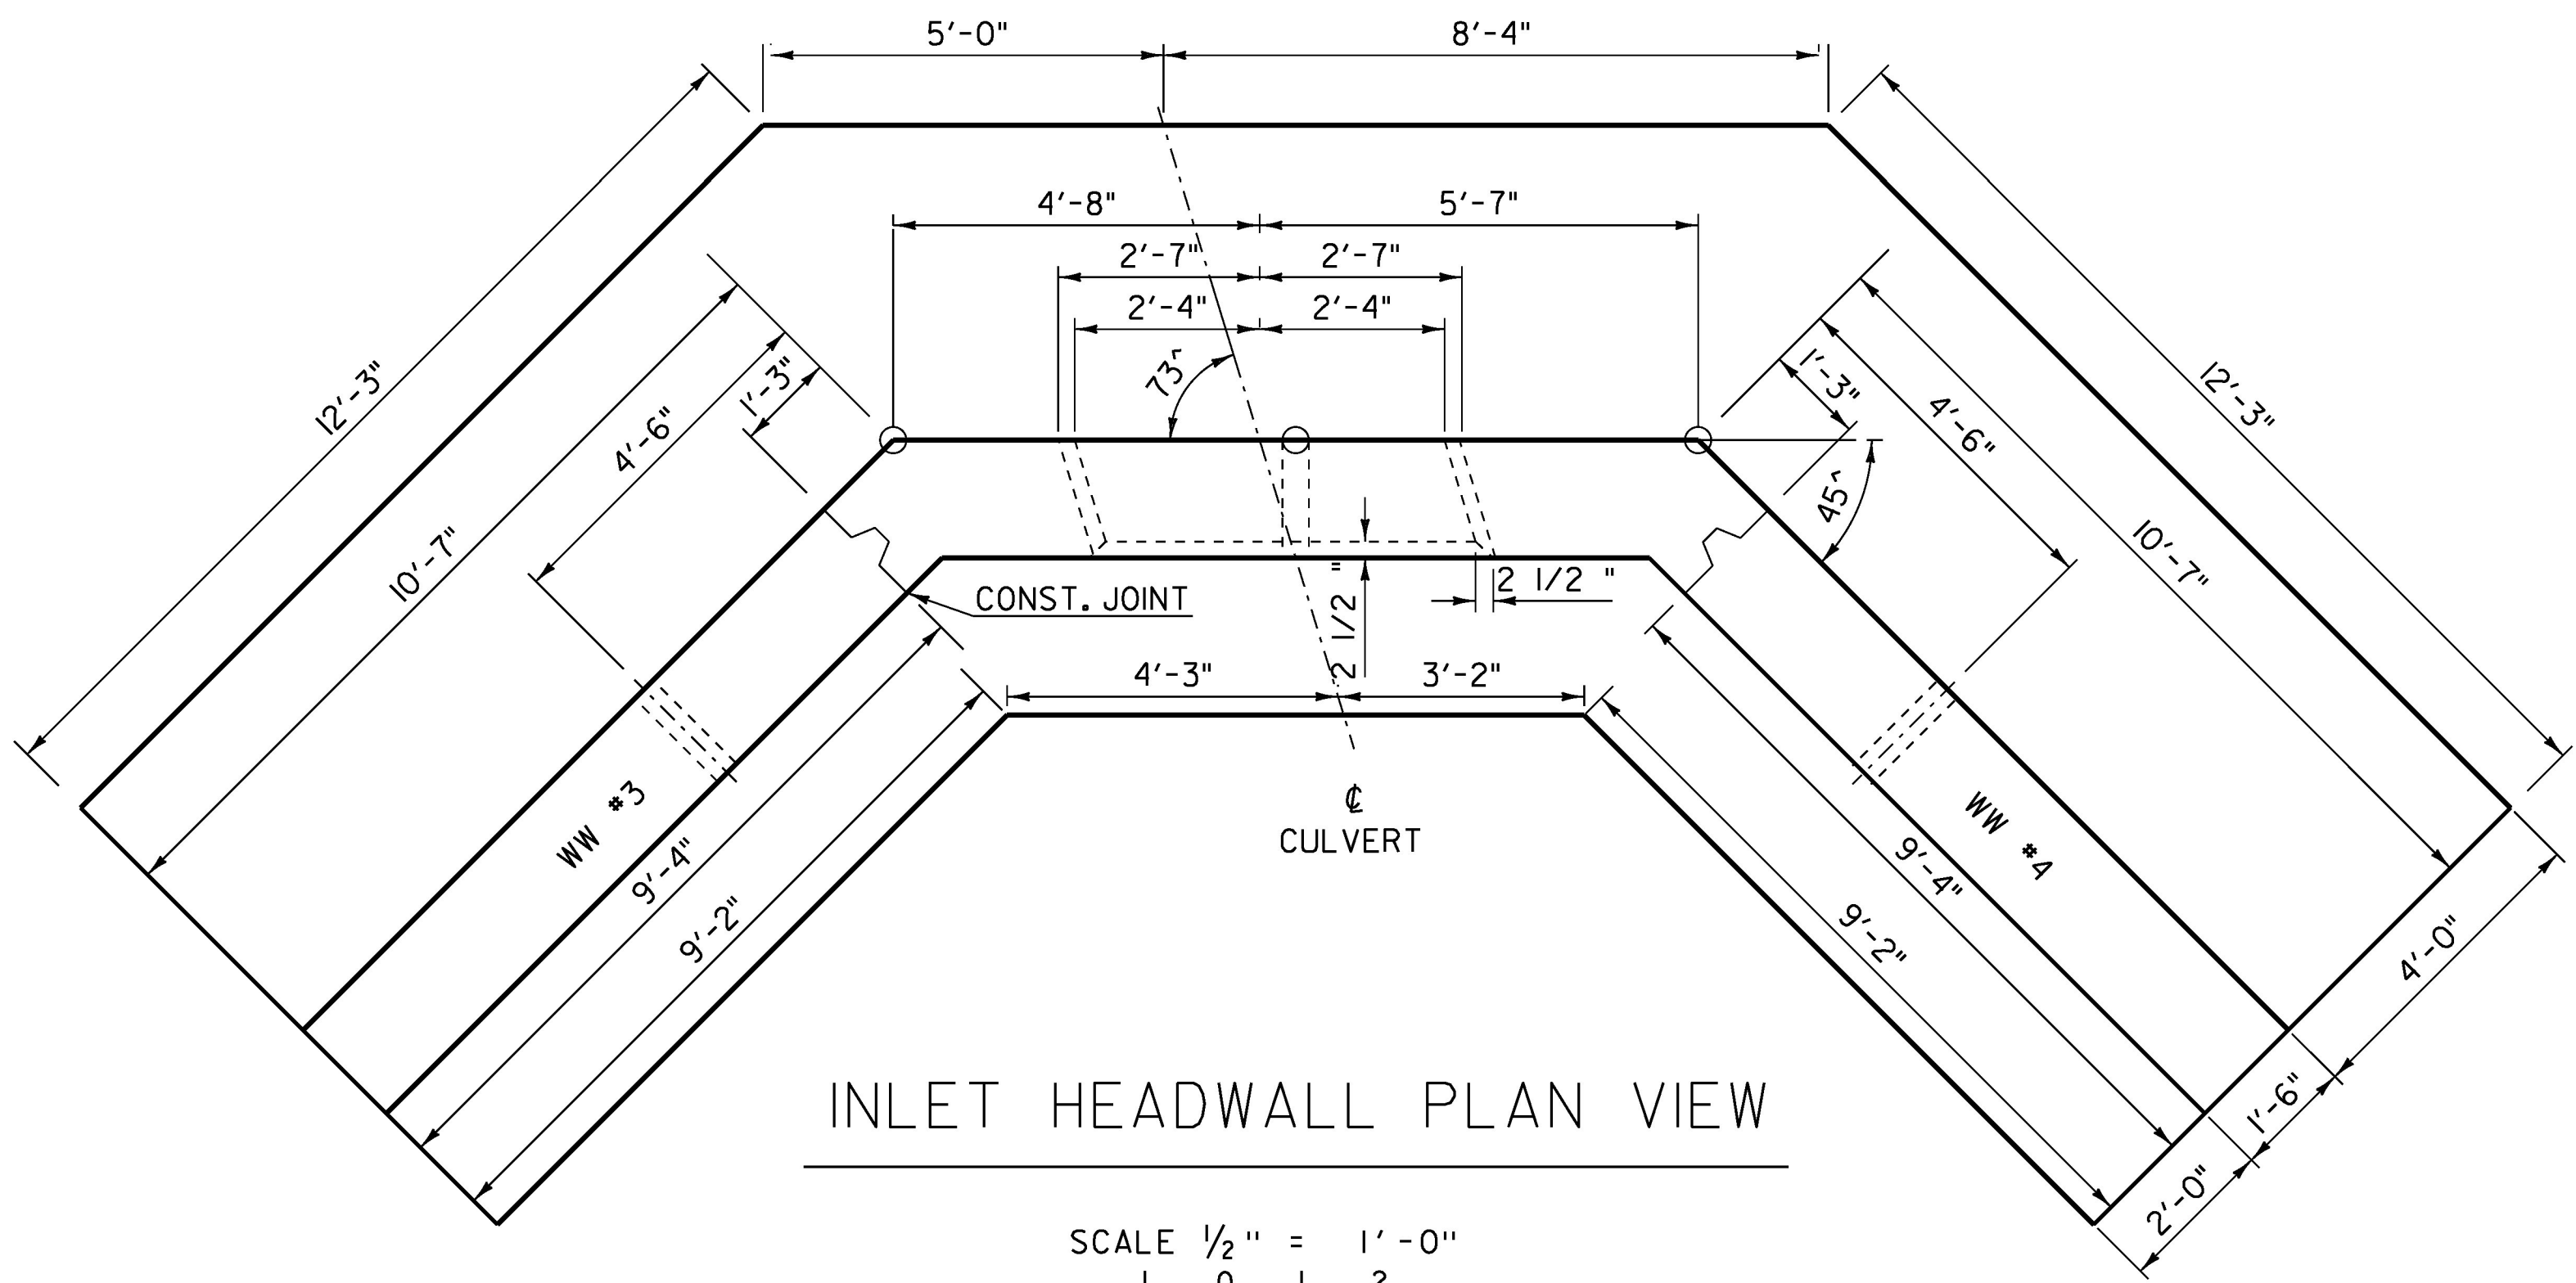

INLET HEADWALL PLAN VIEW

SCALE 1/2" = 1'-0"

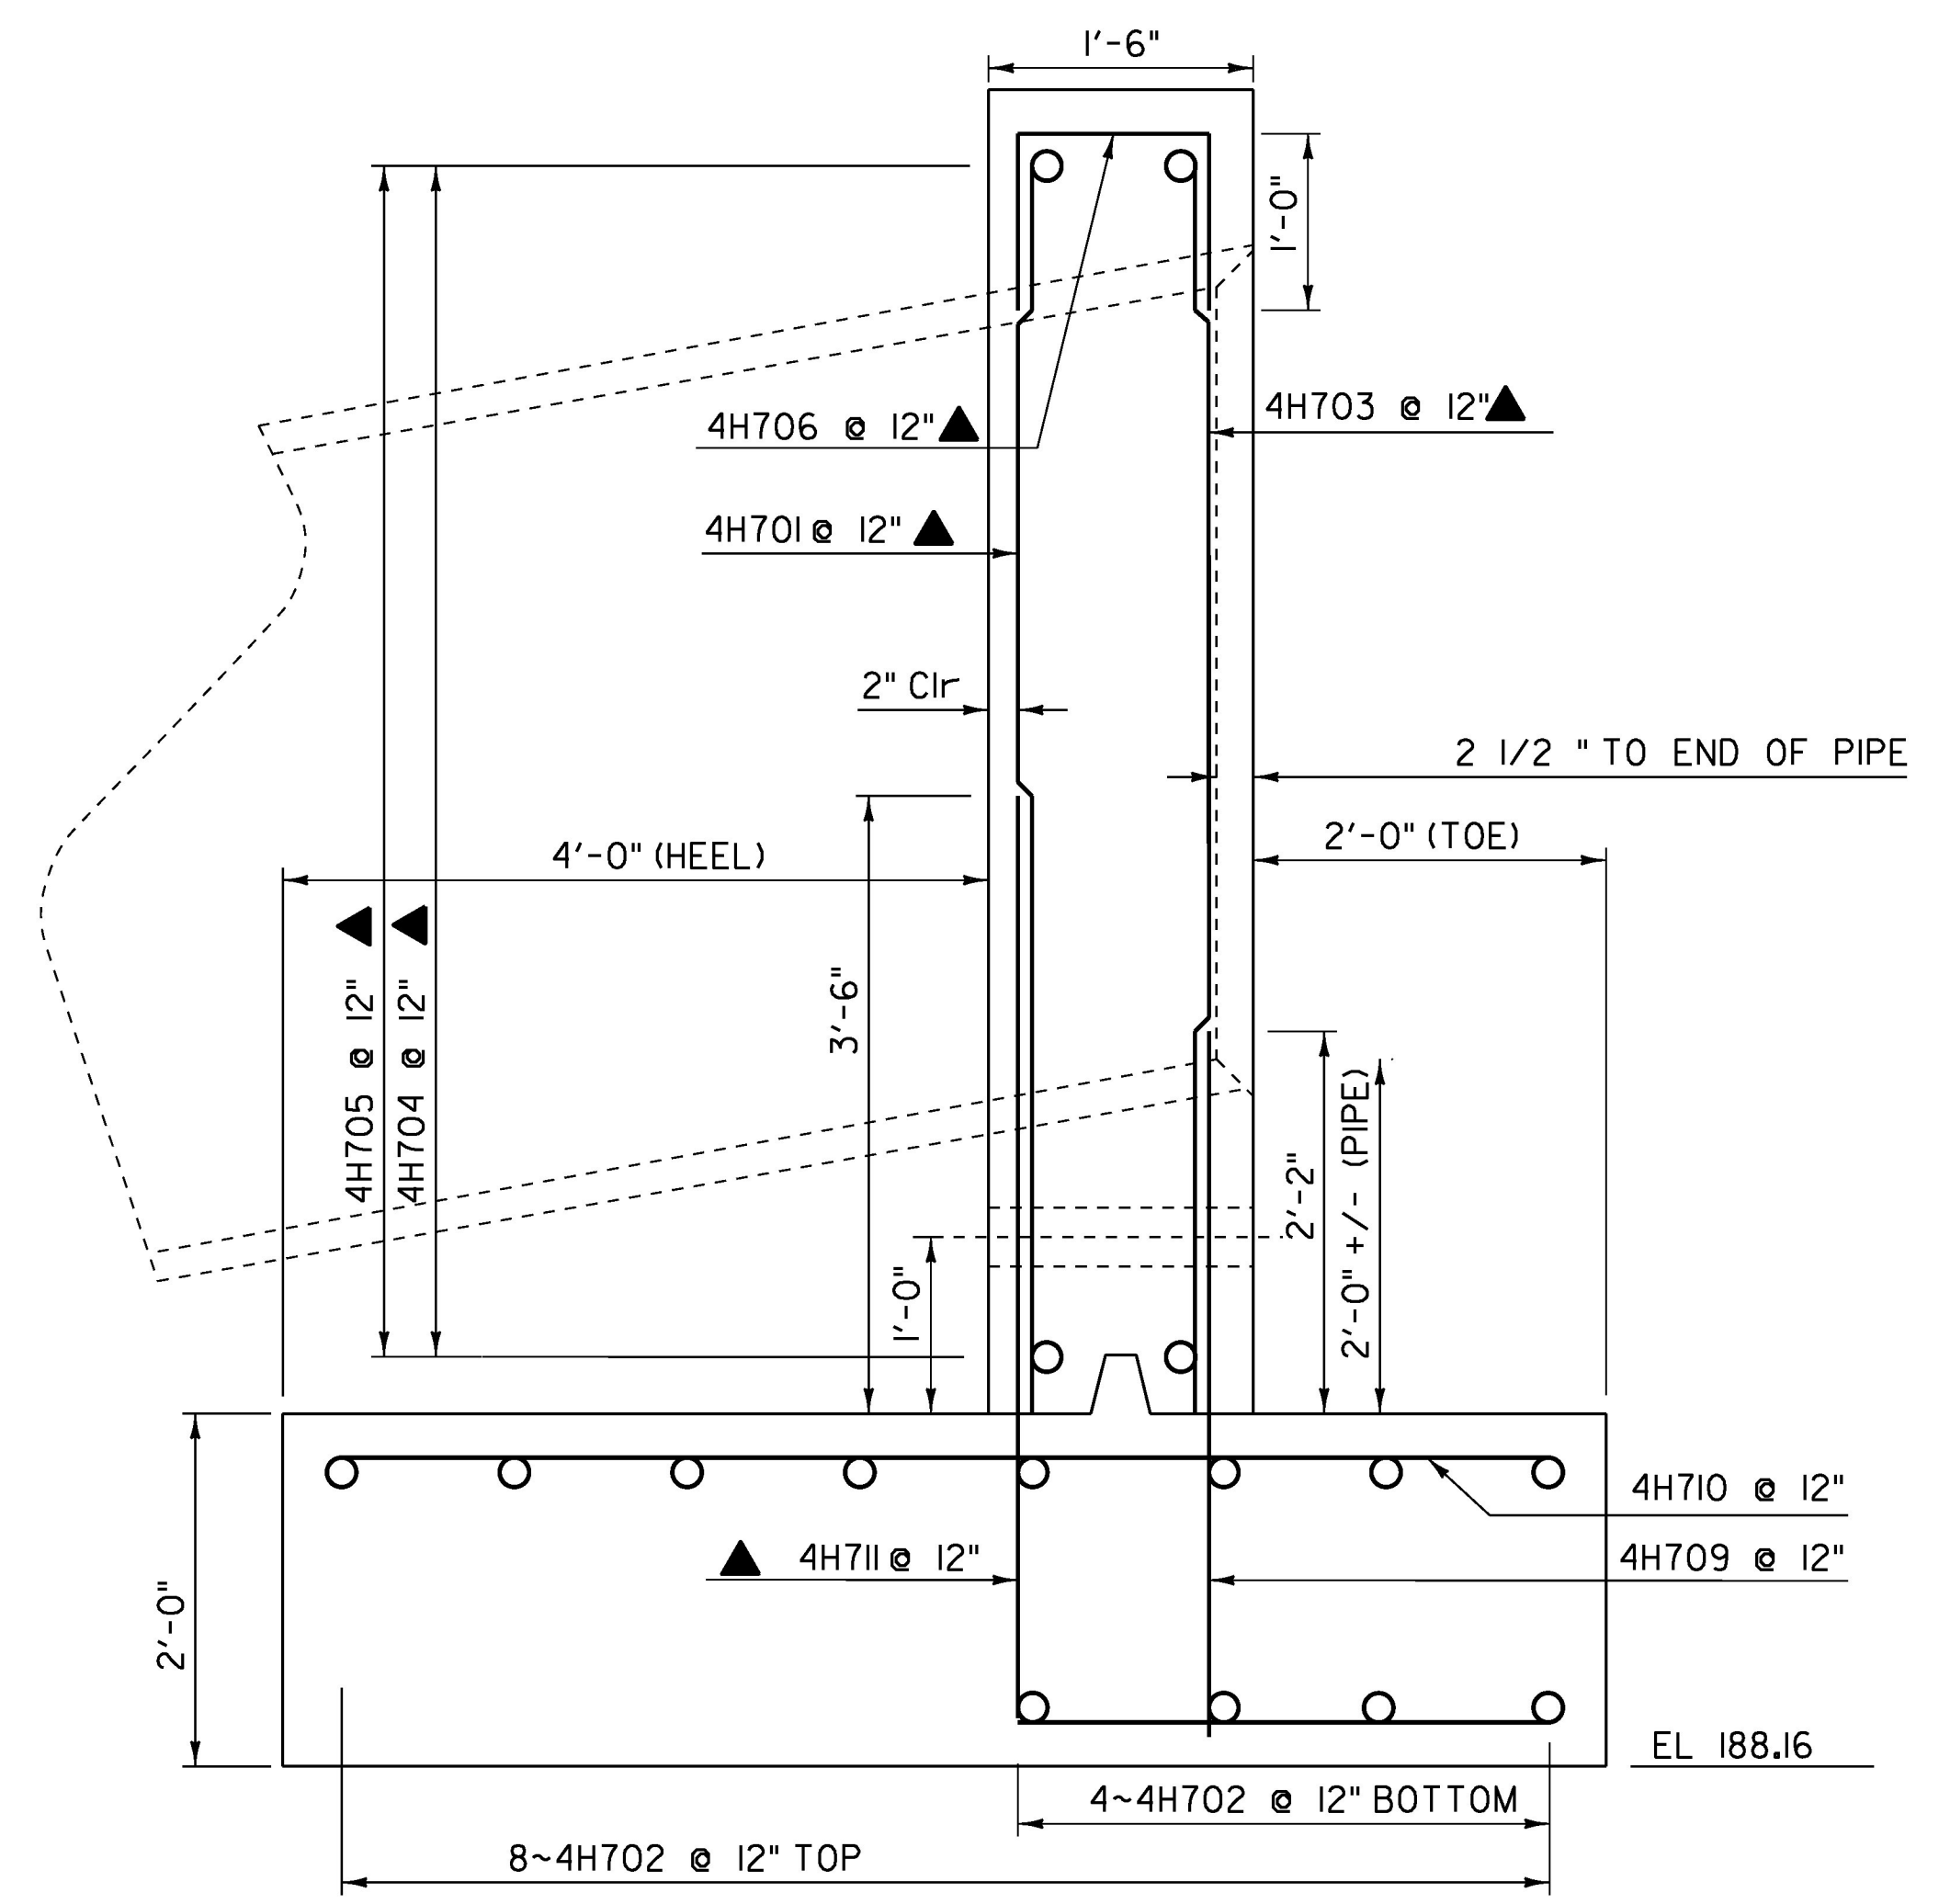

INLET HEADWALL SECTION

SCALE 1" = 1'-0"

**NOTE:**  
 NF = NEAR FACE  
 FF = FAR FACE  
 EF = EACH FACE  
 ▲ = CUT TO FIT IN FIELD  
 3" CLR. UNLESS OTHERWISE SPECIFIED ON THE PLANS.

PROJECT NAME: CHARLOTTE	PLOT DATE: 15-MAR-2016
PROJECT NUMBER: F EGC 019-4(20)	DRAWN BY: M. BOOKER
FILE NAME: d78d062.typ.dgn	DESIGNED BY: A. KEMPTON
STA 93+58 INLET HEADWALL DETAILS SHEET SHEET 267 OF 499	CHECKED BY: C. LEACH