




41+50

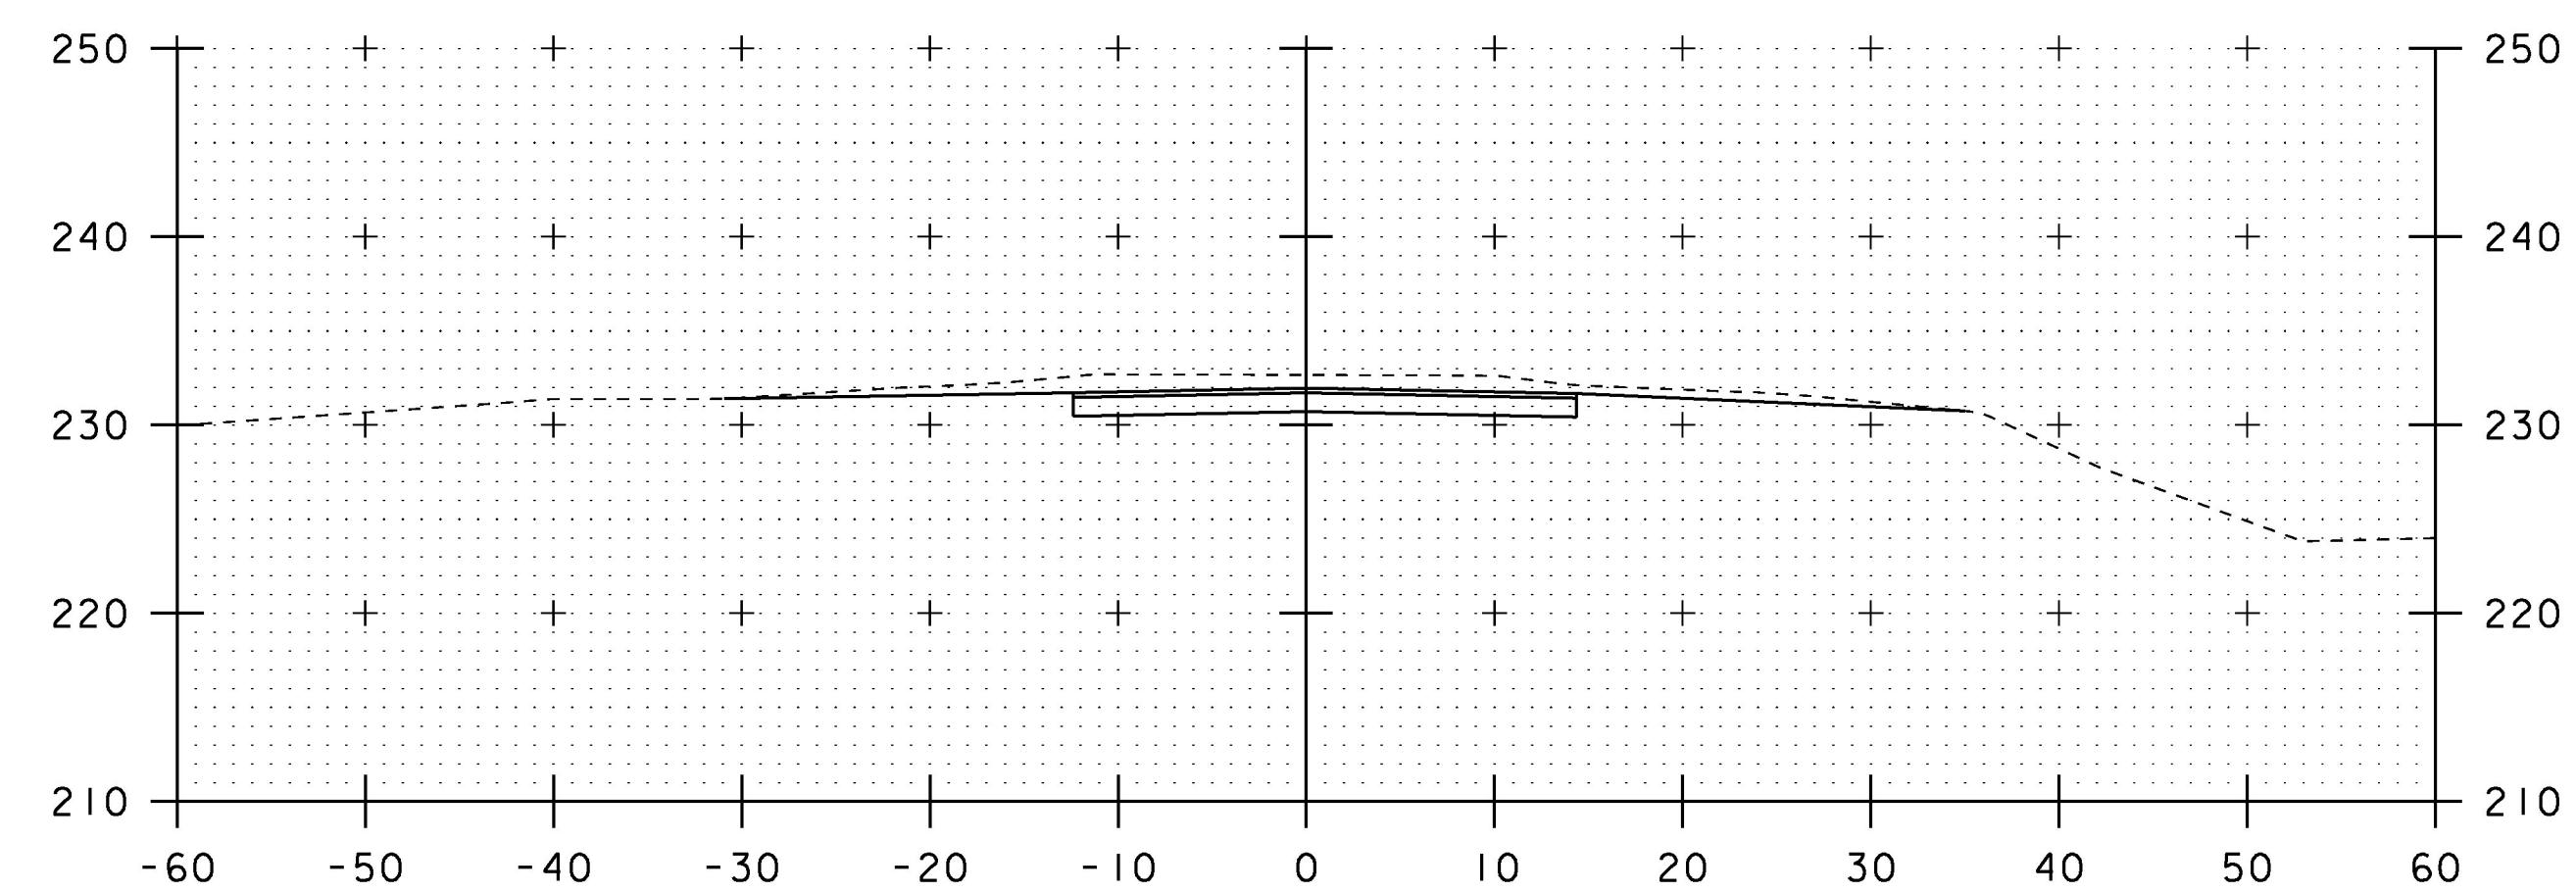

41+69 DRIVE LT SECTION A-A
(CHAFLIN FARM RD.)

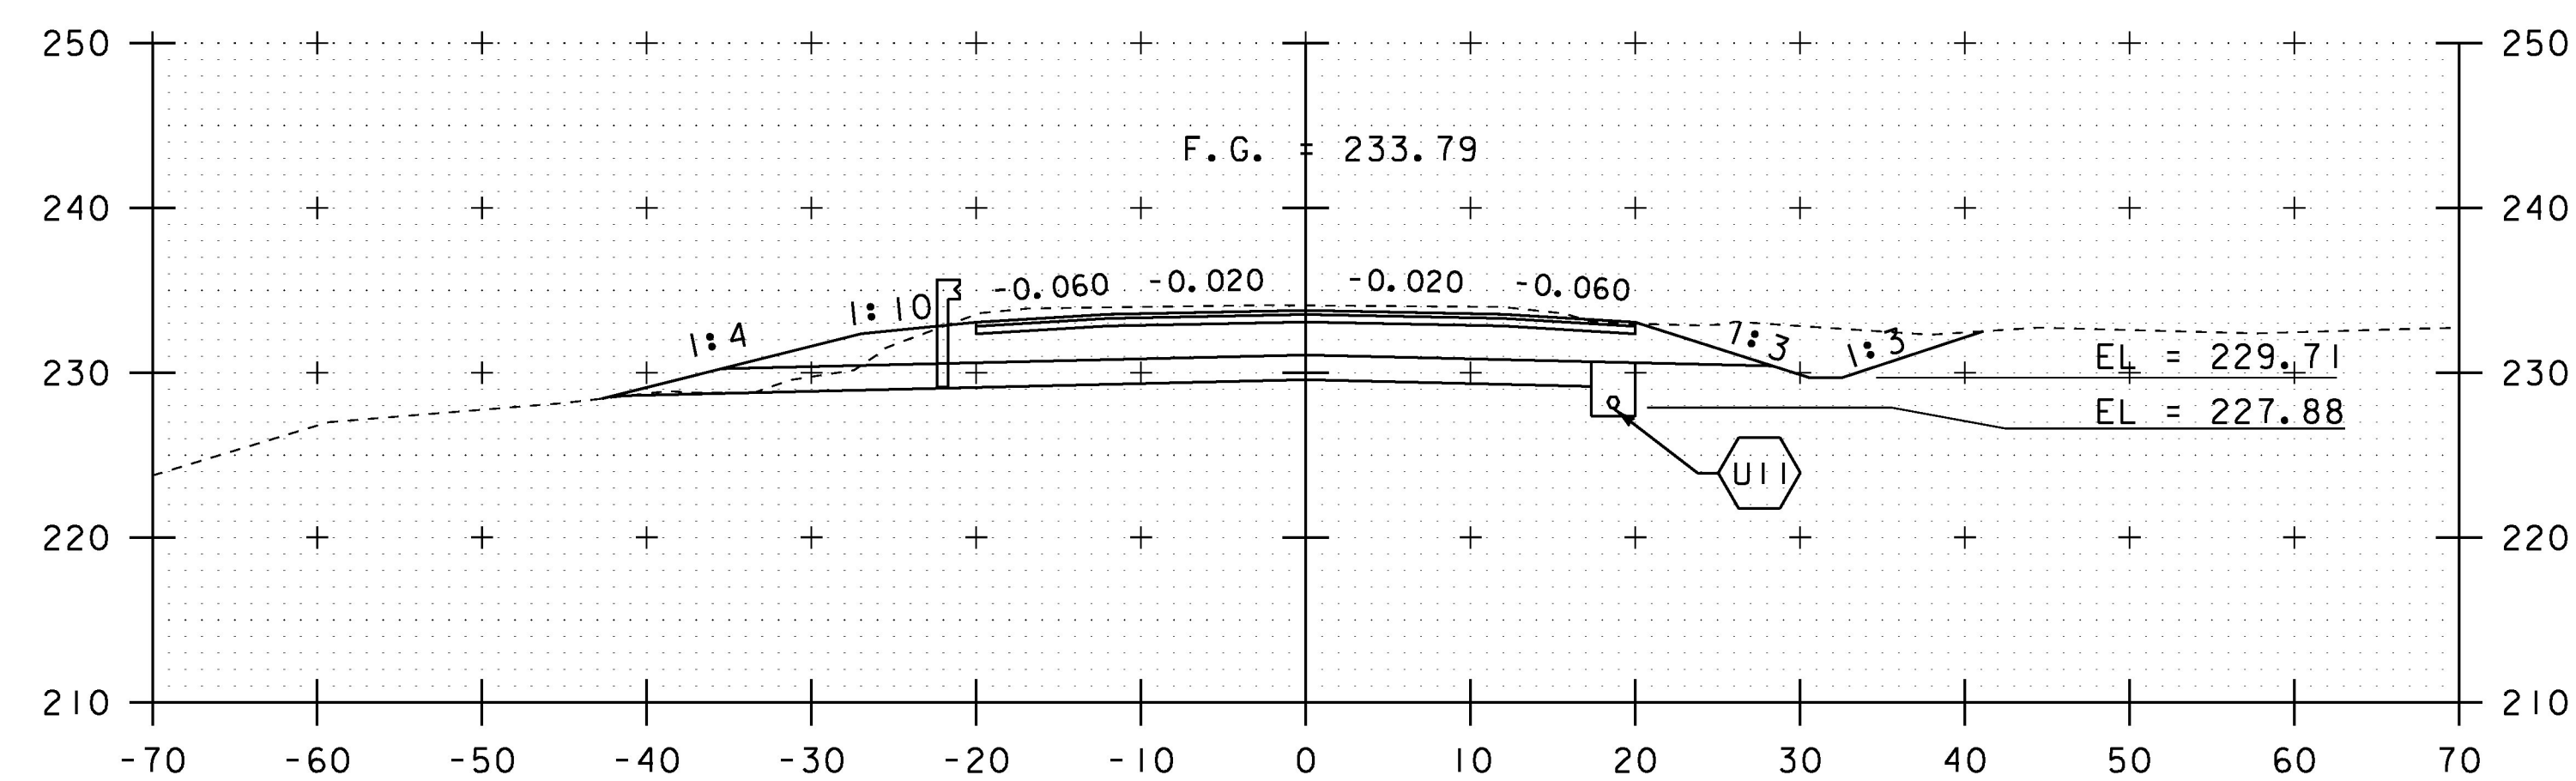

41+00

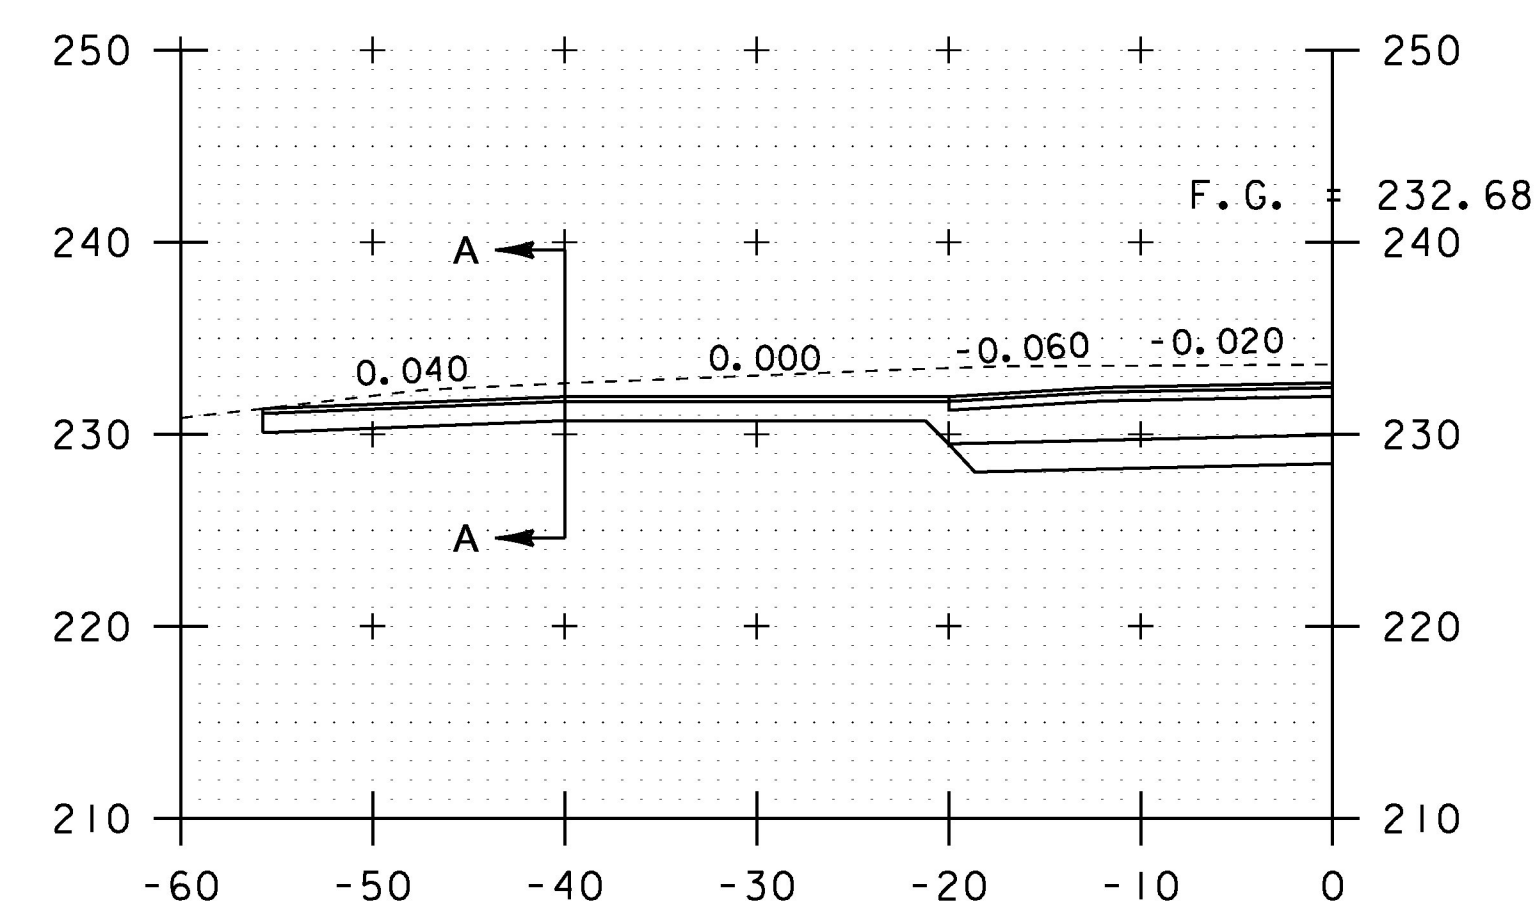

41+69 DRIVE LT
(CHAFLIN FARM RD.)

SCALE IN FEET

STA. 41+00 TO STA. 41+69

PROJECT NAME:	CHARLOTTE
PROJECT NUMBER:	F EGC 019-4(20)
FILE NAME:	d78d062_xs.dgn
PROJECT LEADER:	K. UPMAL
DESIGNED BY:	B. KIPP
MAINLINE CROSS SECTIONS 18	
PLOT DATE:	15-MAR-2016
DRAWN BY:	B. KIPP
CHECKED BY:	C. LEACH
SHEET	295 OF 499