




61+50

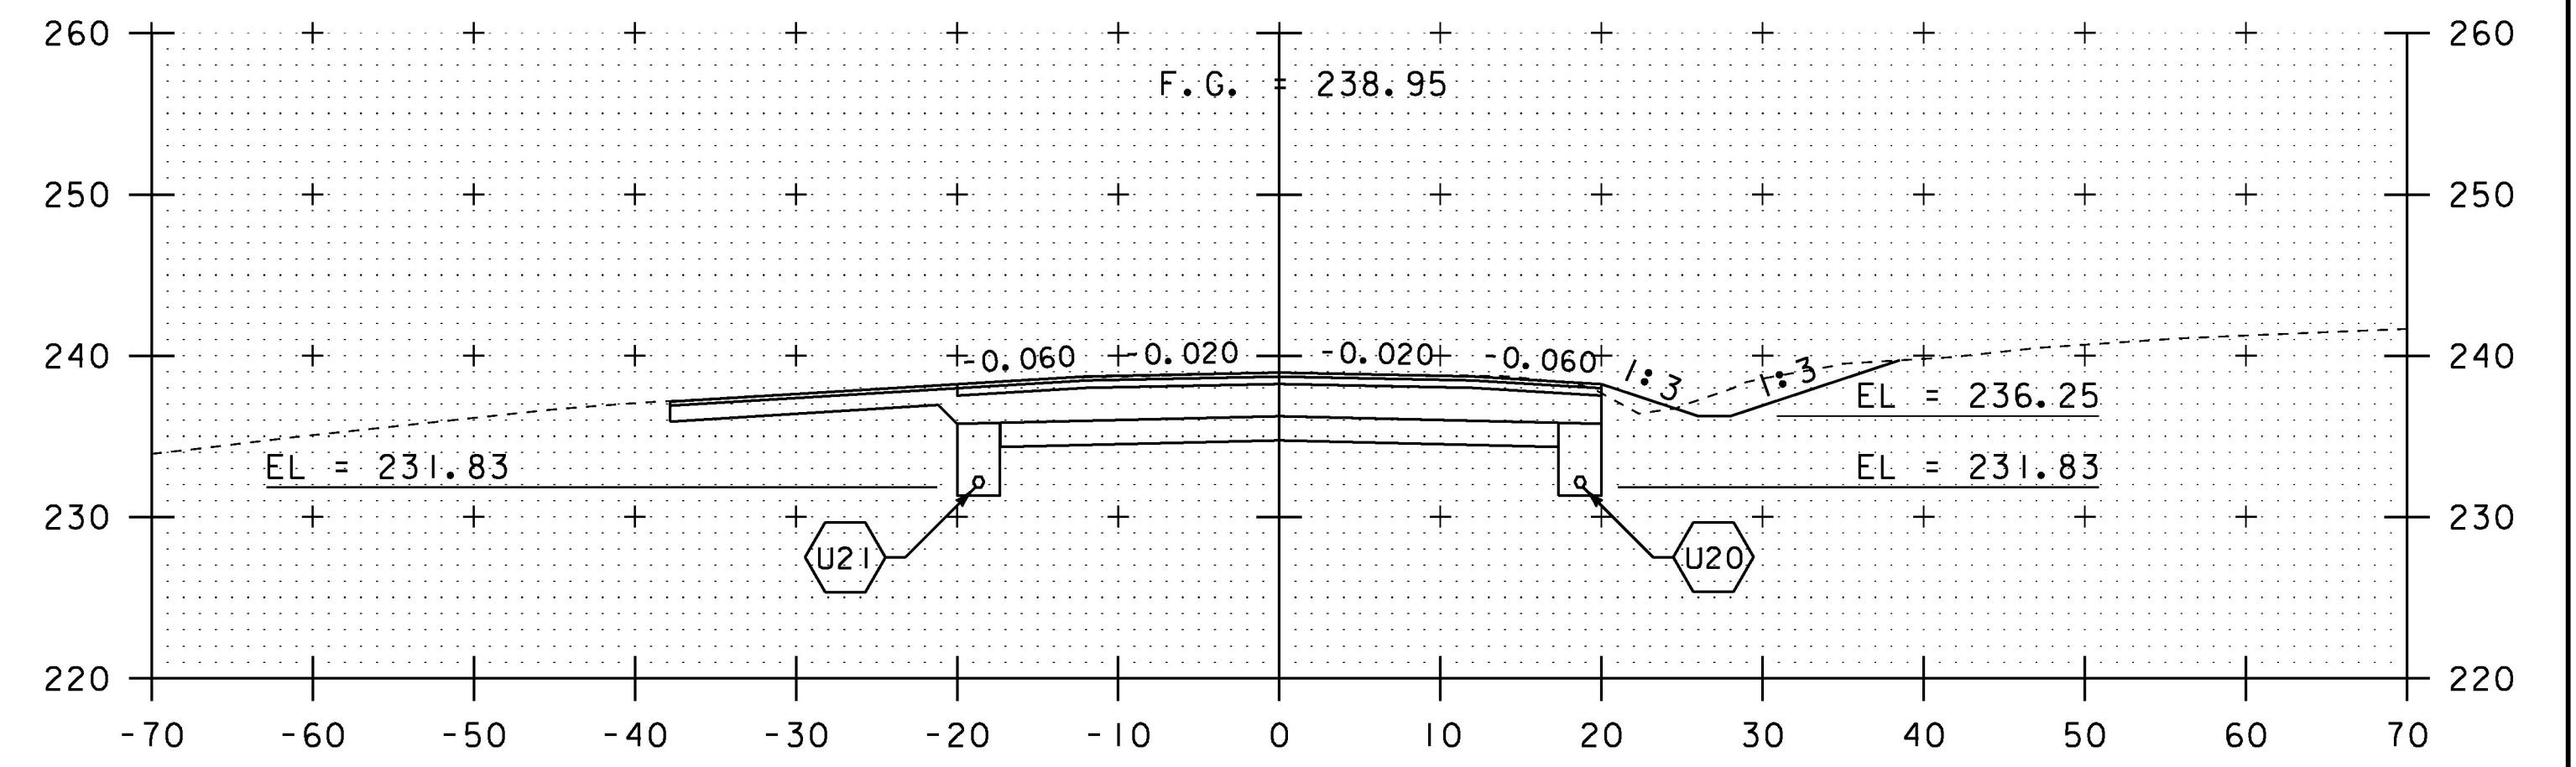


63+00

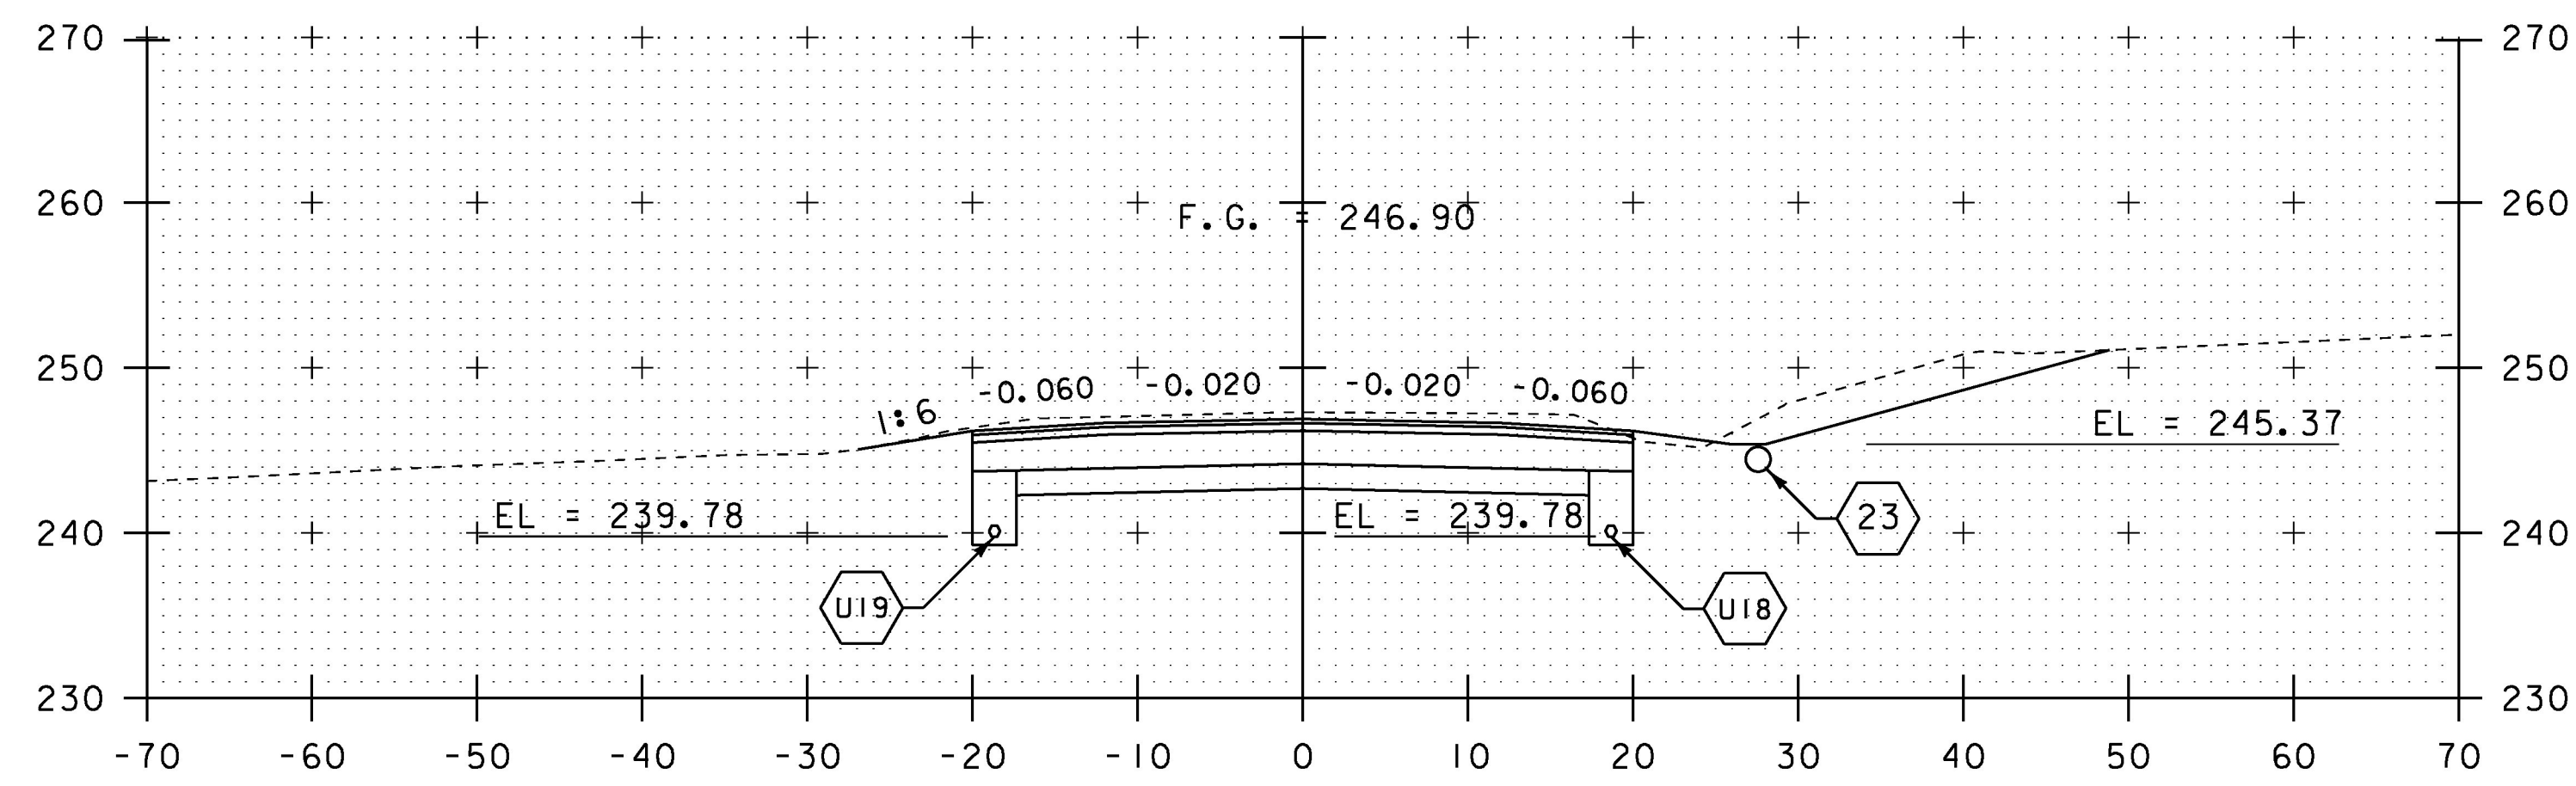


61+00

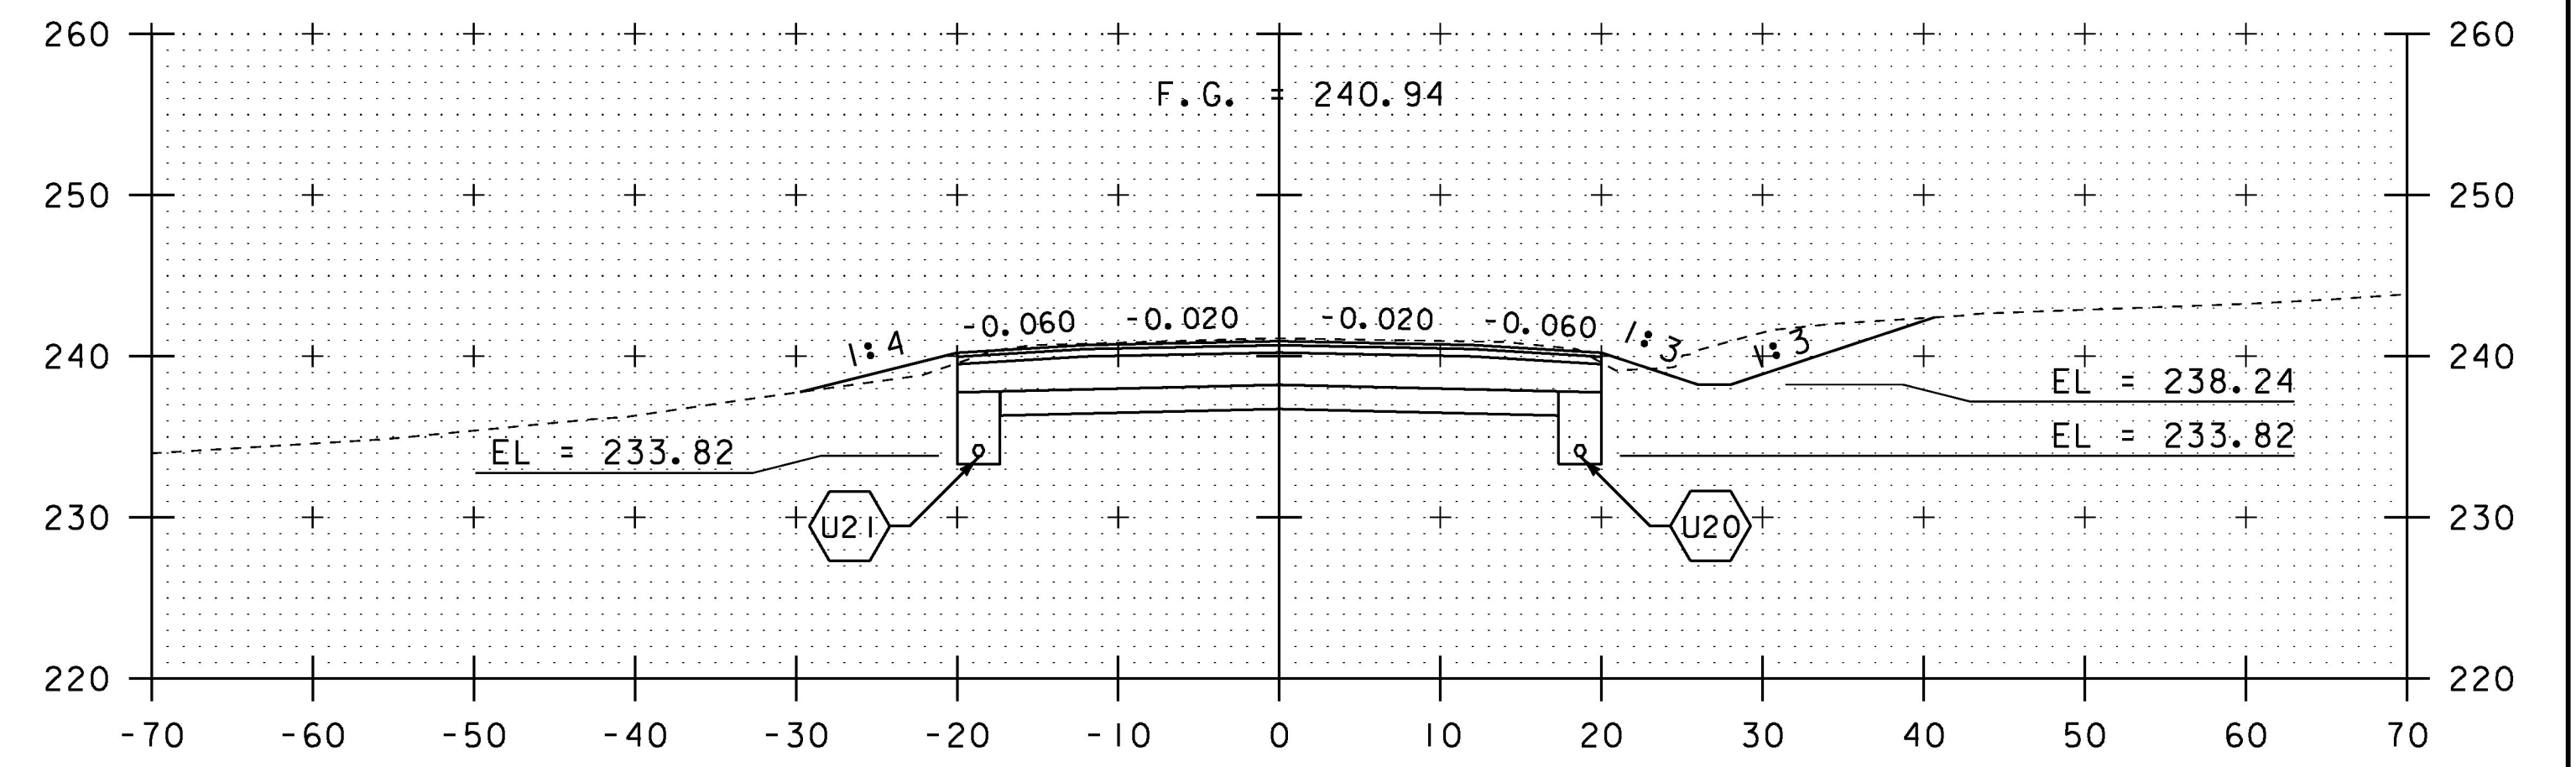

62+50

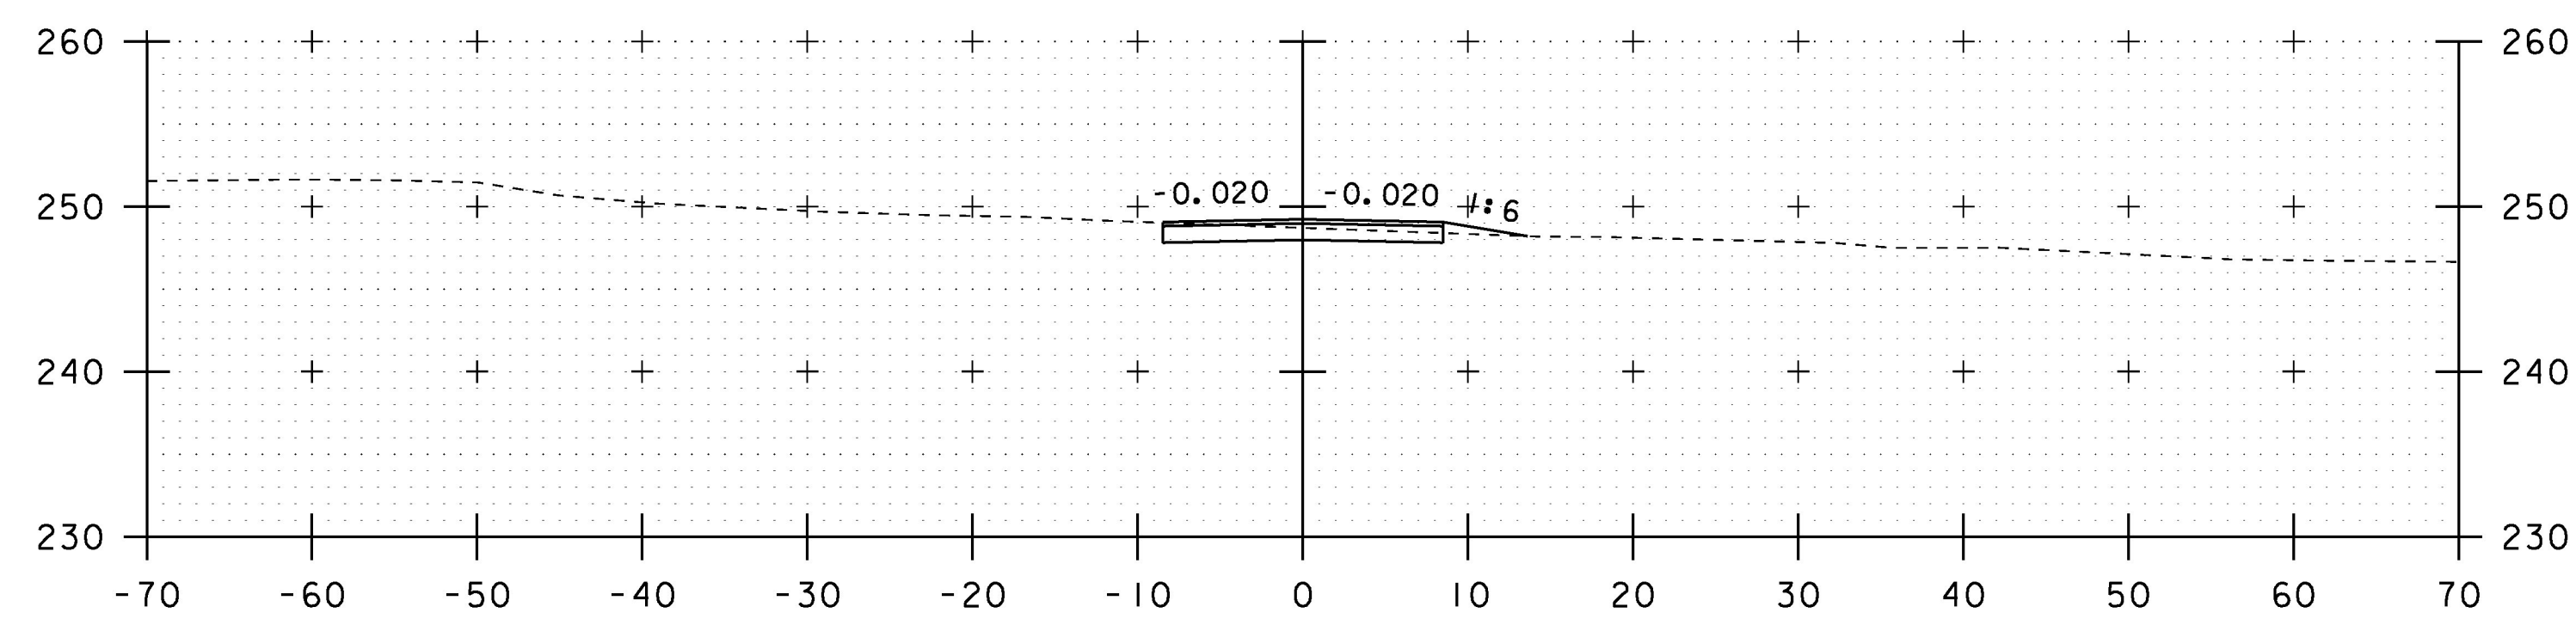

60+16 DRIVE LT
SECTION A-A

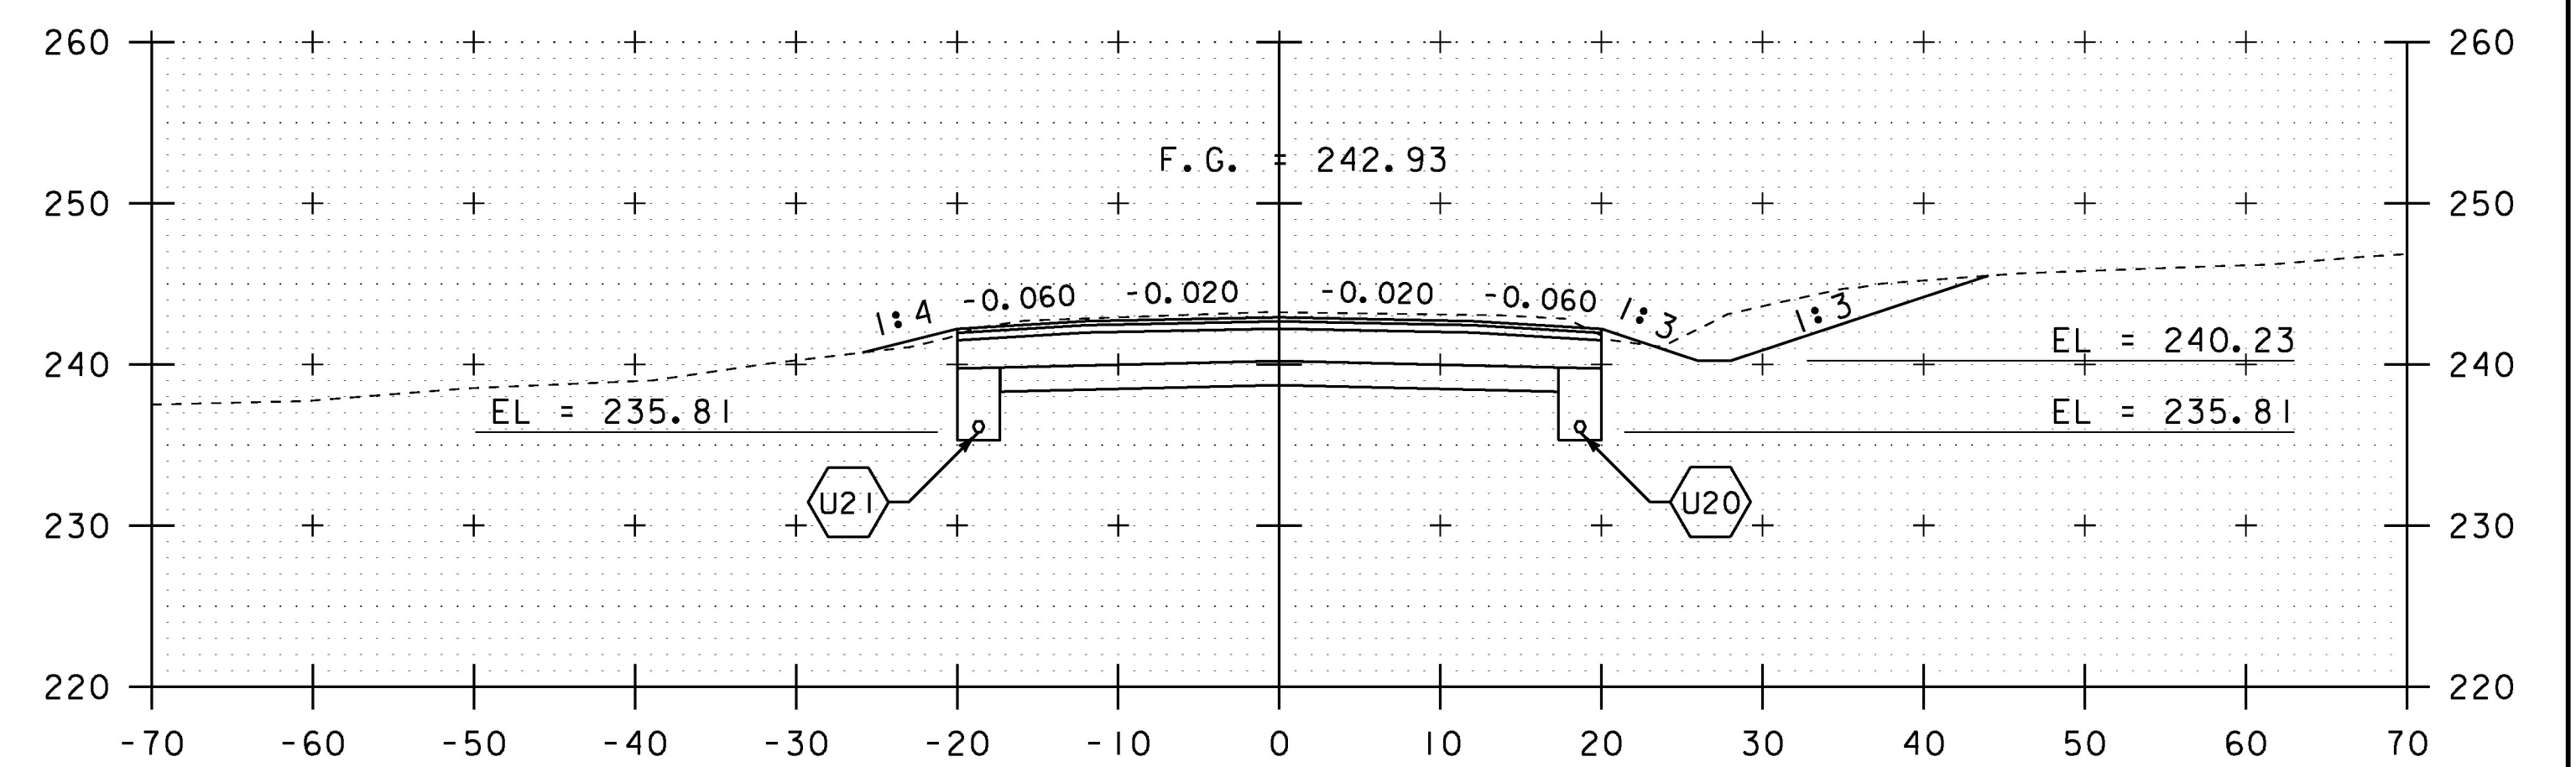

62+00

SCALE IN FEET

STA. 60+16 TO STA. 63+00

PROJECT NAME:	CHARLOTTE	PLOT DATE:	15-MAR-2016
PROJECT NUMBER:	F EGC 019-4(20)	DRAWN BY:	B. KIPP
FILE NAME:	d78d062_xs.dgn	CHECKED BY:	C. LEACH
PROJECT LEADER:	K. UPMAL	MAINLINE CROSS SECTIONS	32
DESIGNED BY:	B. KIPP	SHEET	309 OF 499