




81+00

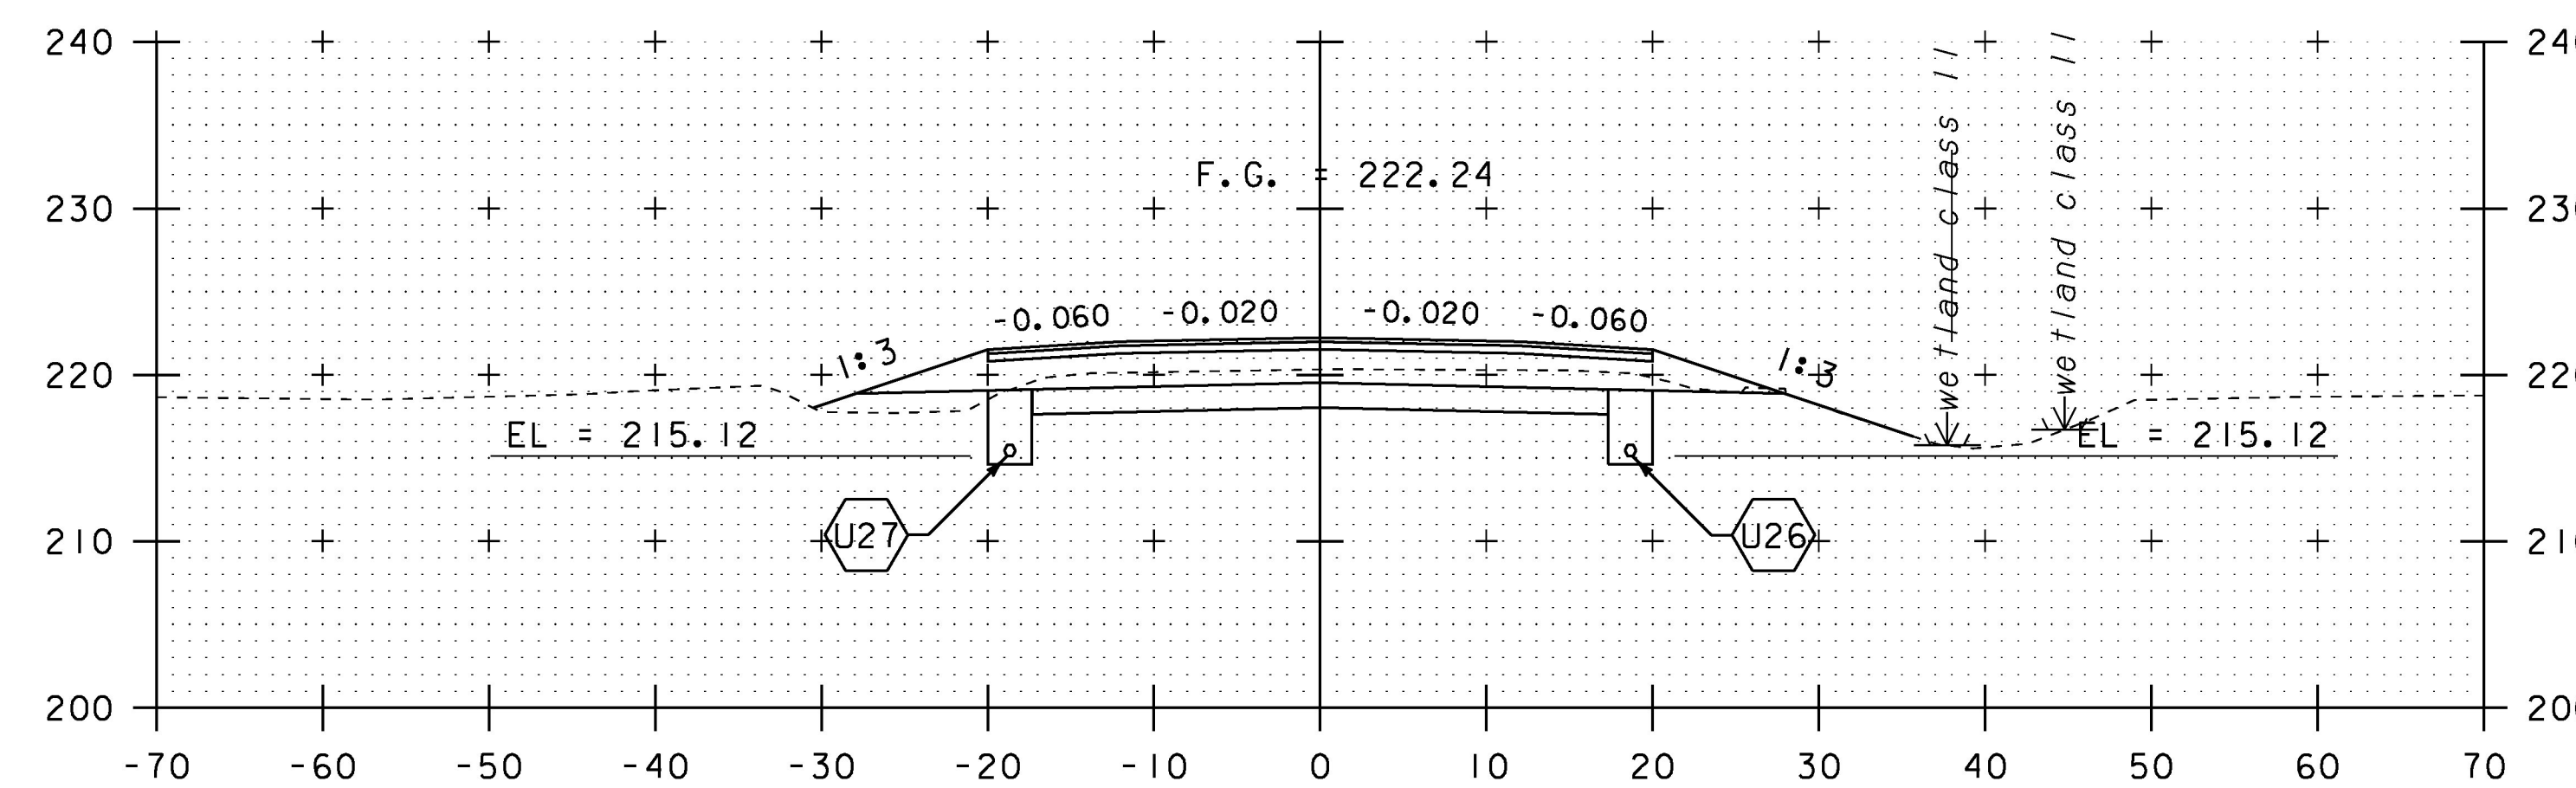


82+50

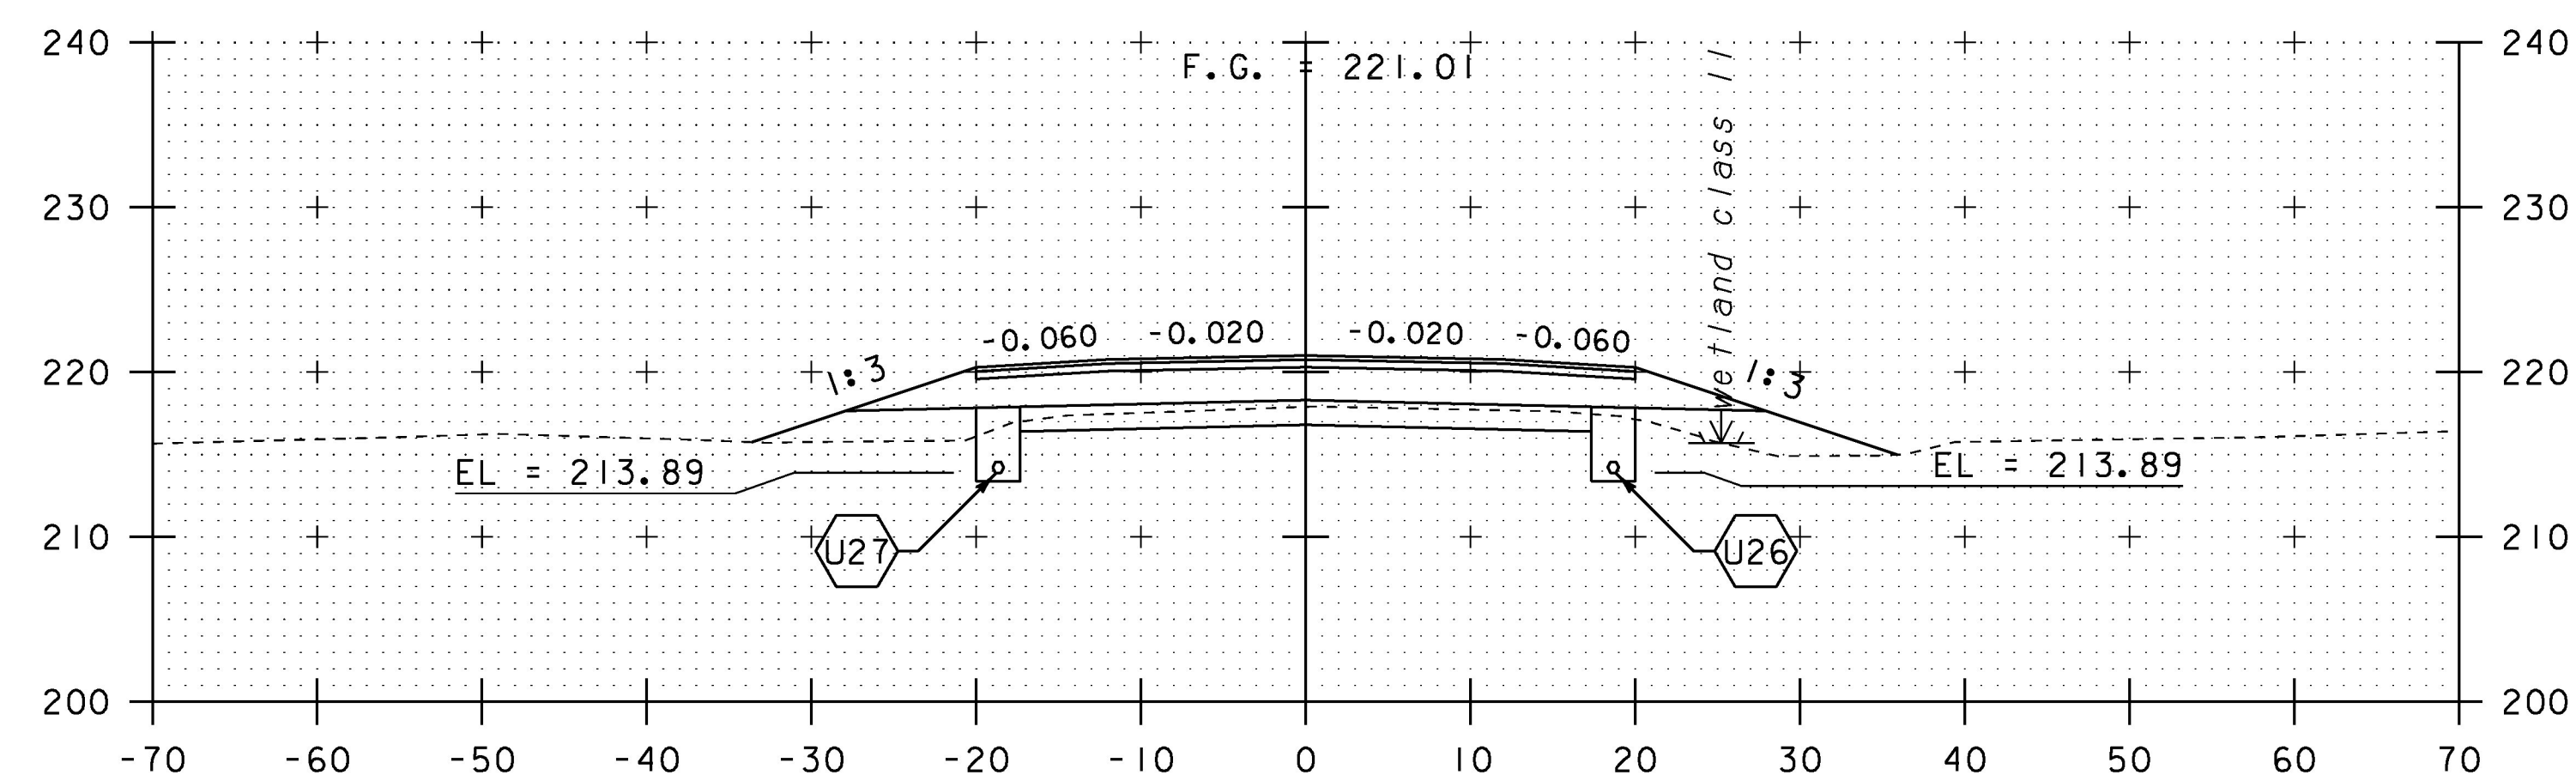


80+50

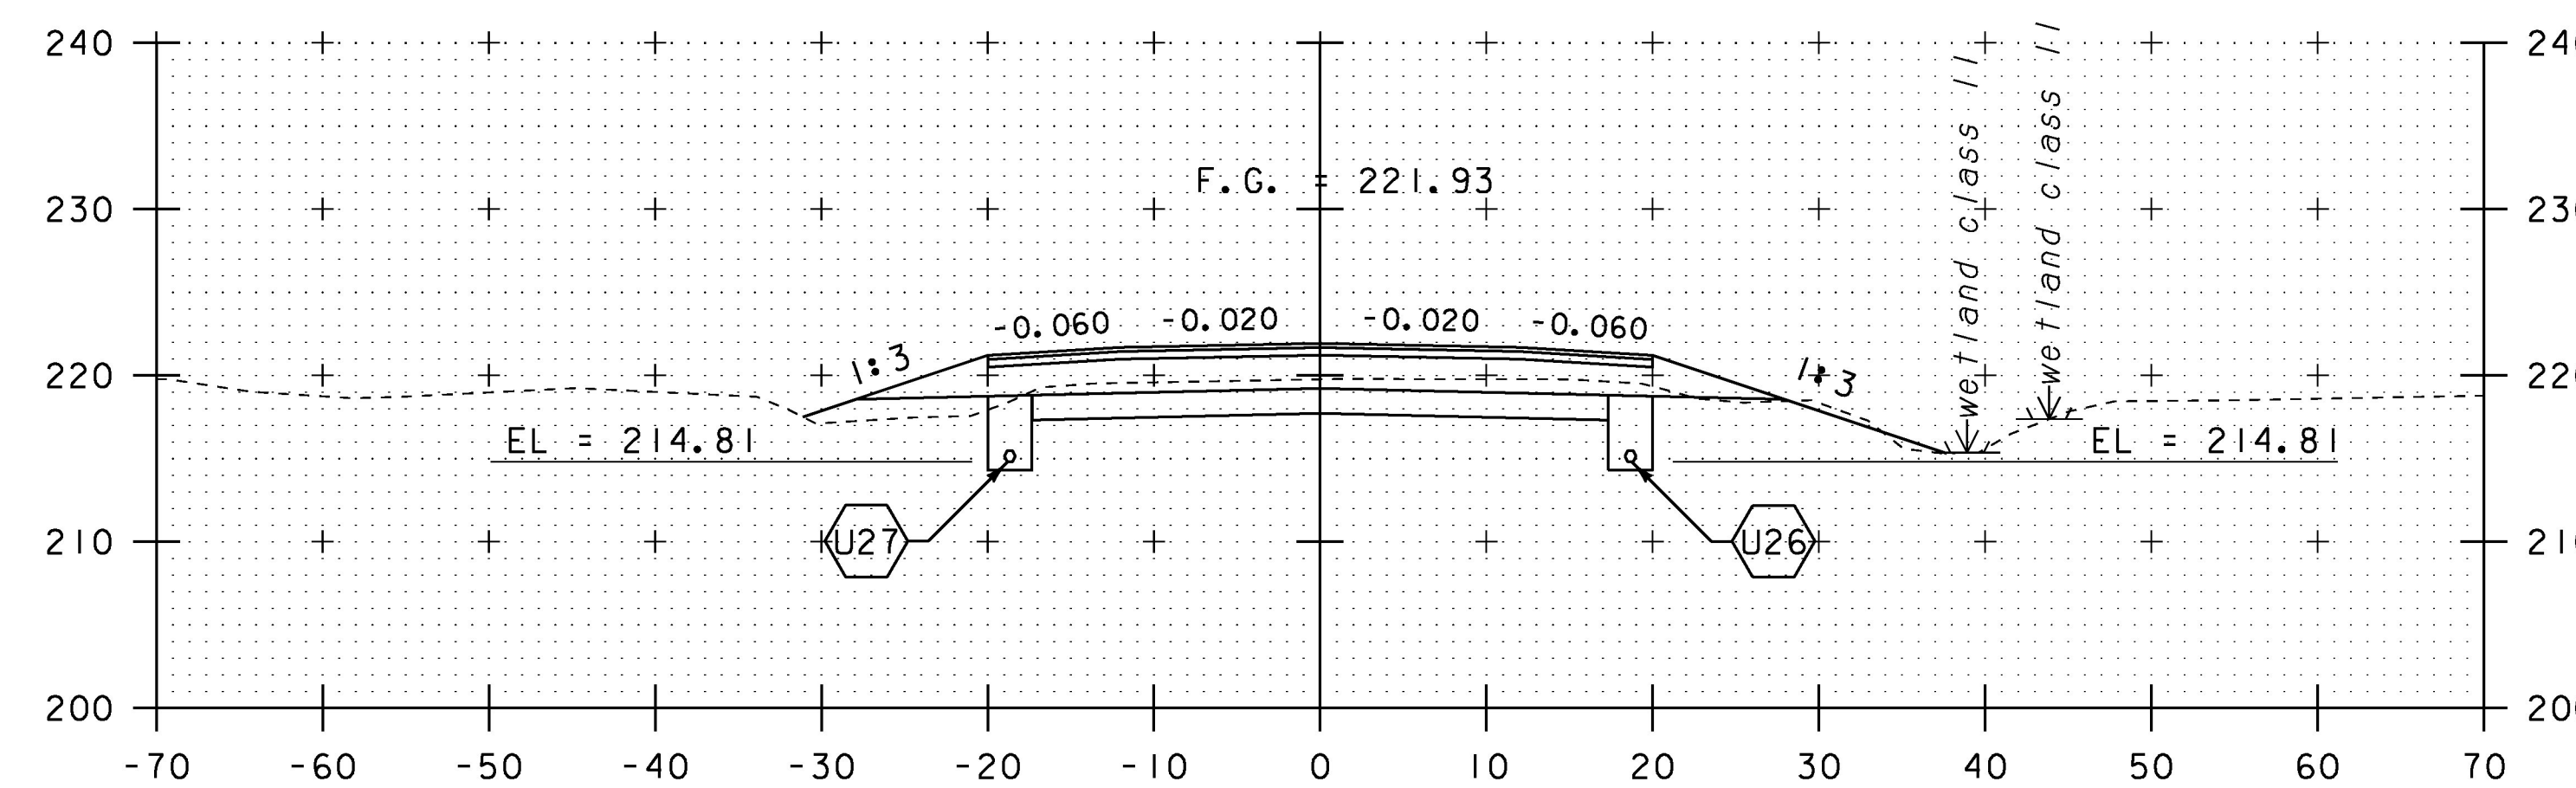

82+00

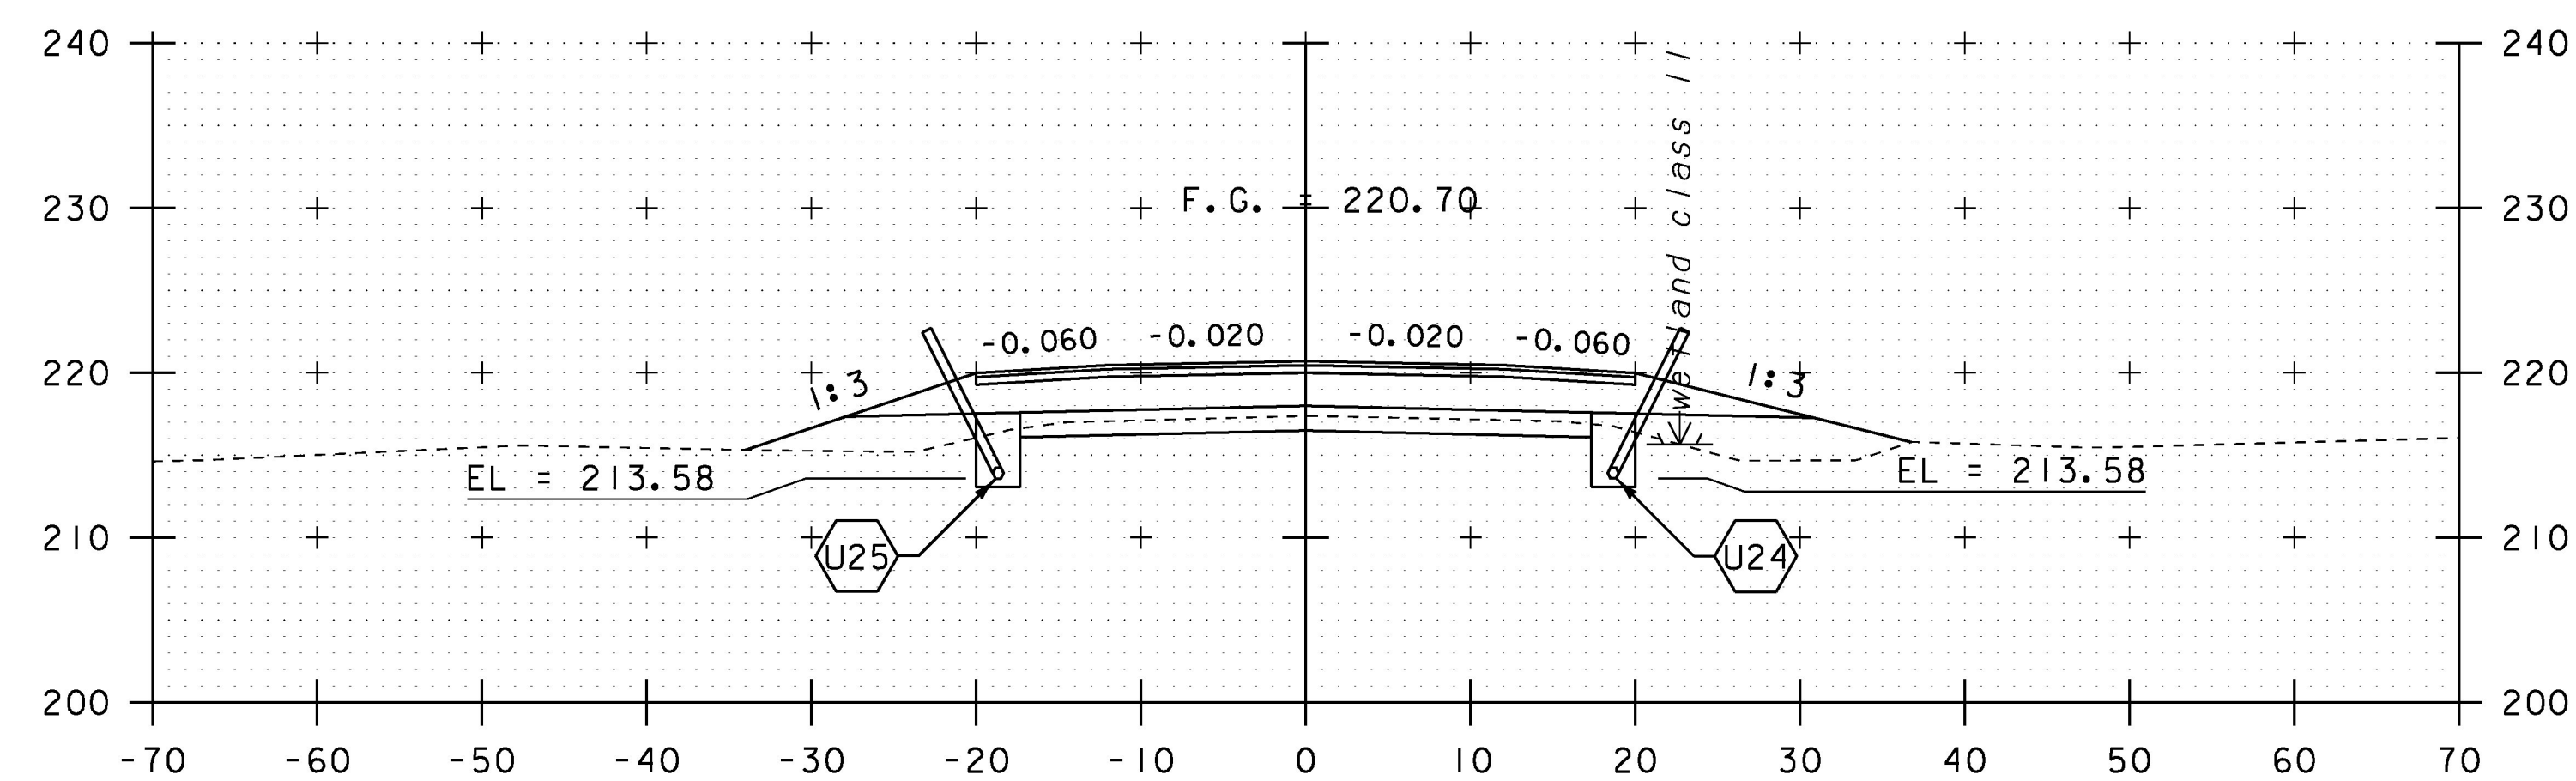

80+00

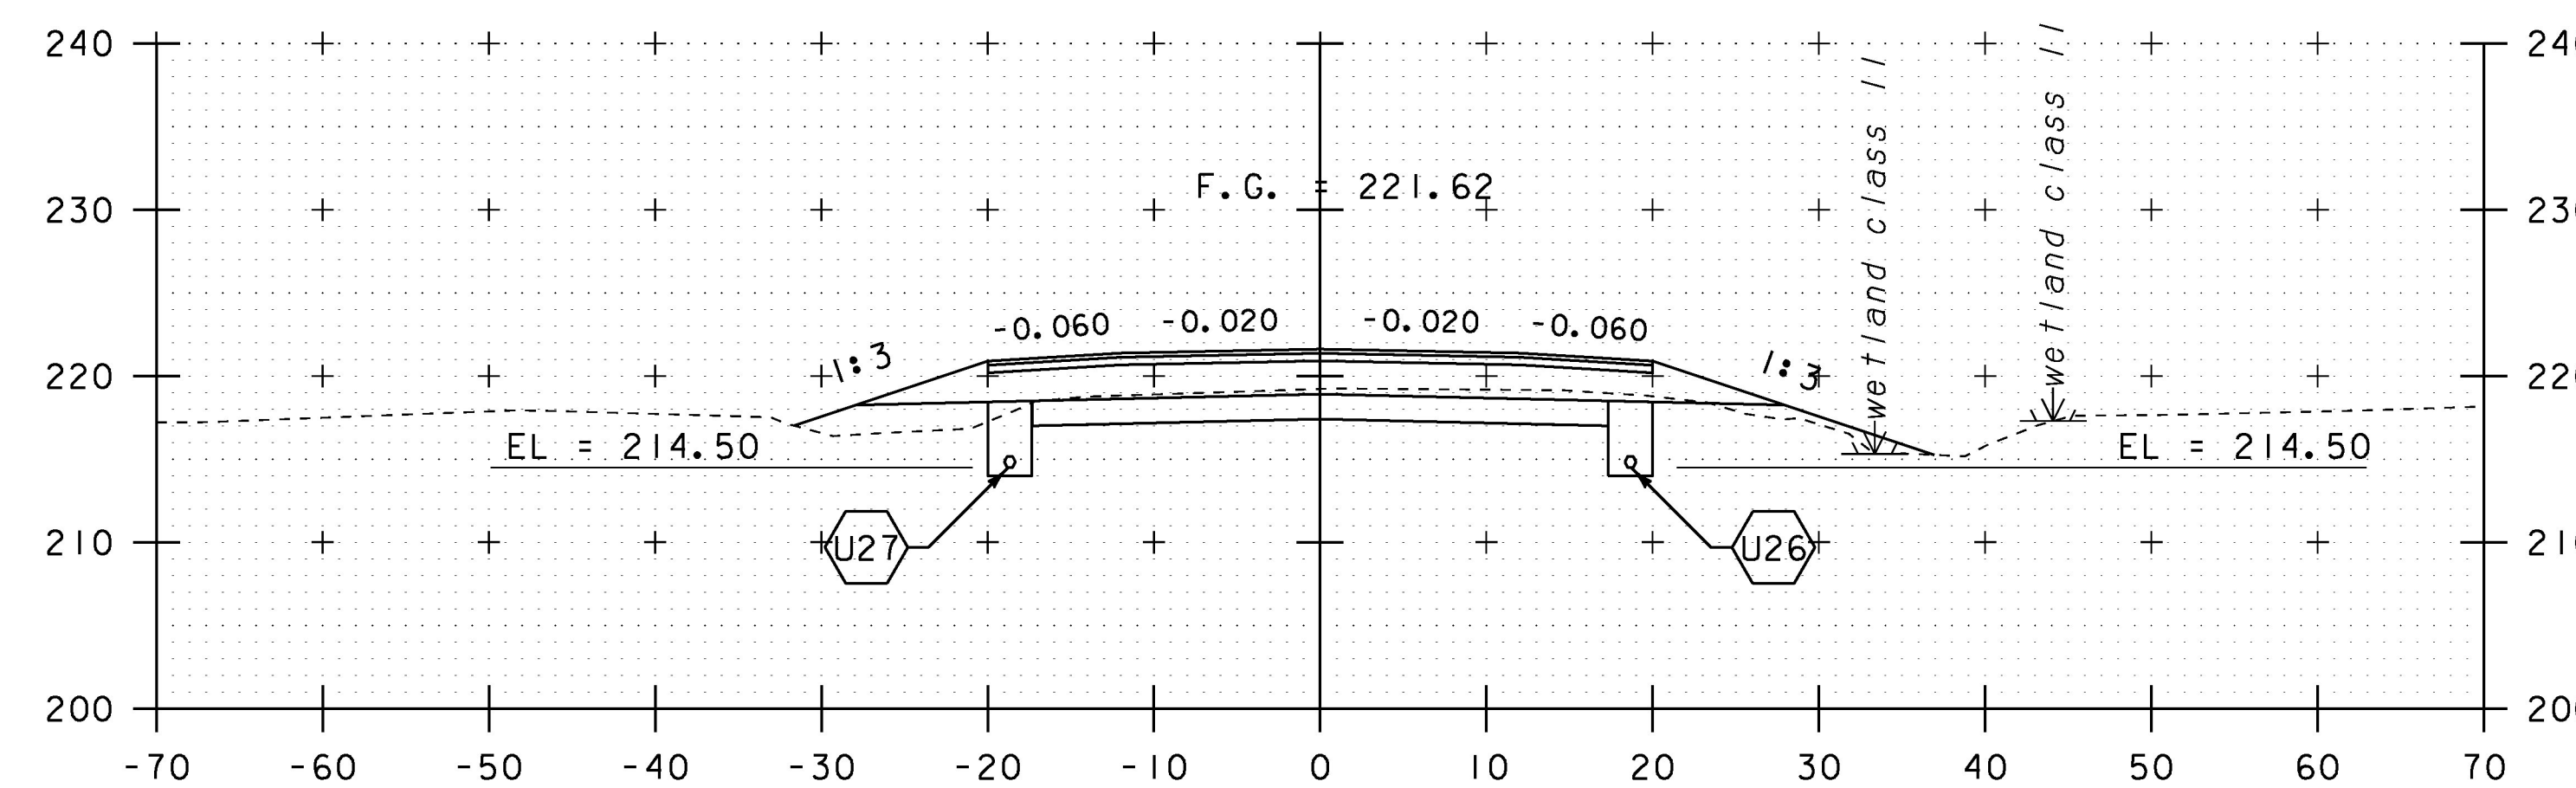

81+50

SCALE IN FEET

STA. 80+00 TO STA. 82+50

PROJECT NAME:	CHARLOTTE	PLOT DATE:	15-MAR-2016
PROJECT NUMBER:	F EGC 019-4(20)	DRAWN BY:	B. KIPP
FILE NAME:	d78d062_xs.dgn	CHECKED BY:	C. LEACH
PROJECT LEADER:	K. UPMAL	SHEET	319 OF 499
DESIGNED BY:	B. KIPP	MAINLINE CROSS SECTIONS	42