


93+61

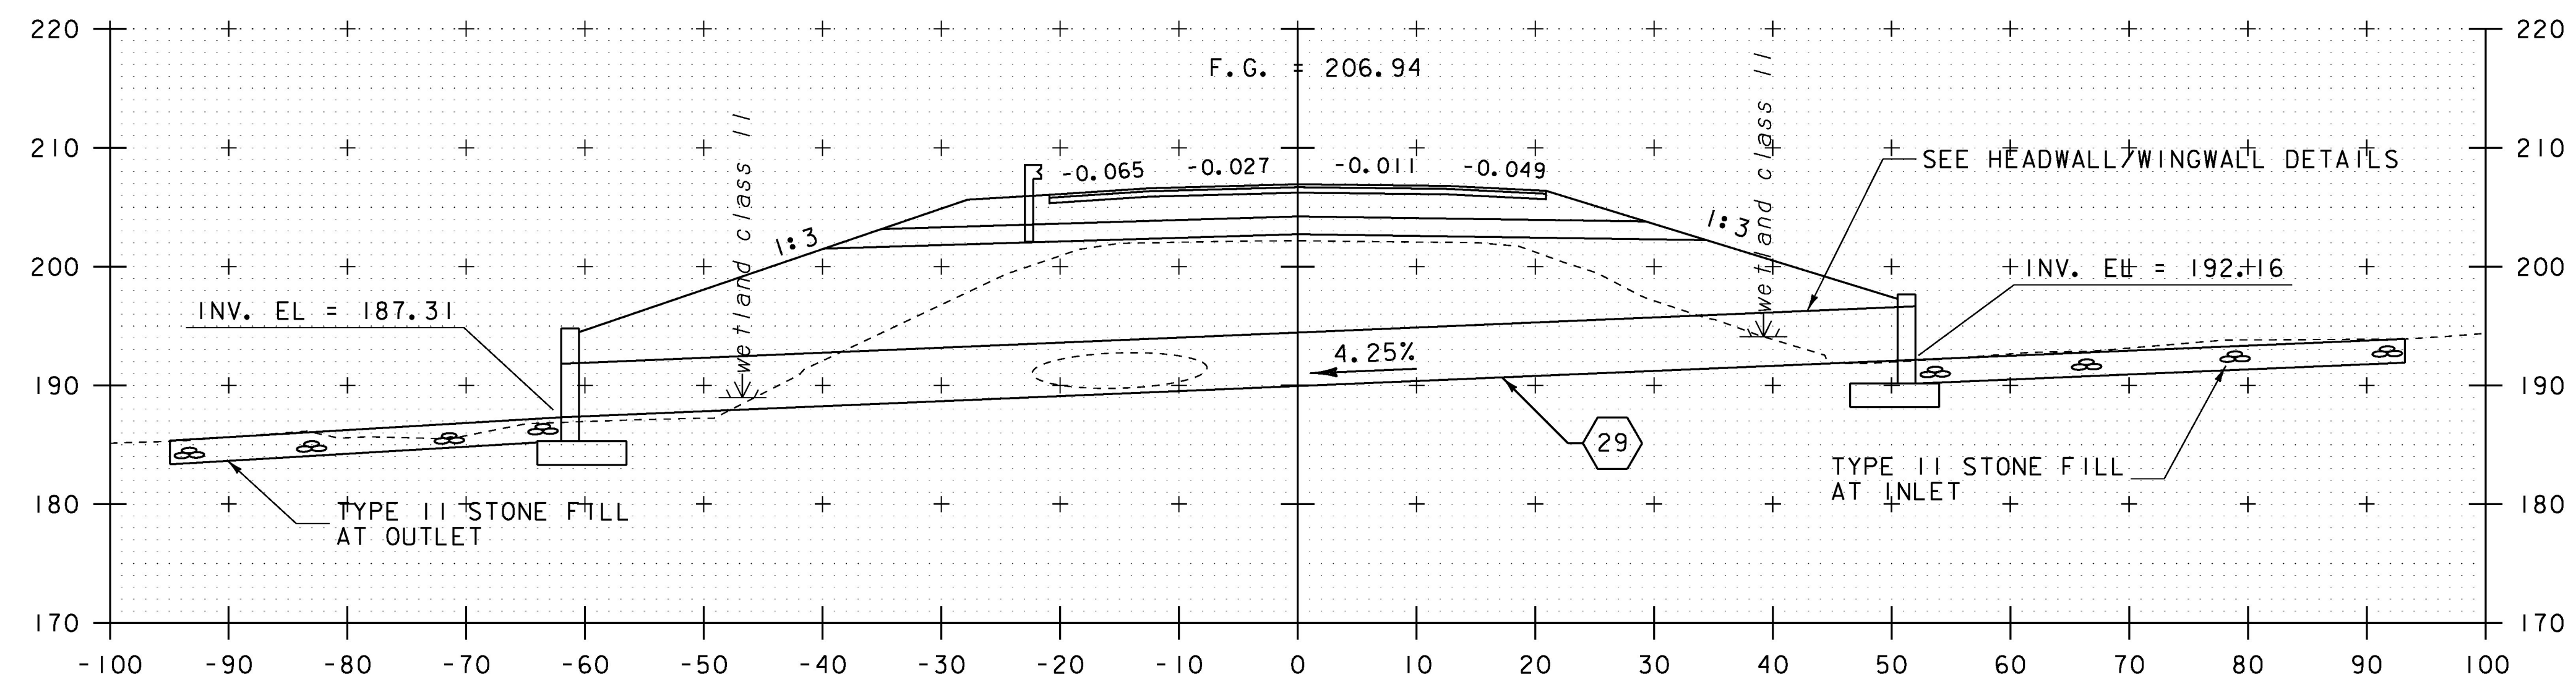

93+58 SKEWED 17°00' 00"
NEW 54" CPEP

SCALE IN FEET

STA. 93+58 TO STA. 93+61

PROJECT NAME: CHARLOTTE	PLOT DATE: 15-MAR-2016
PROJECT NUMBER: F EGC 019-4(20)	DRAWN BY: B. KIPP
FILE NAME: d78d062_xs.dgn	CHECKED BY: C. LEACH
PROJECT LEADER: K. UPMAL	SHEET 325 OF 499
DESIGNED BY: B. KIPP	MAINLINE CROSS SECTIONS 48