


132+25 DRIVE RT SECTION A-A

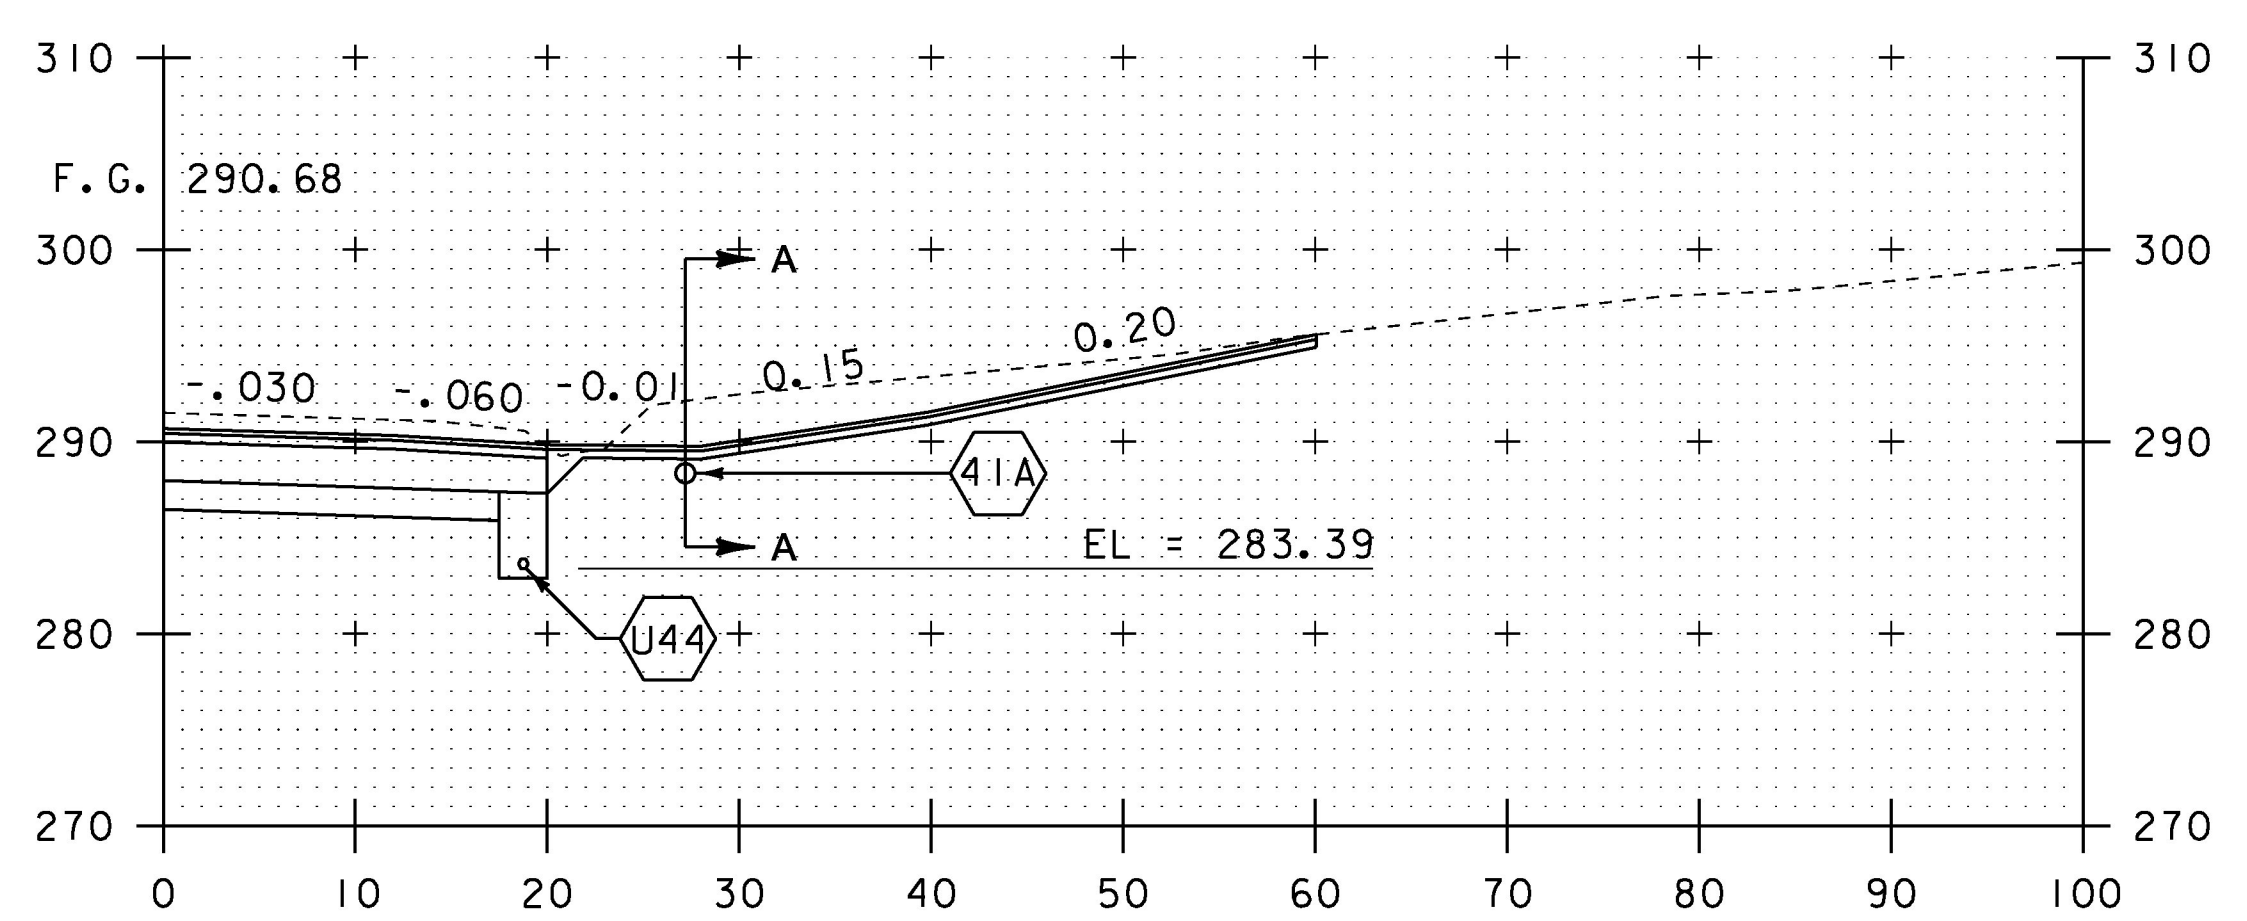

132+25 DRIVE RT

SCALE IN FEET

STA. 132+25

PROJECT NAME: CHARLOTTE	
PROJECT NUMBER: F EGC 019-4(20)	
FILE NAME: d78d062_xs.dgn	PLOT DATE: 15-MAR-2016
PROJECT LEADER: K. UPMAL	DRAWN BY: B. KIPP
DESIGNED BY: B. KIPP	CHECKED BY: HSD
MAINLINE CROSS SECTIONS 69	SHEET 346 OF 499