




136+22

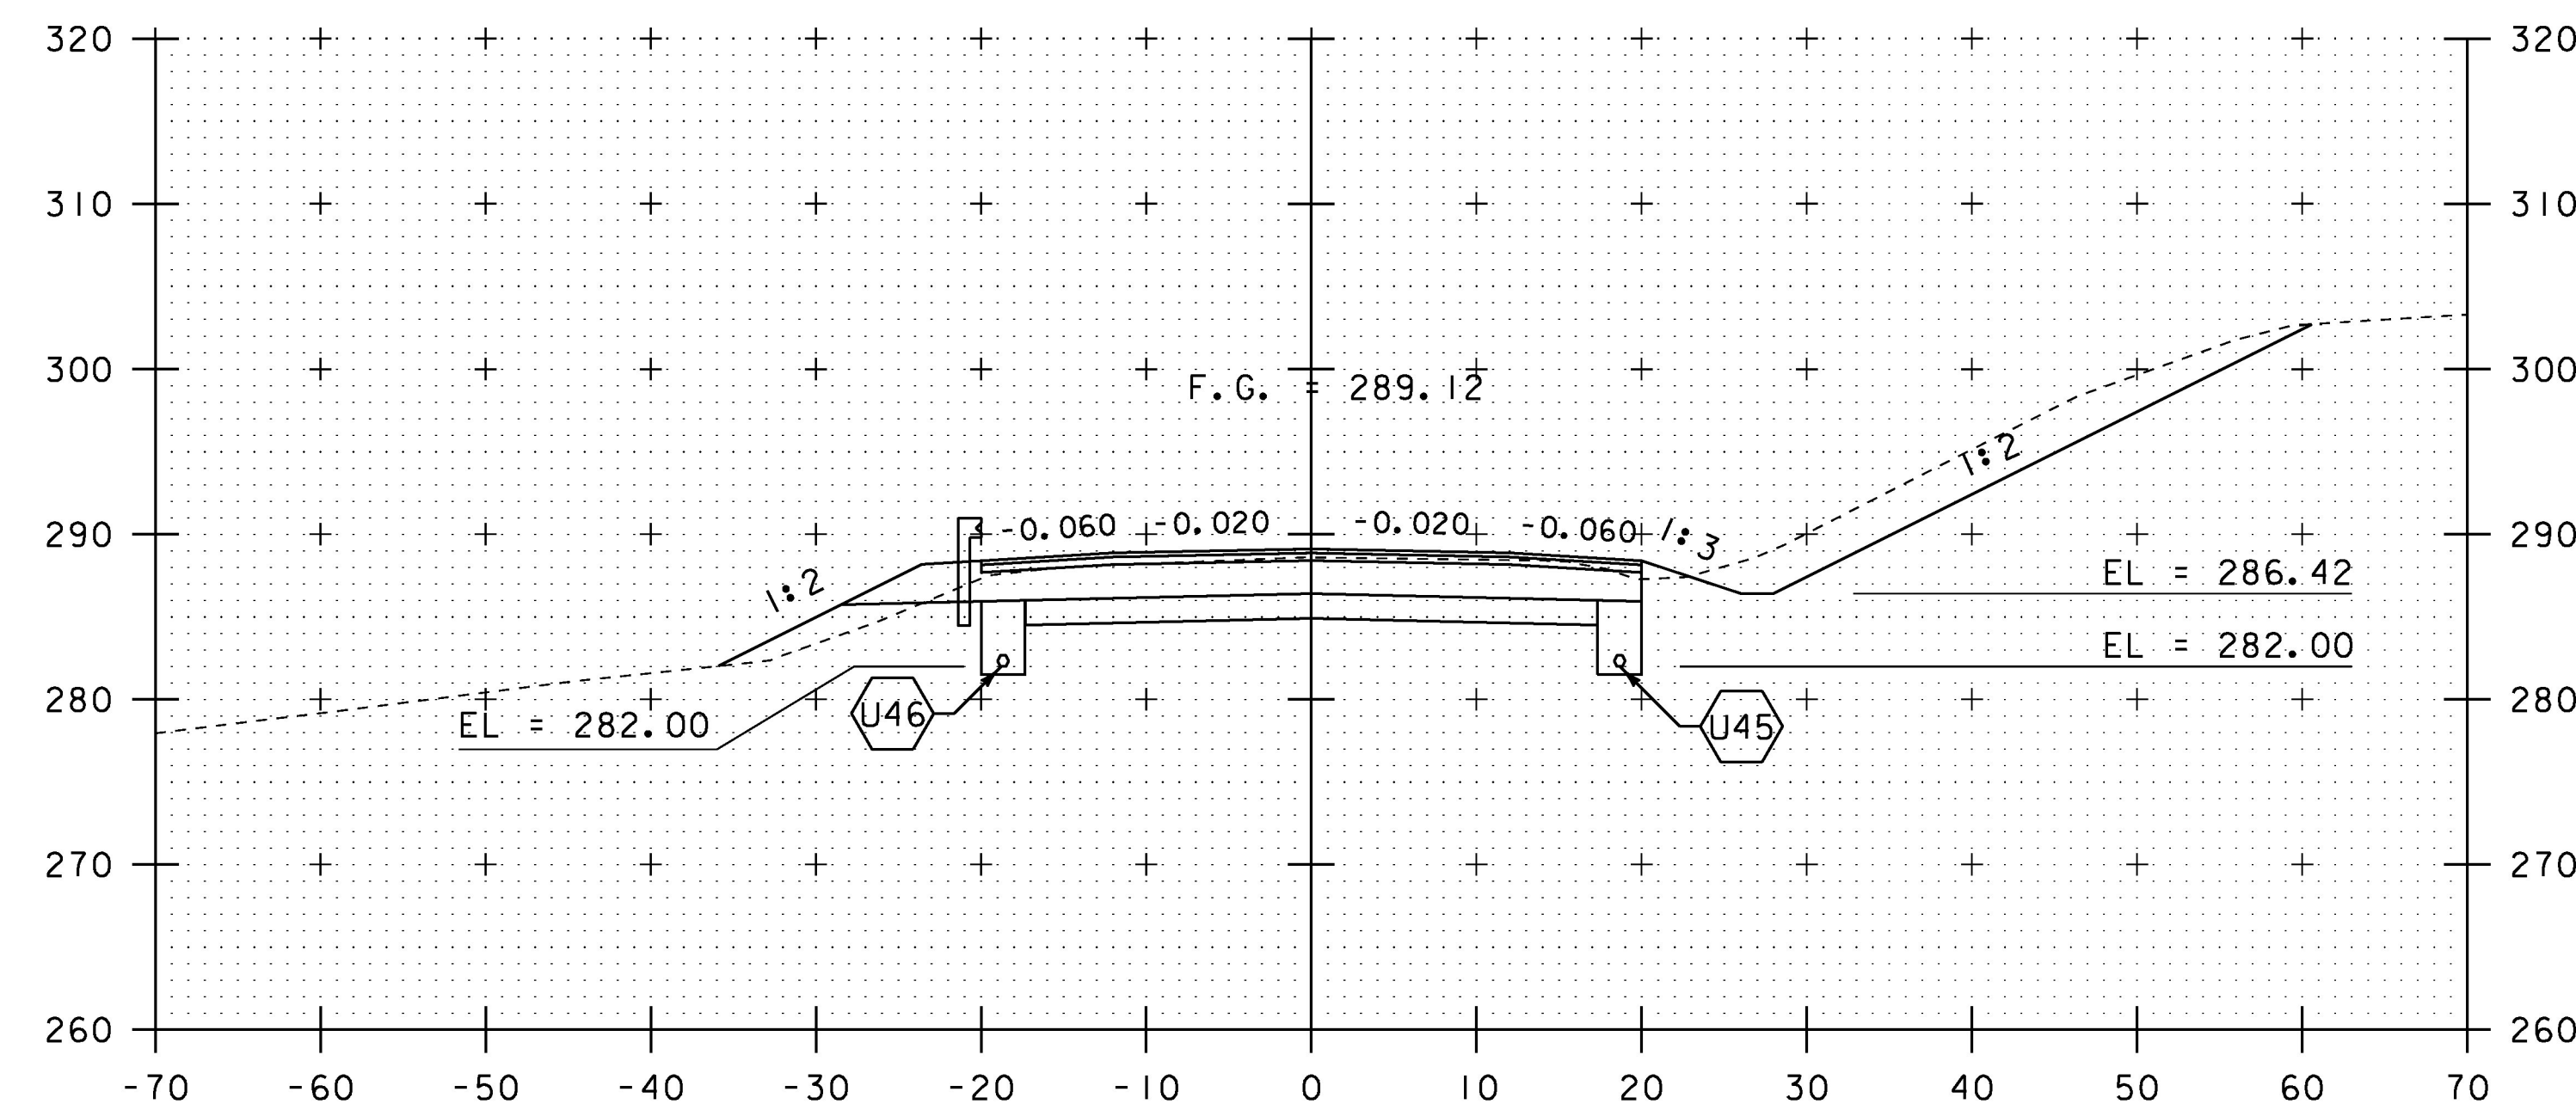

137+00

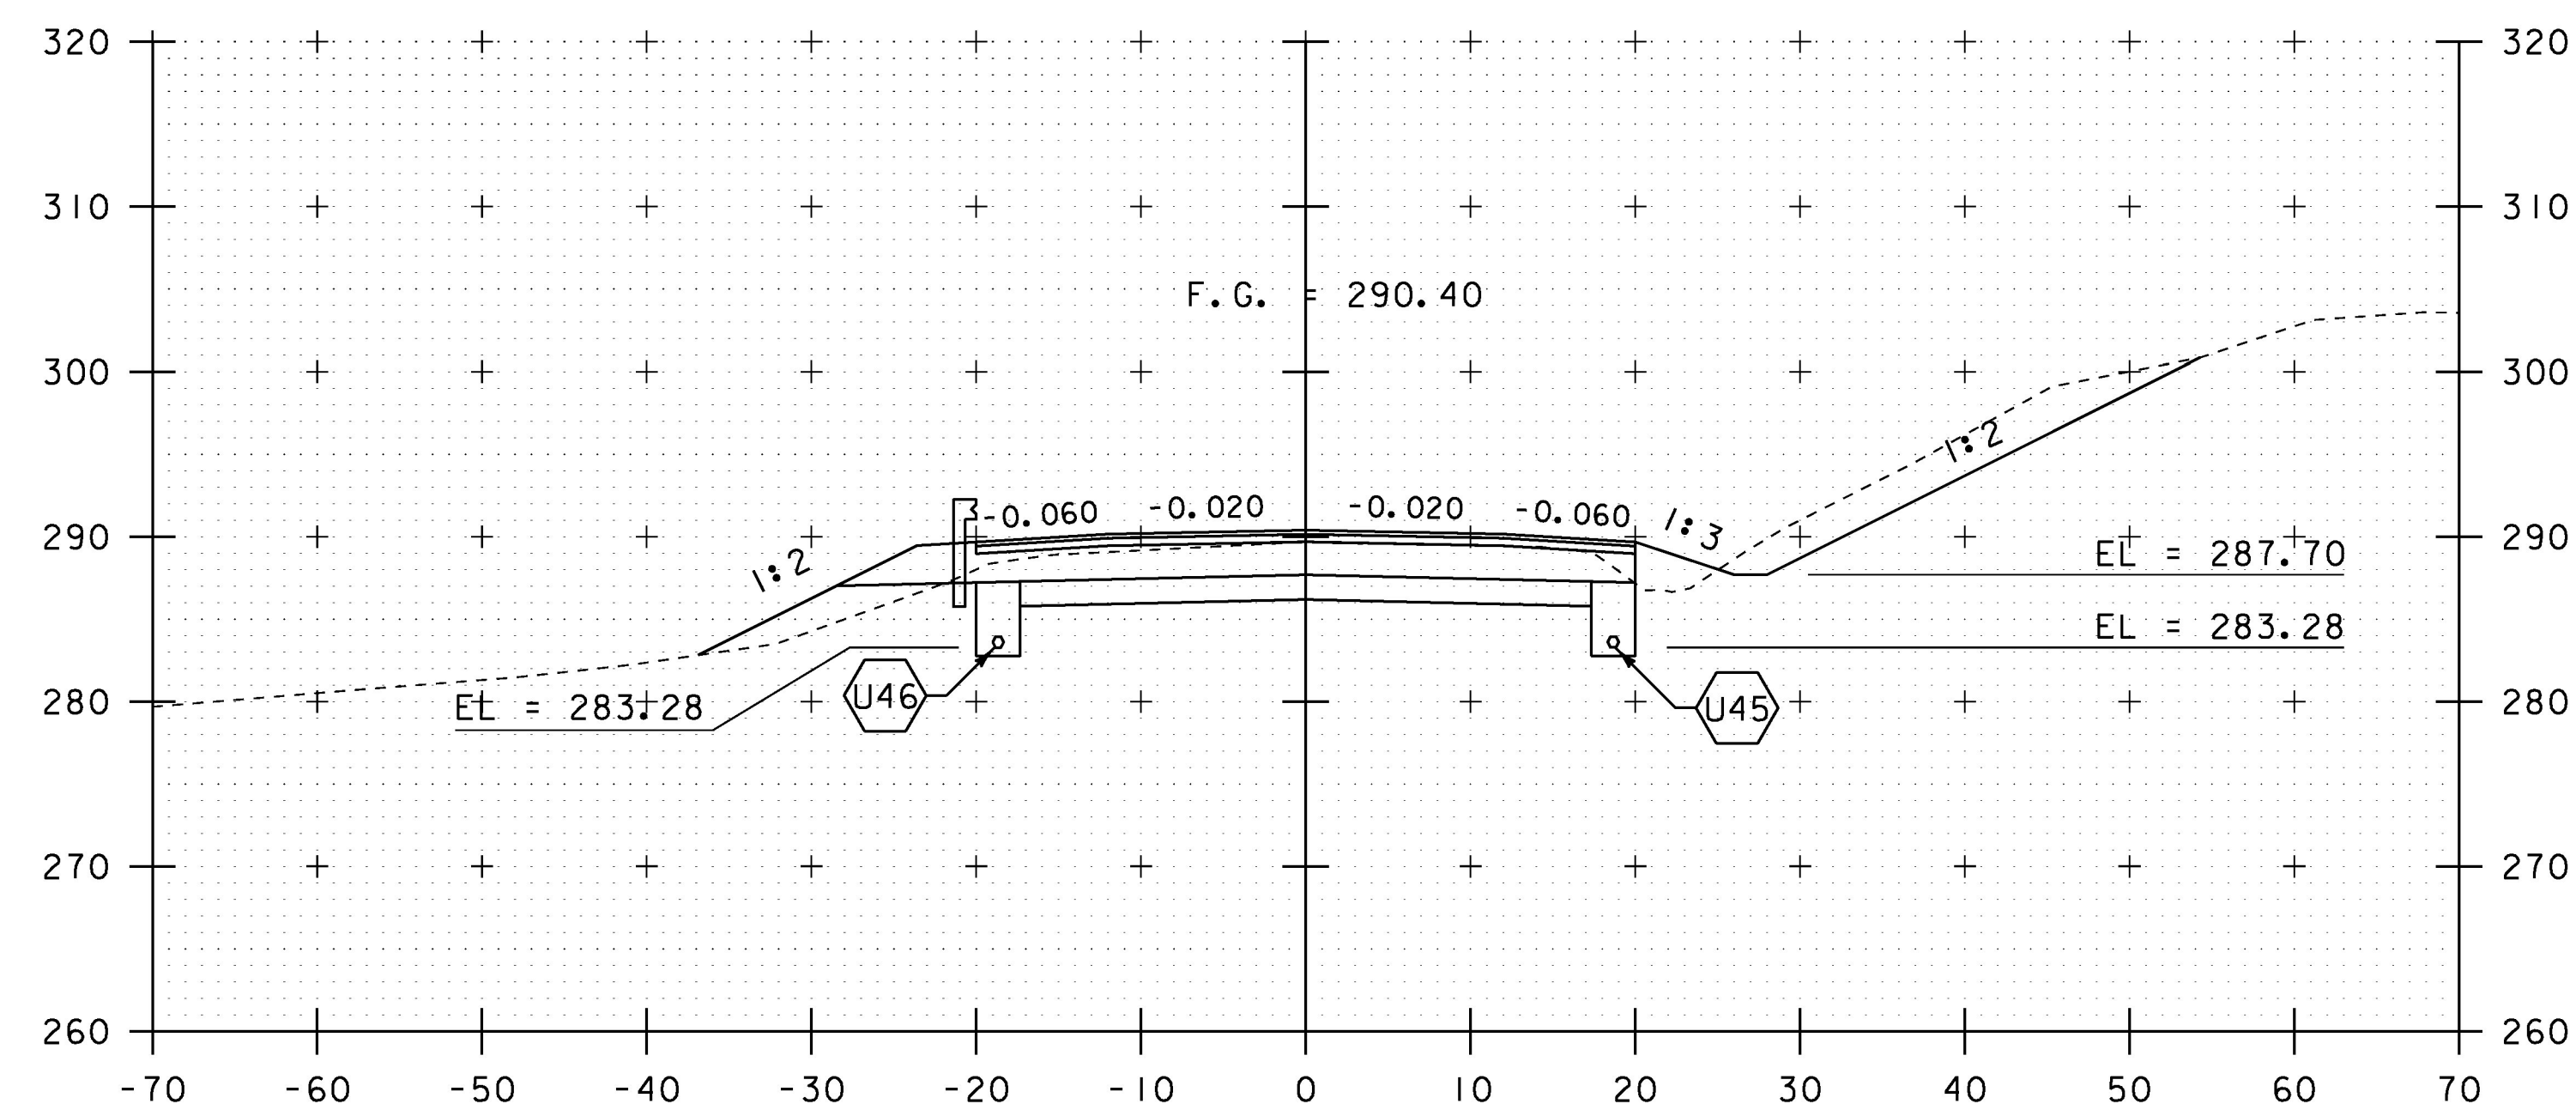

136+00

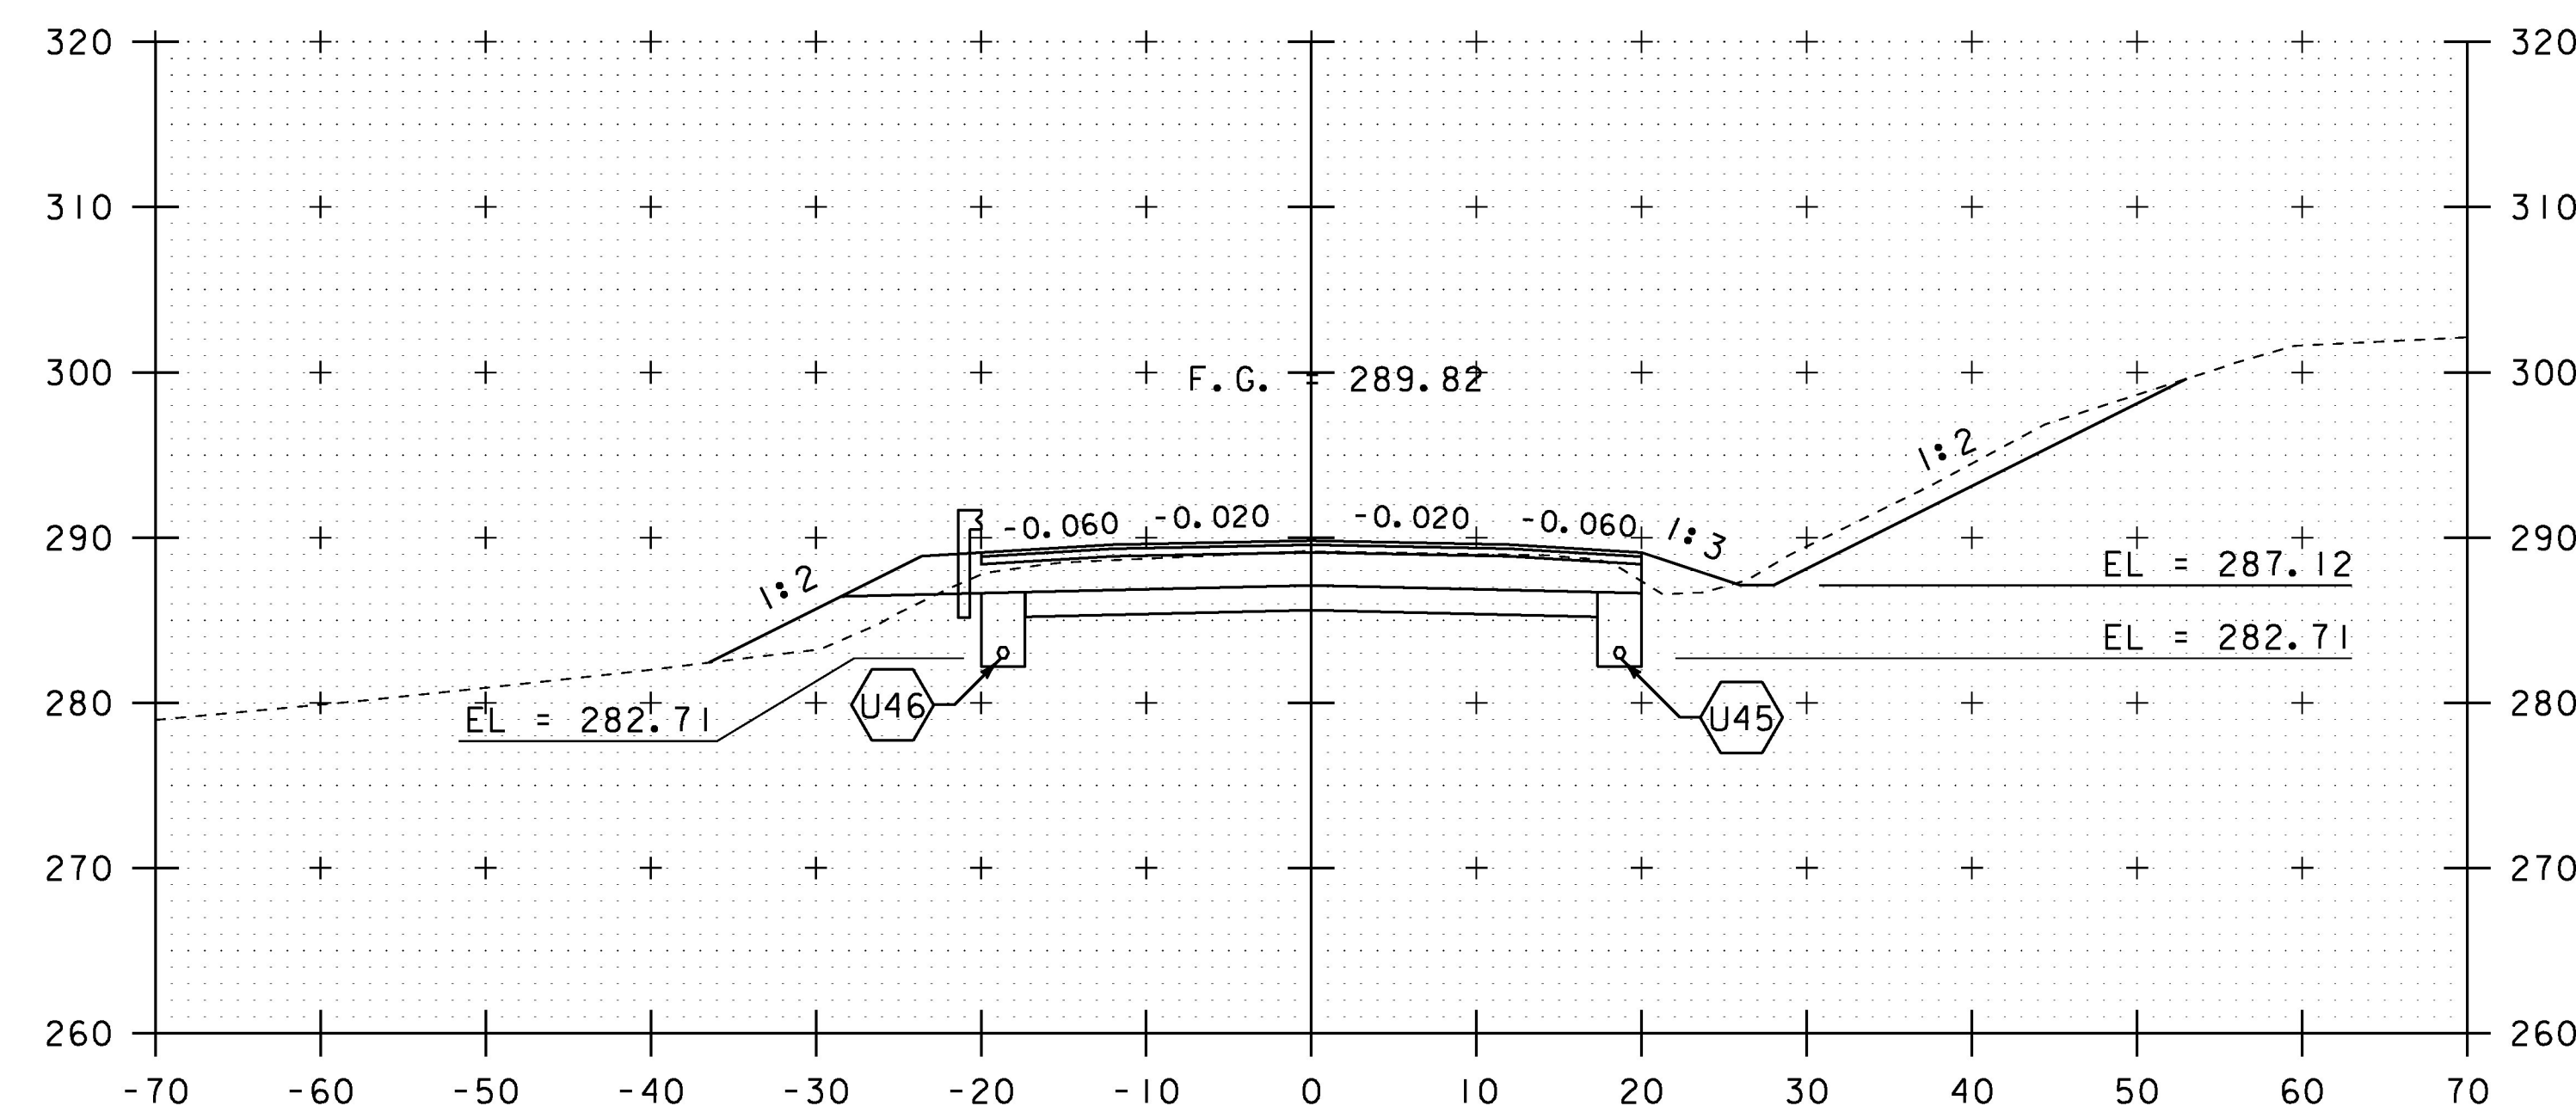

136+50

SCALE IN FEET

STA. 136+00 TO STA. 137+00

PROJECT NAME:	CHARLOTTE	PLOT DATE:	15-MAR-2016
PROJECT NUMBER:	F EGC 019-4(20)	DRAWN BY:	B. KIPP
FILE NAME:	d78d062_xs.dgn	CHECKED BY:	C. LEACH
PROJECT LEADER:	K. UPMAL	MAINLINE CROSS SECTIONS	72
DESIGNED BY:	B. KIPP	SHEET	349 OF 499