


149+50

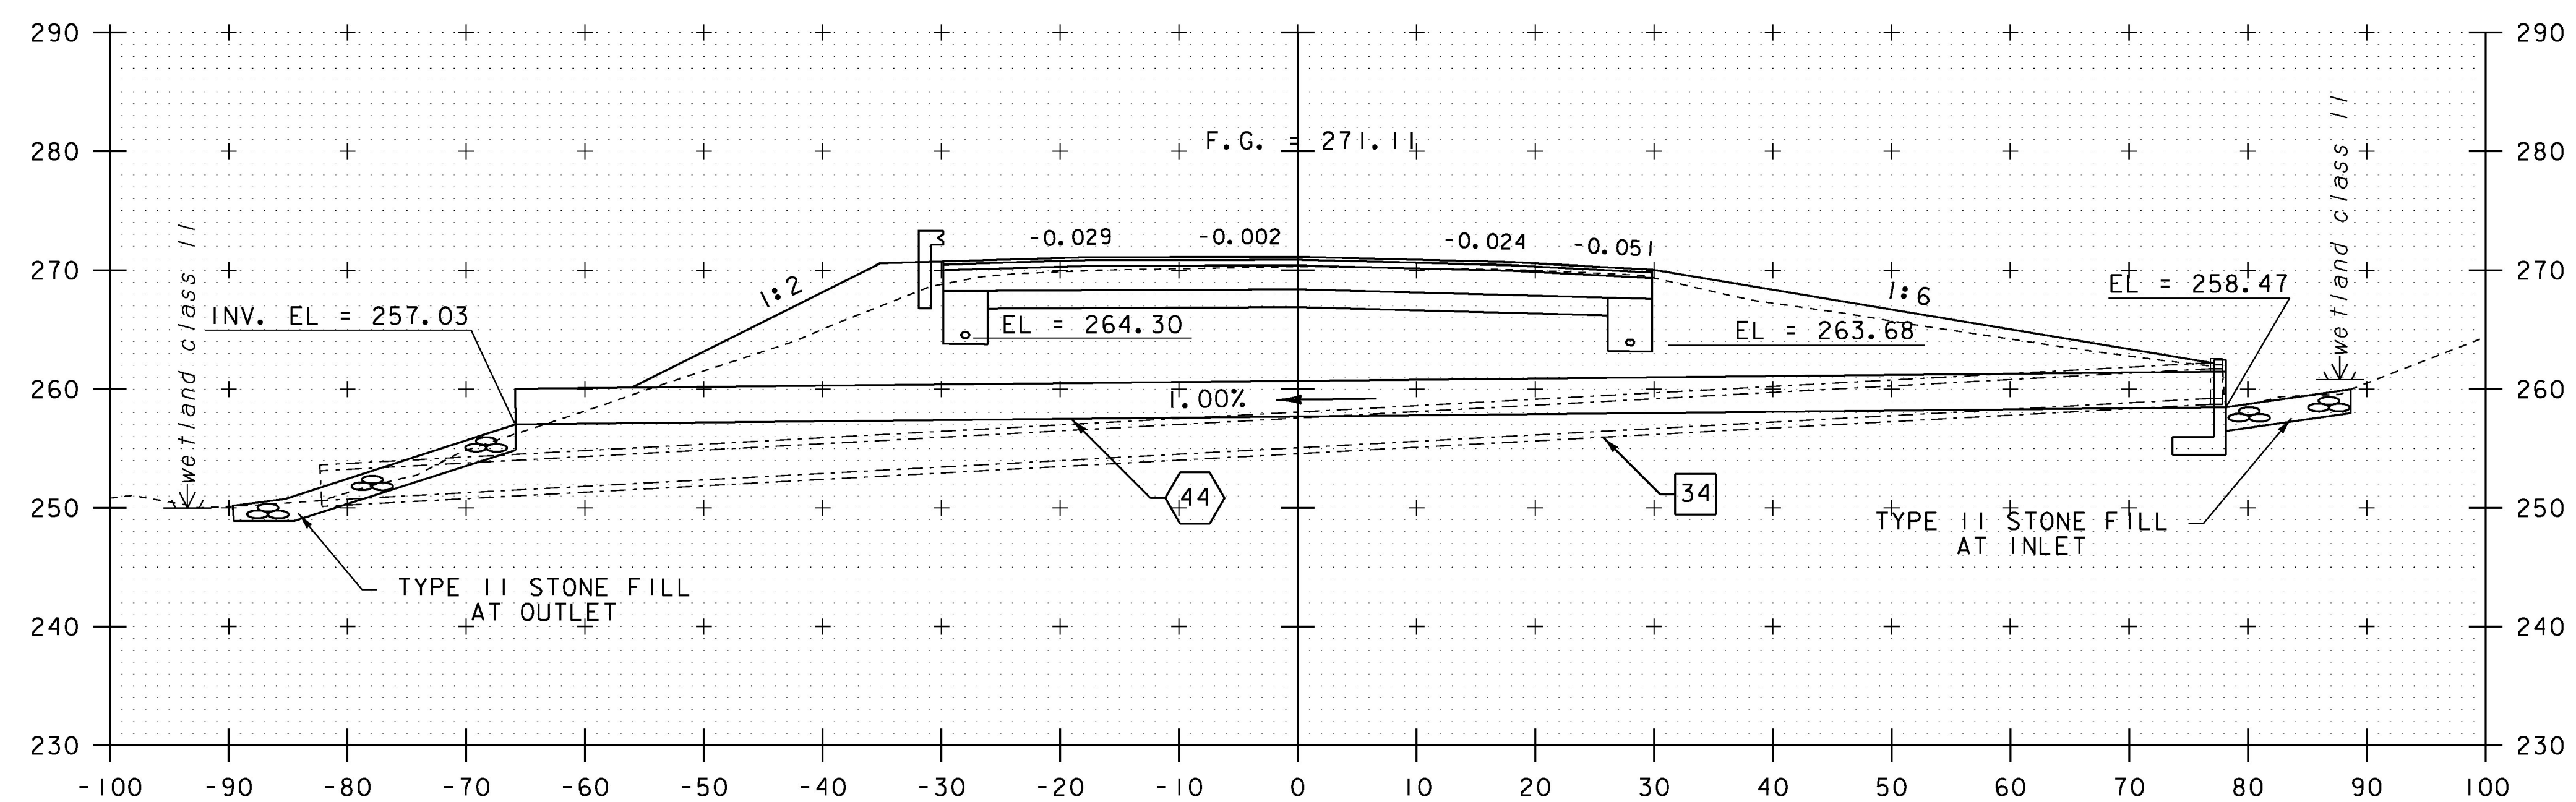

149+10 ANGLE 48° 00' 00" RT  
NEW 36" CPEP

SCALE IN FEET

STA. 149+10 TO STA. 149+50

PROJECT NAME: CHARLOTTE	PLOT DATE: 15-MAR-2016
PROJECT NUMBER: F EGC 019-4(20)	DRAWN BY: B. KIPP
FILE NAME: d78d062_xs.dgn	CHECKED BY: C. LEACH
PROJECT LEADER: K. UPMAL	SHEET 357 OF 499
DESIGNED BY: B. KIPP	
MAINLINE CROSS SECTIONS 80	