




154+91 DRIVE LT
(SKewed 77° 12' 51.76") RT

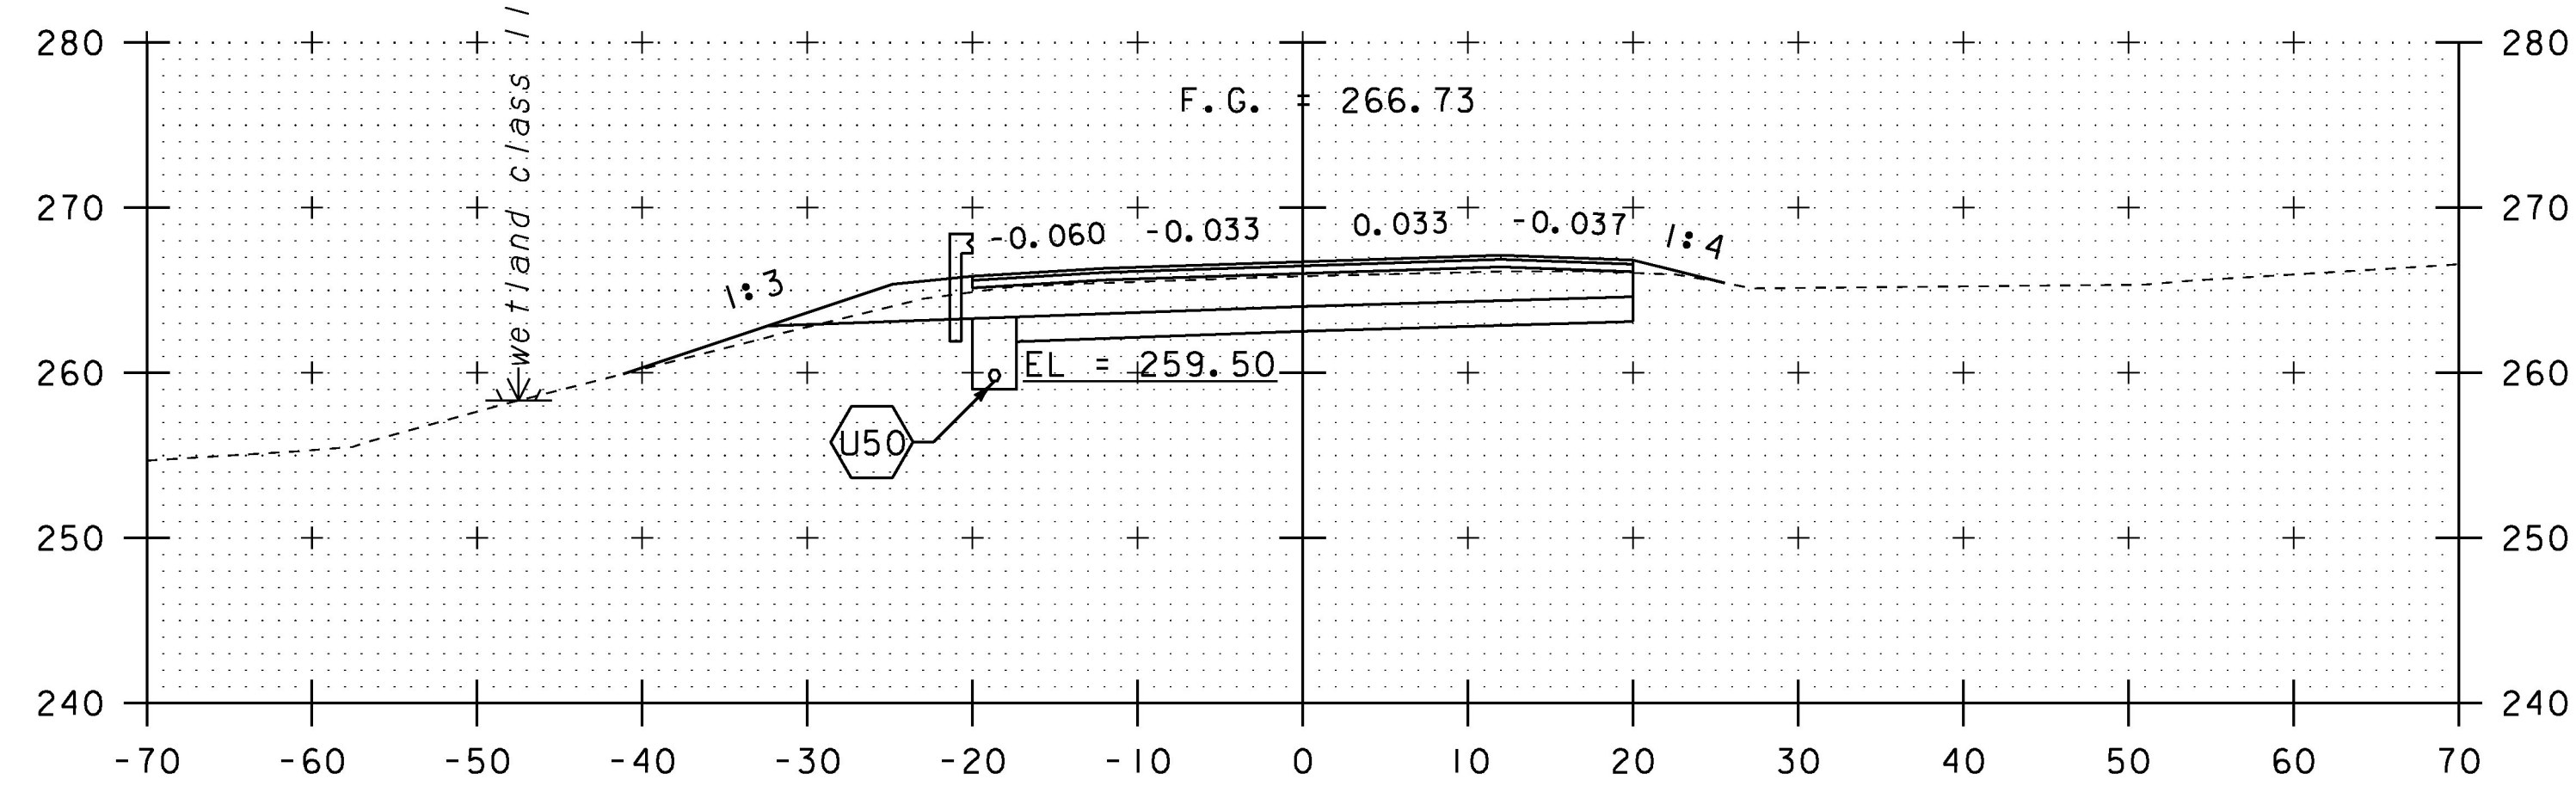


154+50

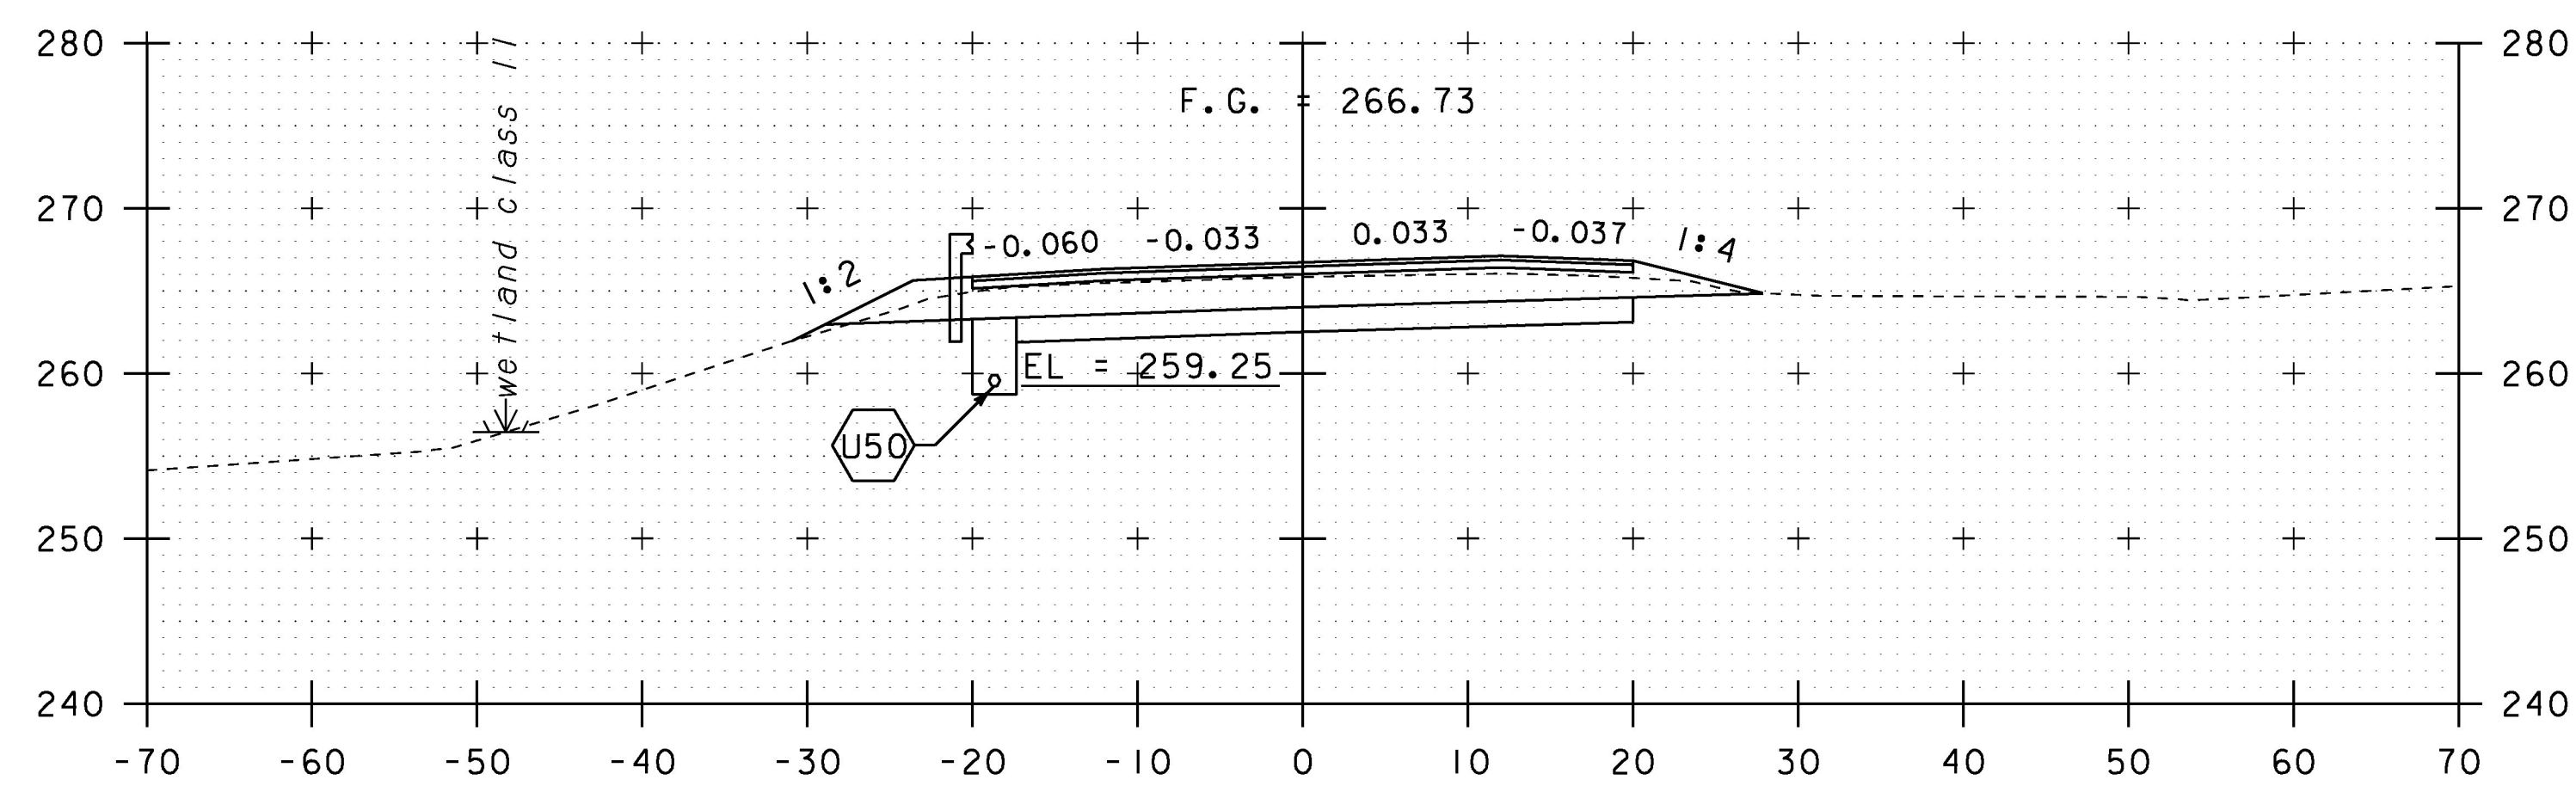

154+00

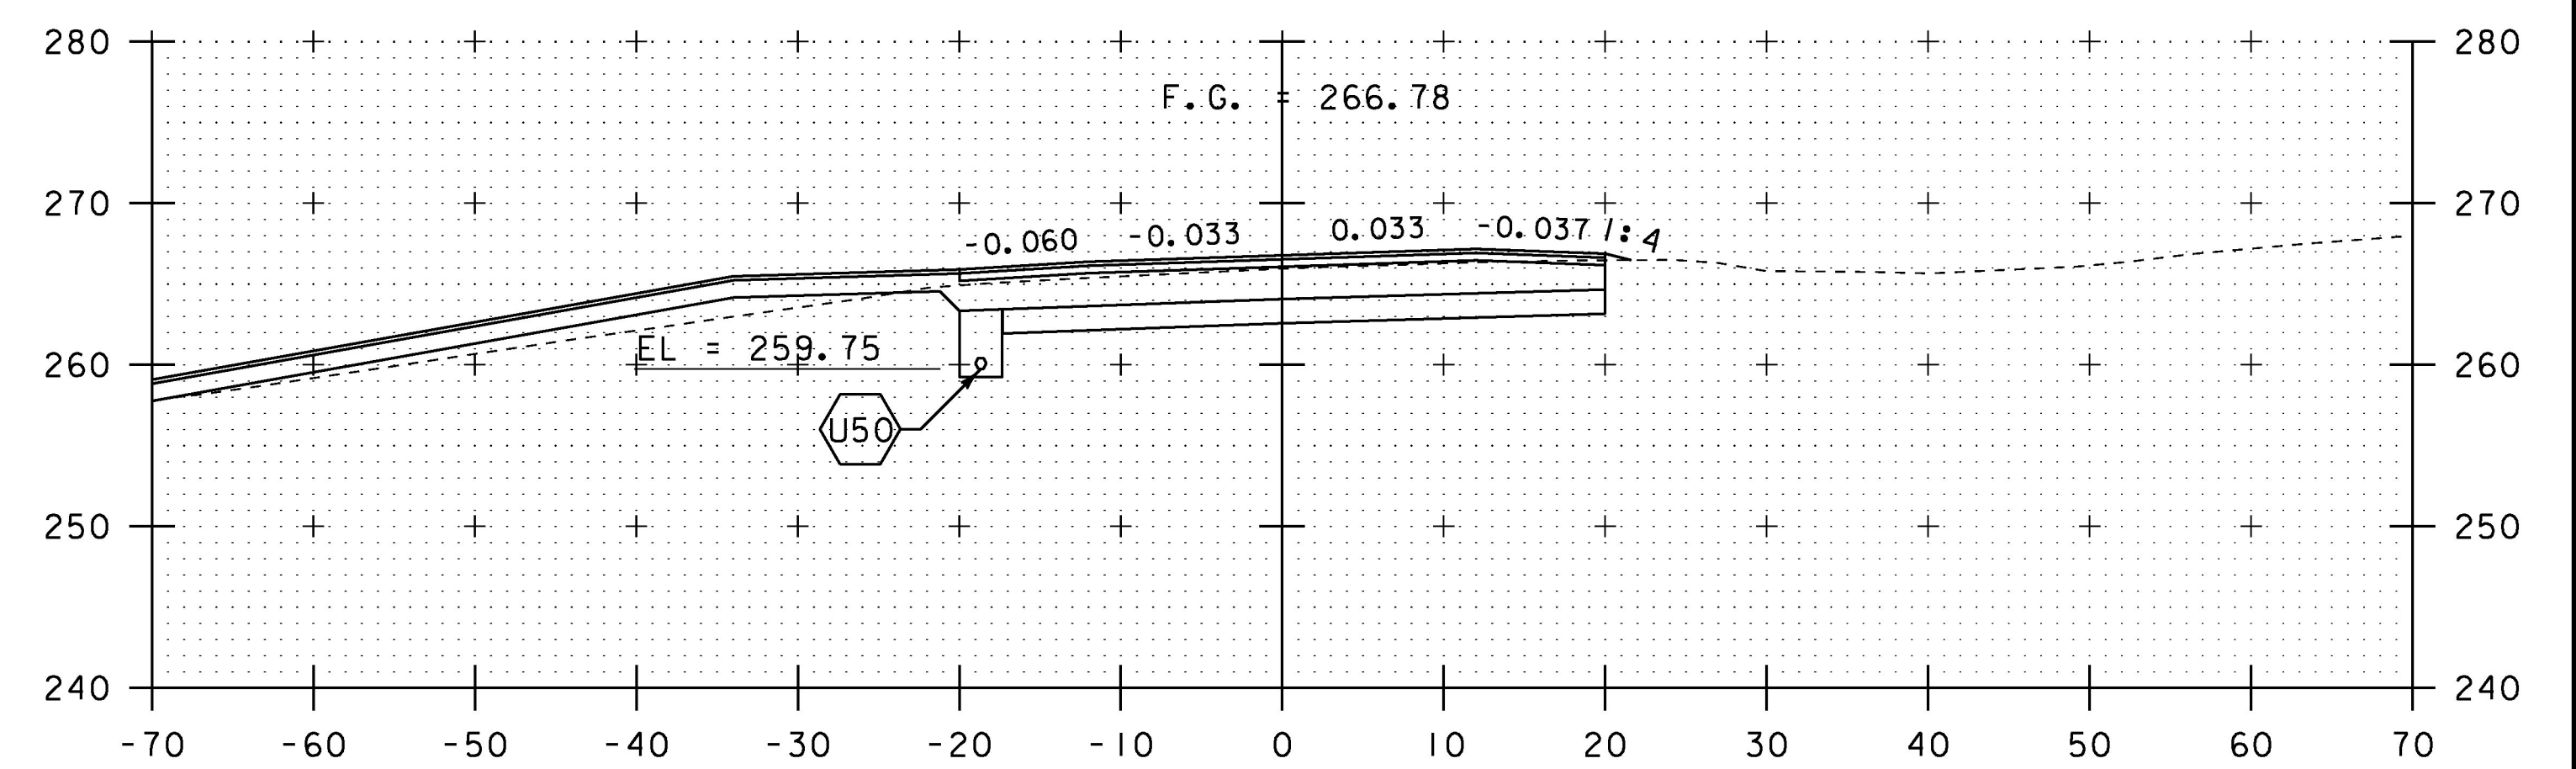

155+00

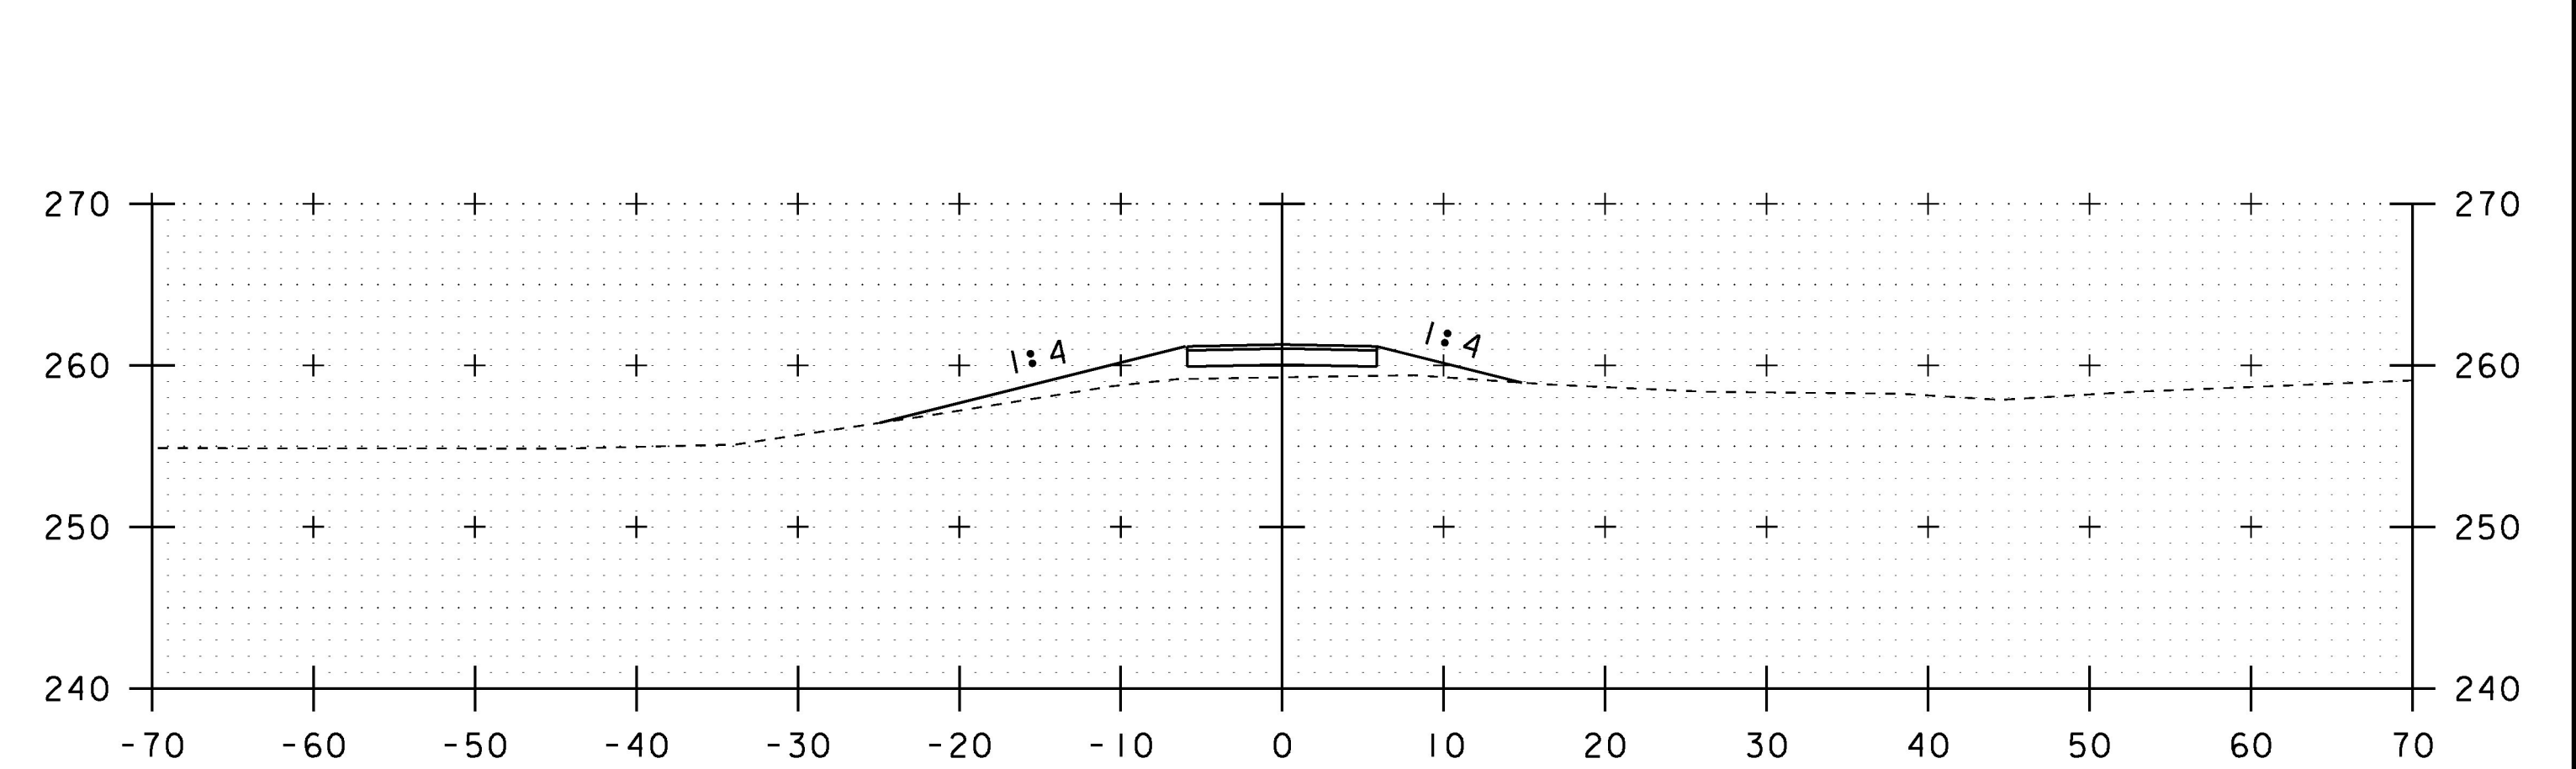

154+91 DRIVE LT SECTION A-A

SCALE IN FEET

STA. 154+00 TO STA. 155+00

PROJECT NAME: CHARLOTTE	PLOT DATE: 15-MAR-2016
PROJECT NUMBER: F EGC 019-4(20)	DRAWN BY: B. KIPP
FILE NAME: d78d062_xs.dgn	CHECKED BY: C. LEACH
PROJECT LEADER: K. UPMAL	SHEET 360 OF 499
DESIGNED BY: B. KIPP	
MAINLINE CROSS SECTIONS 83	