




163+72 DRIVE LT SECTION A-A

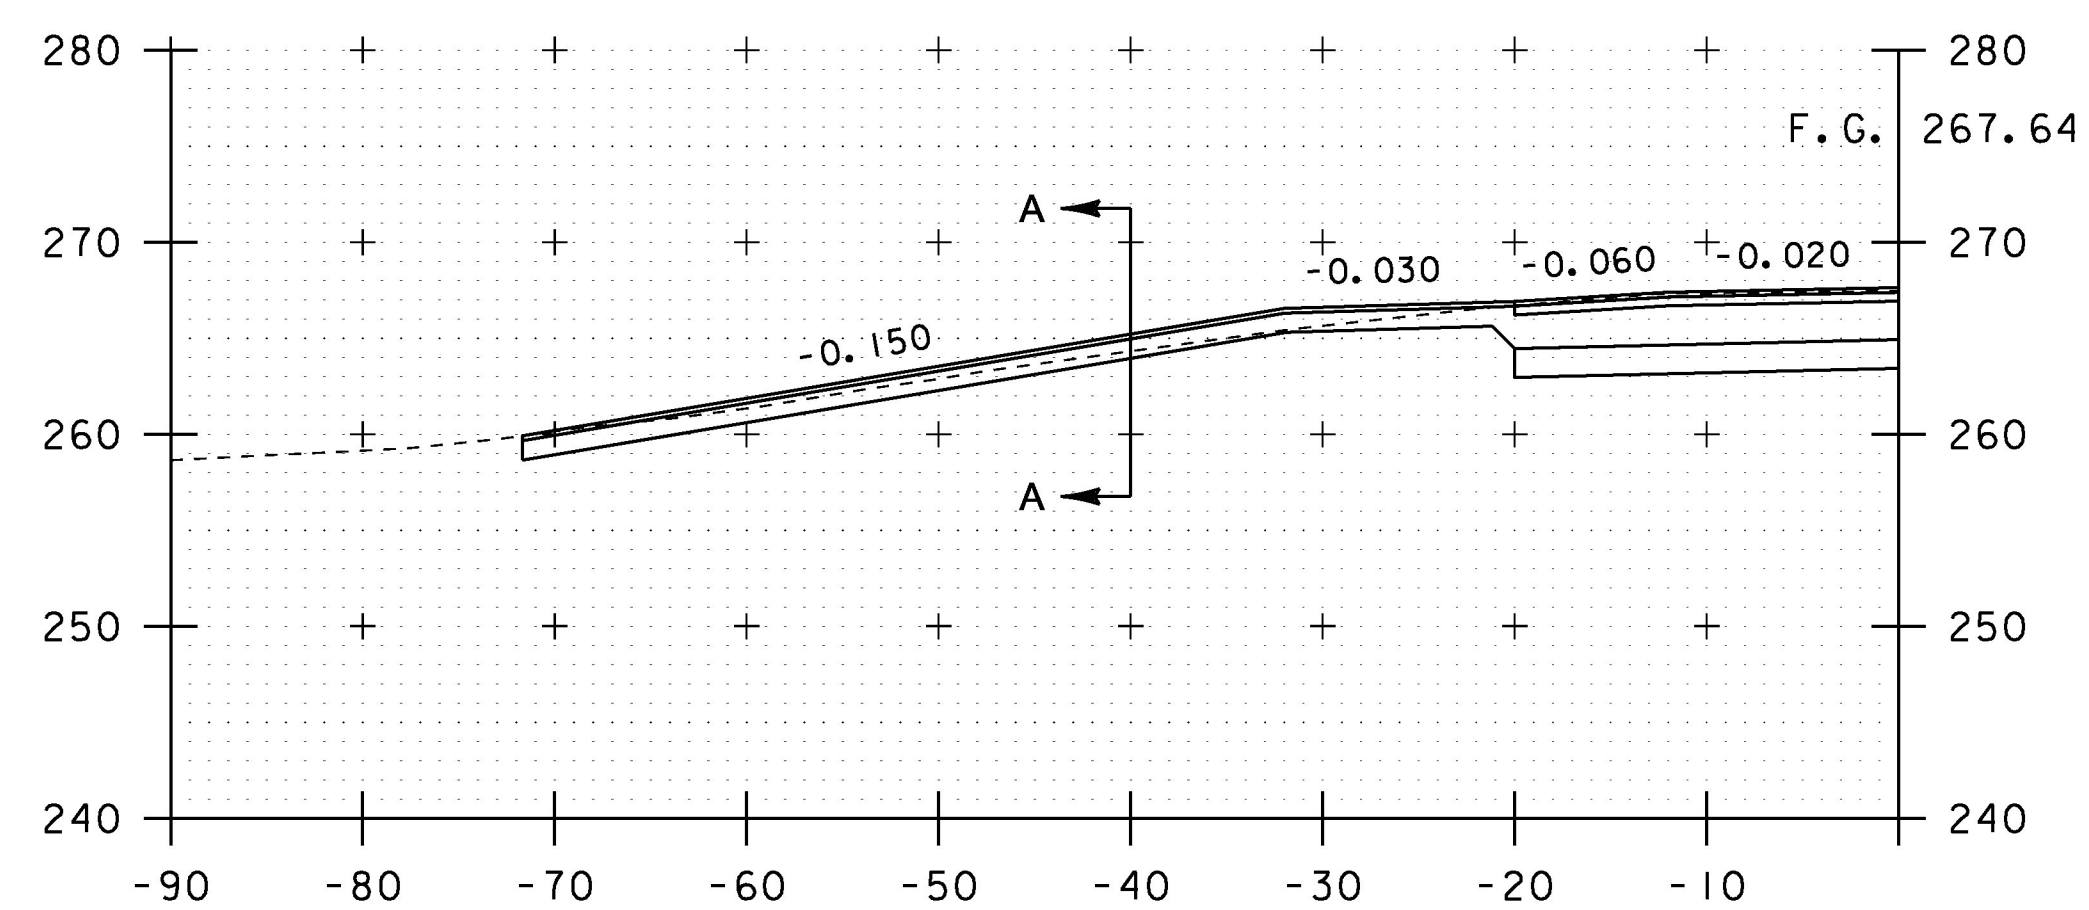

163+72 DRIVE LT

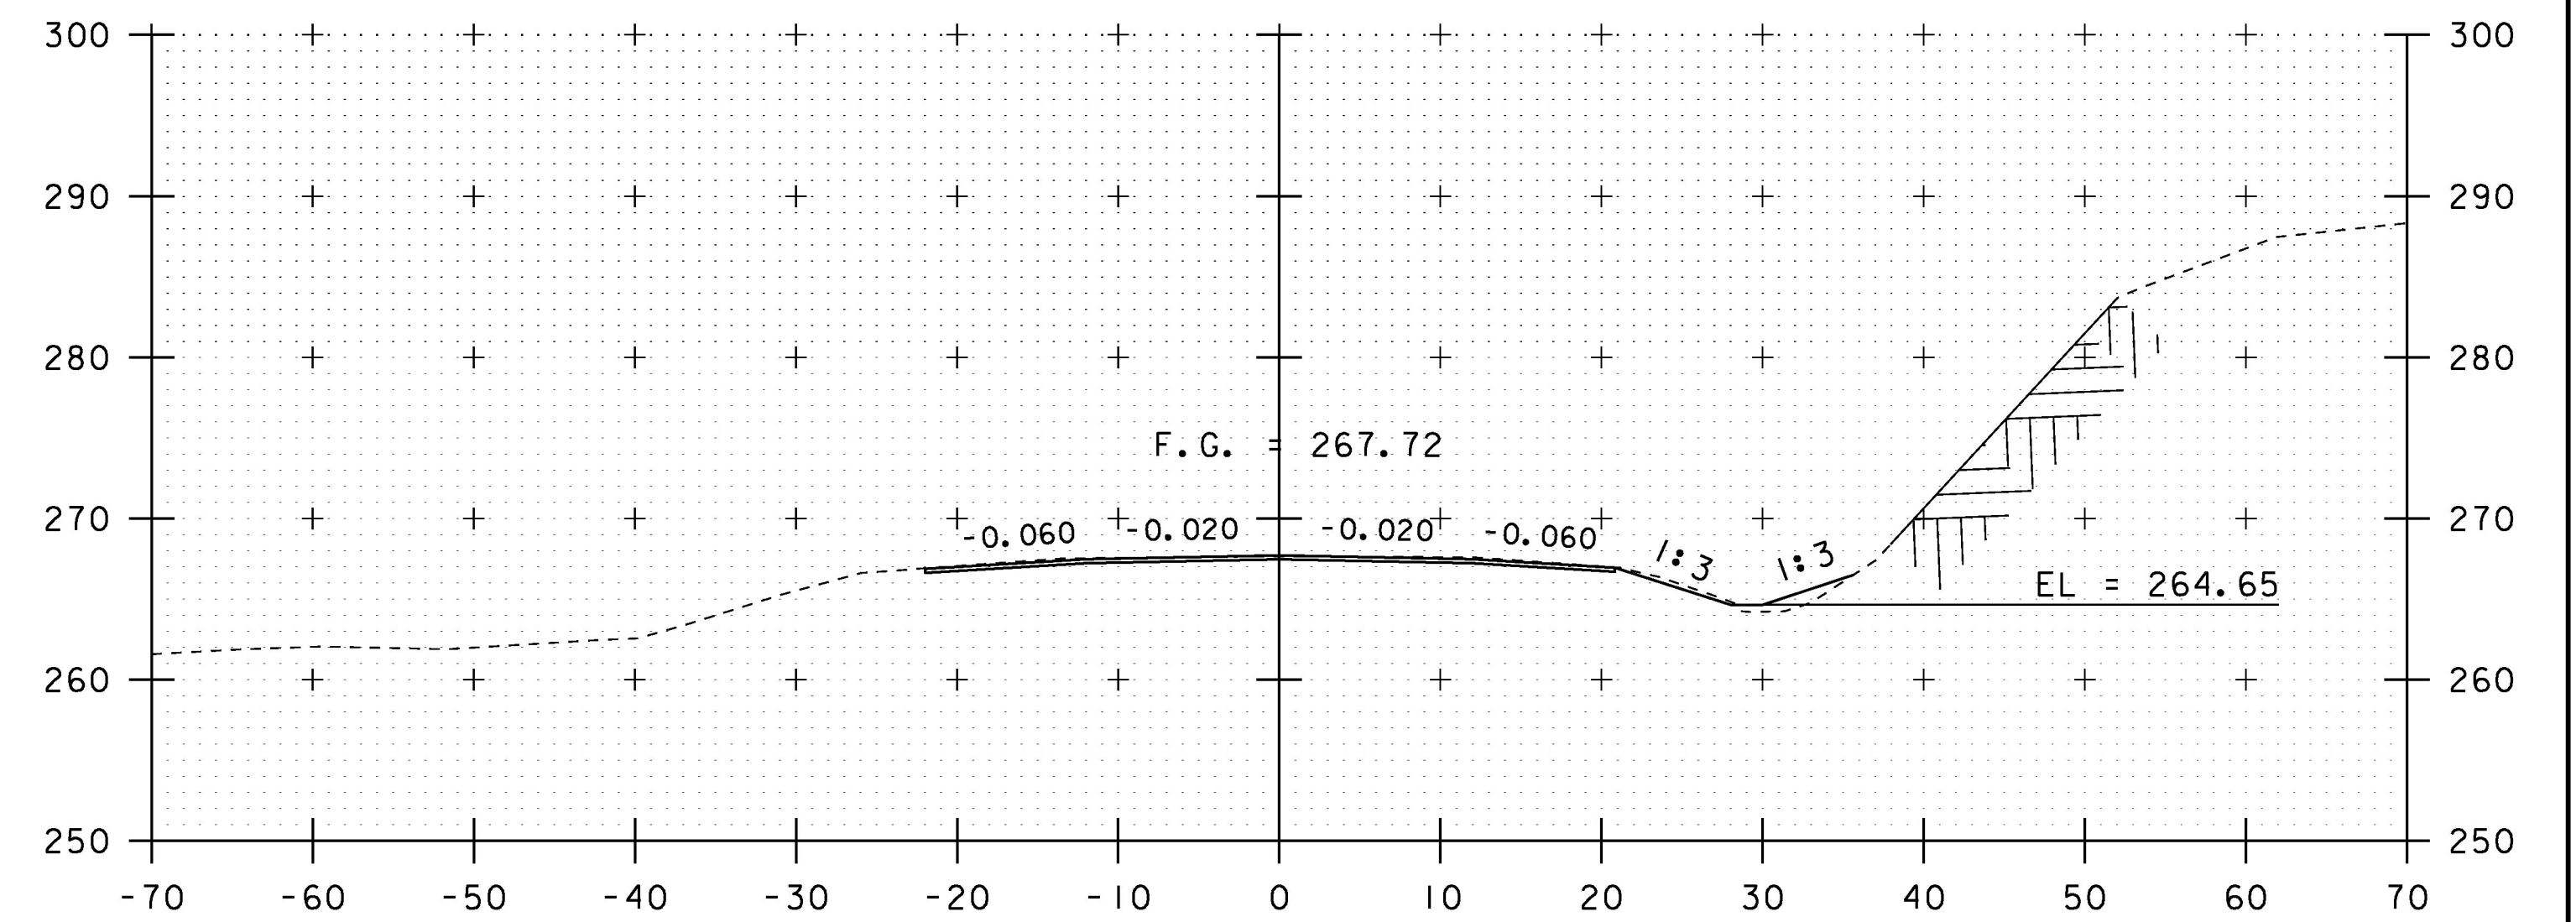

164+50
BEGIN COLD PLANING

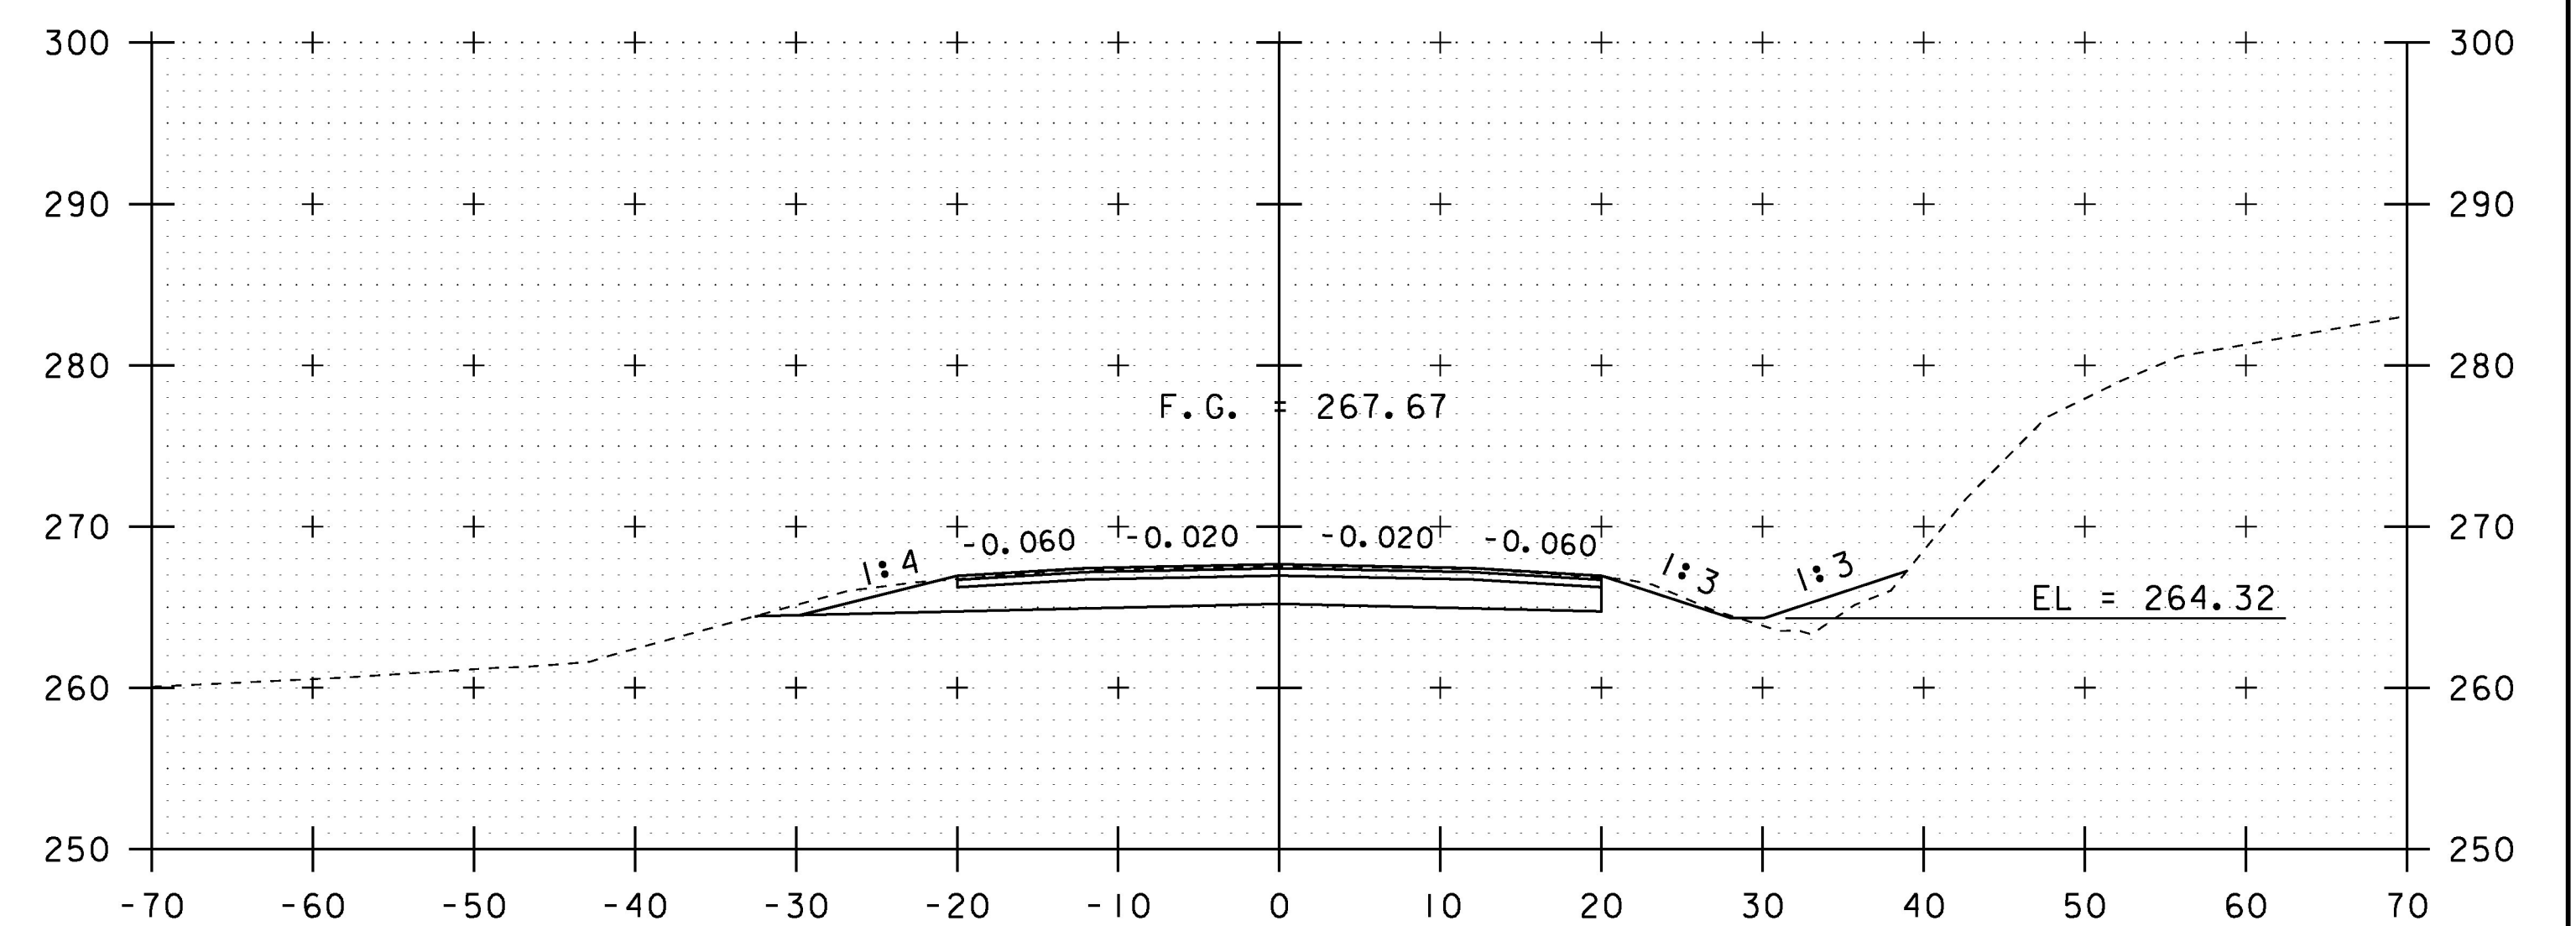

164+00

SCALE IN FEET

STA. 163+72 TO STA. 164+50

PROJECT NAME:	CHARLOTTE
PROJECT NUMBER:	F EGC 019-4(20)
FILE NAME:	d78d062_xs.dgn
PROJECT LEADER:	K. UPMAL
DESIGNED BY:	B. KIPP
MAINLINE CROSS SECTIONS	89
PLOT DATE:	15-MAR-2016
DRAWN BY:	B. KIPP
CHECKED BY:	C. LEACH
SHEET	366 OF 499