




101+25

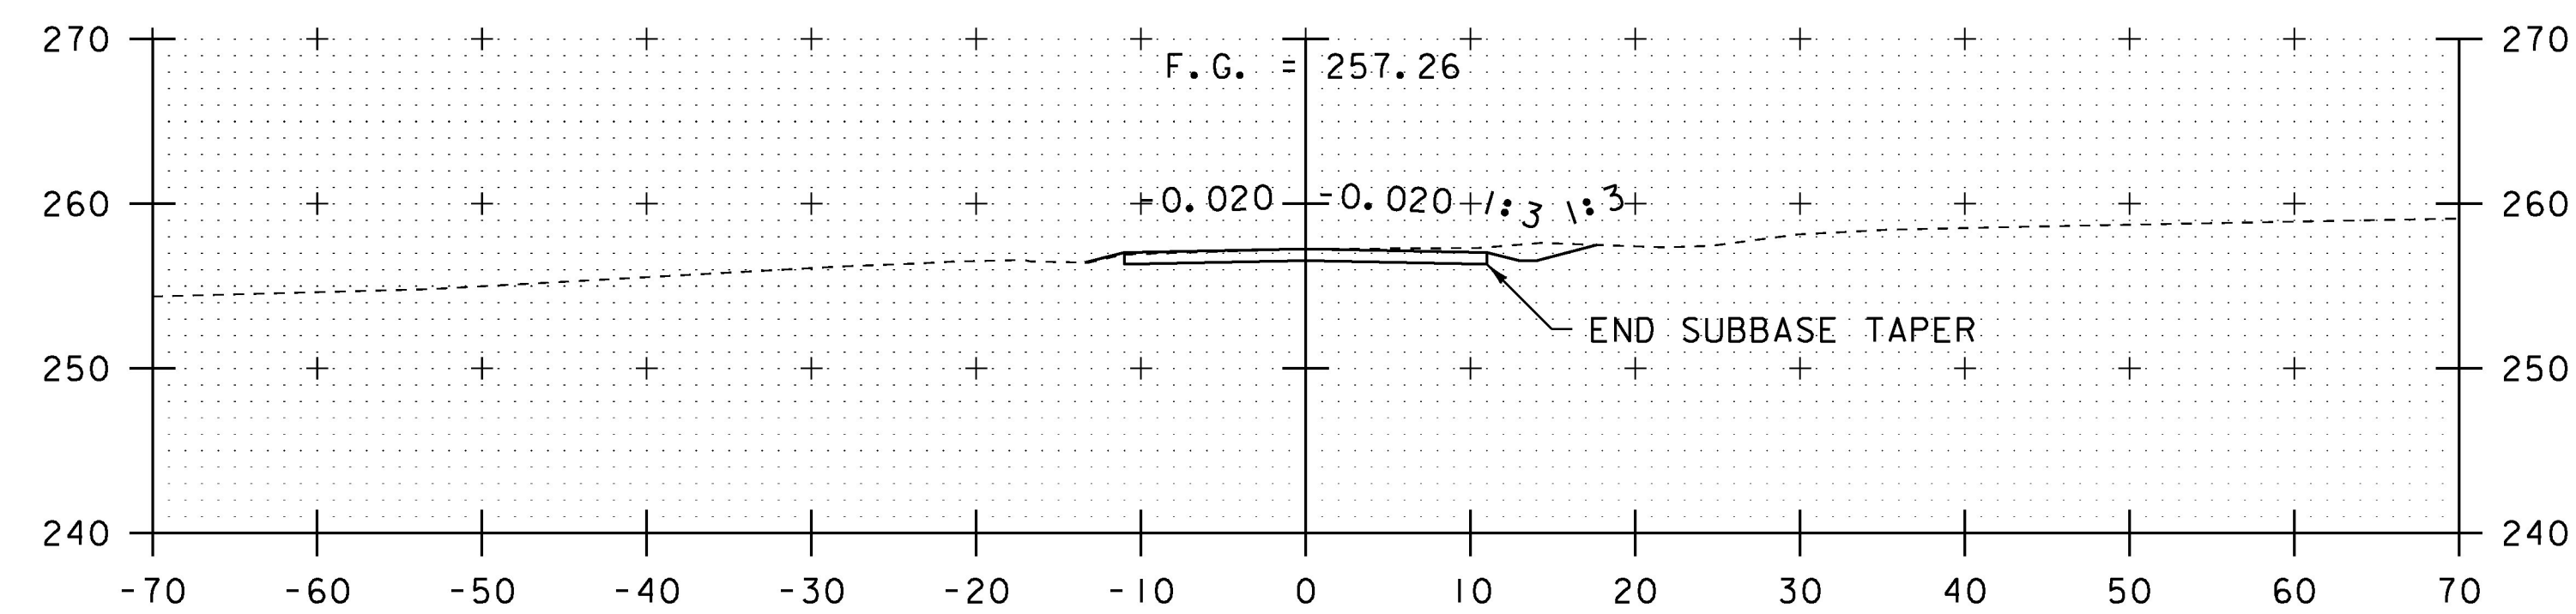


101+08

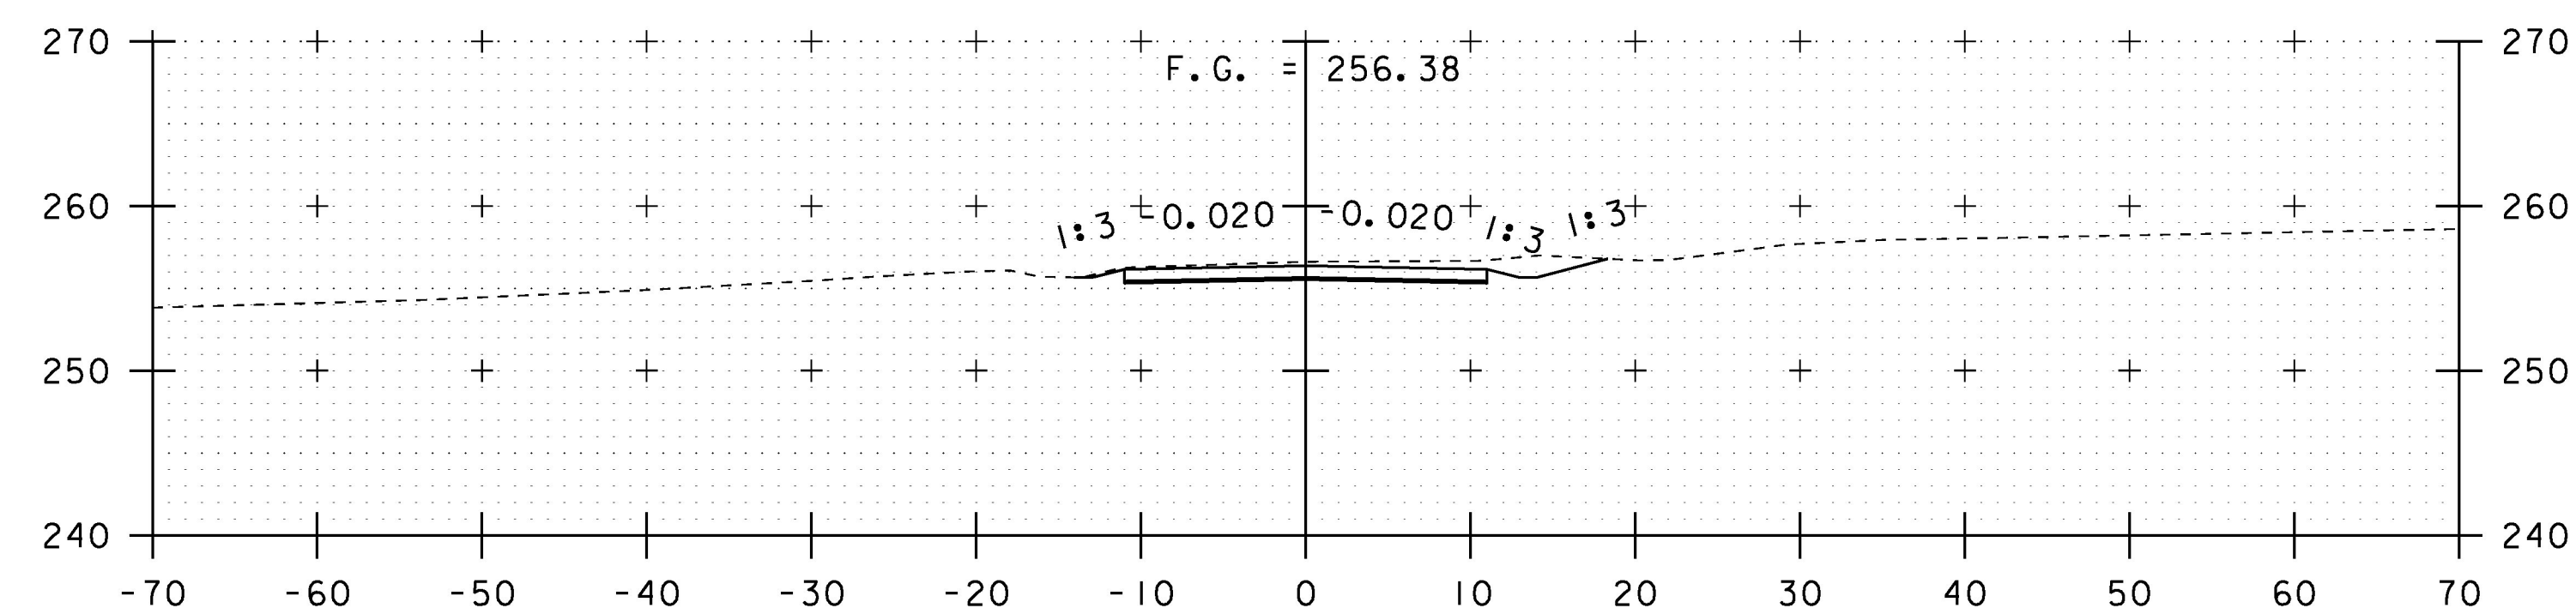


101+00

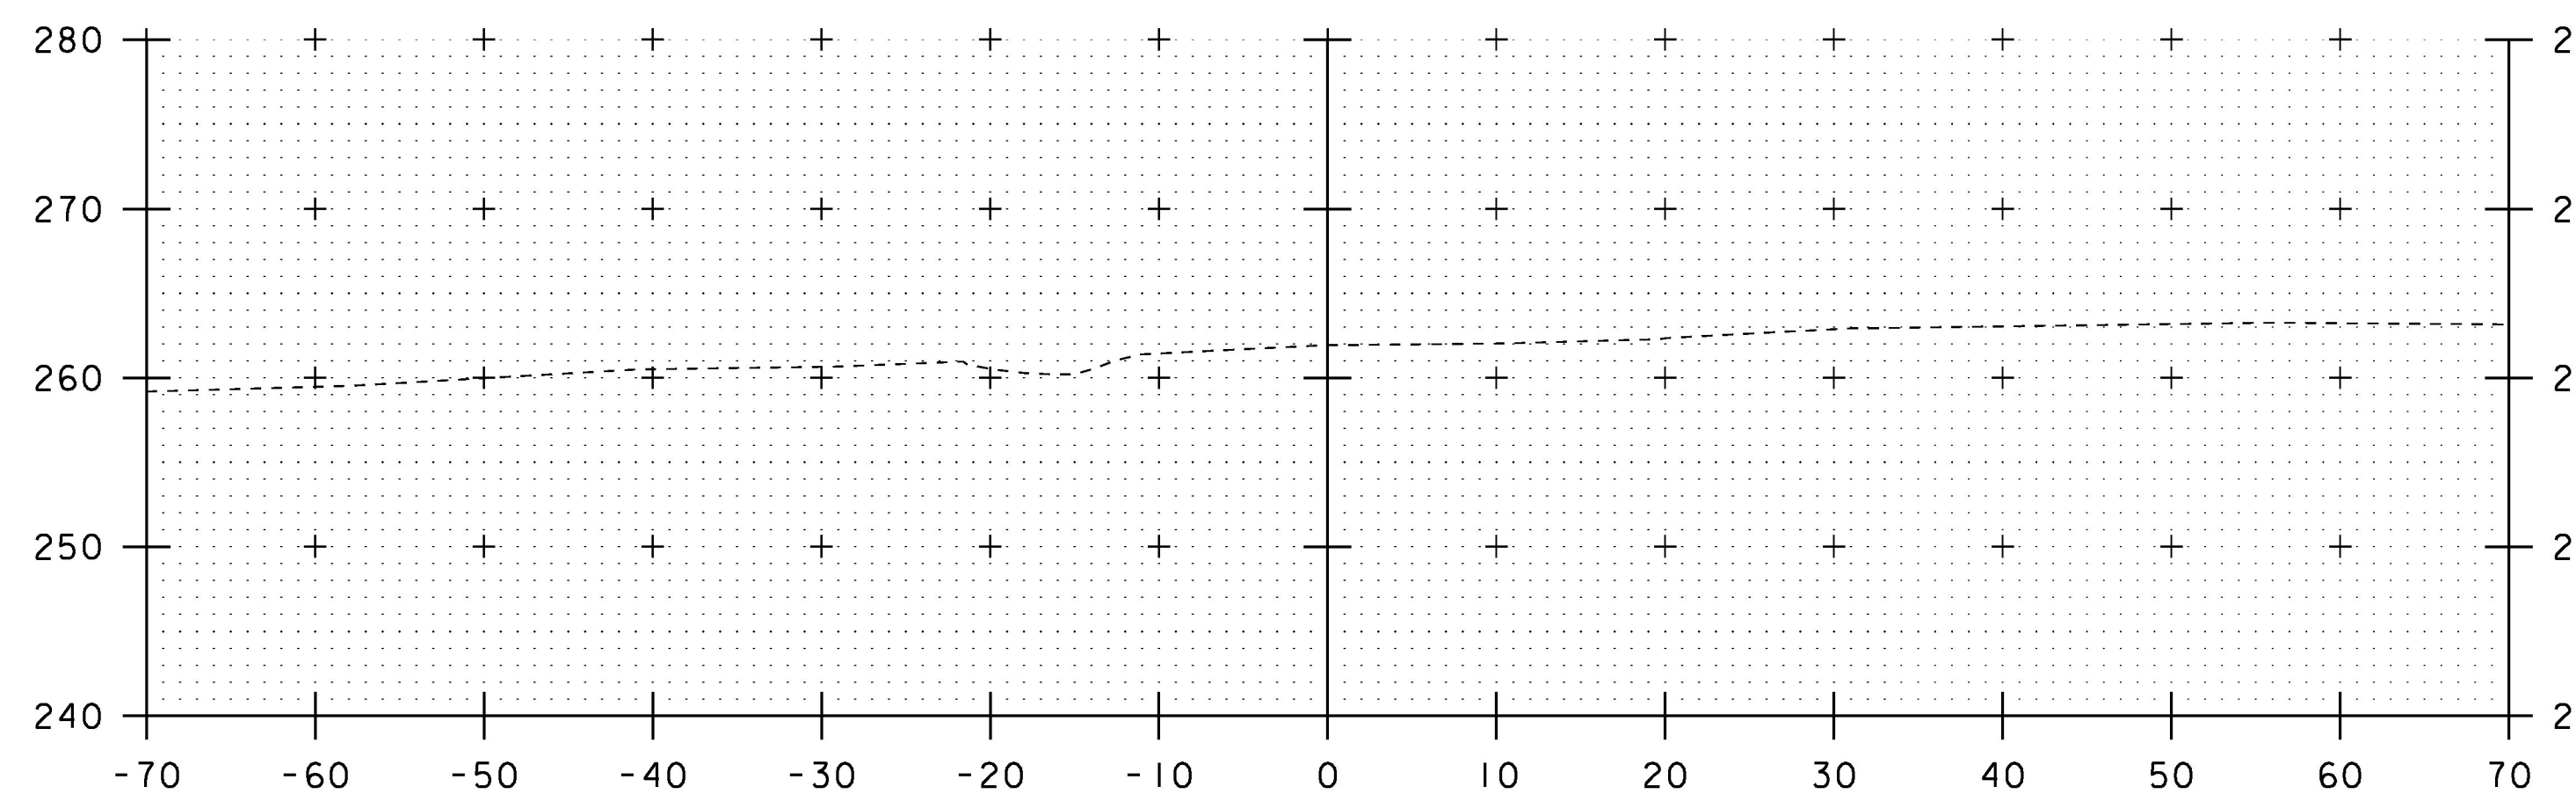


101+75

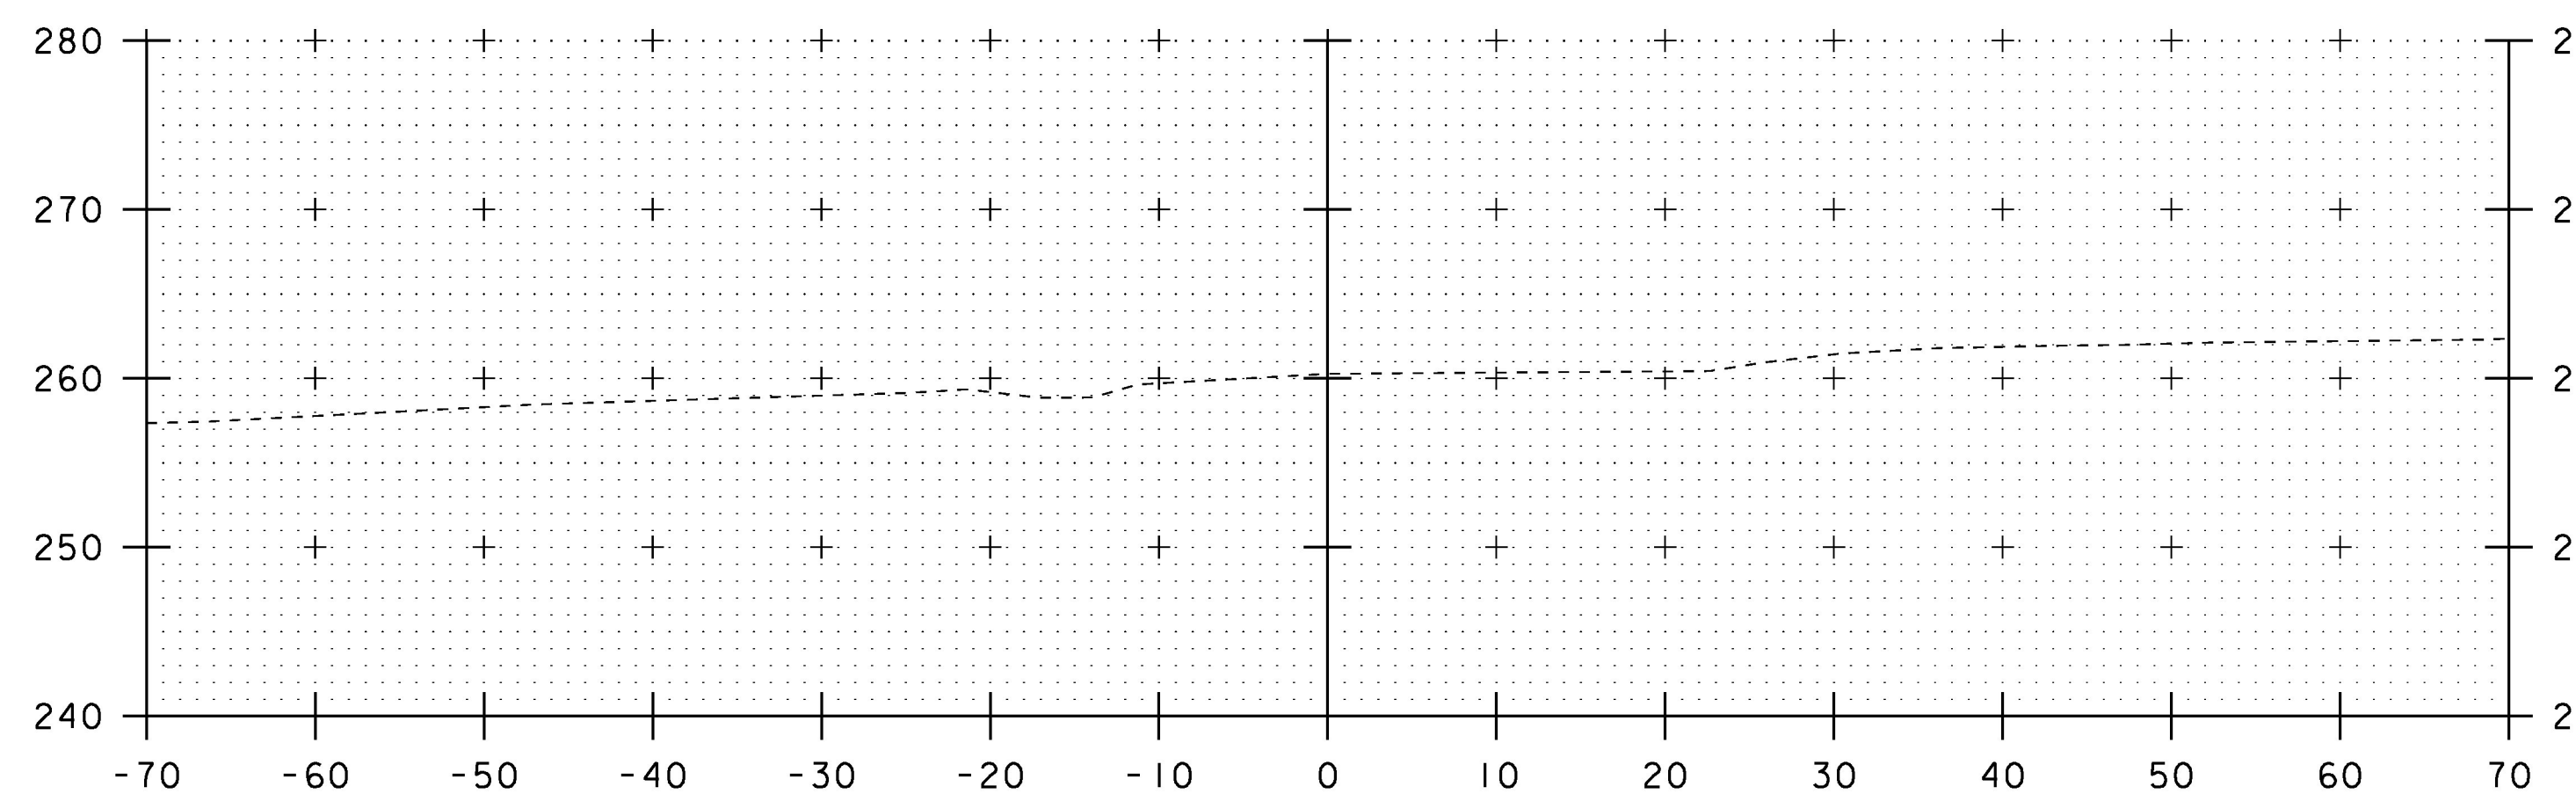

101+50

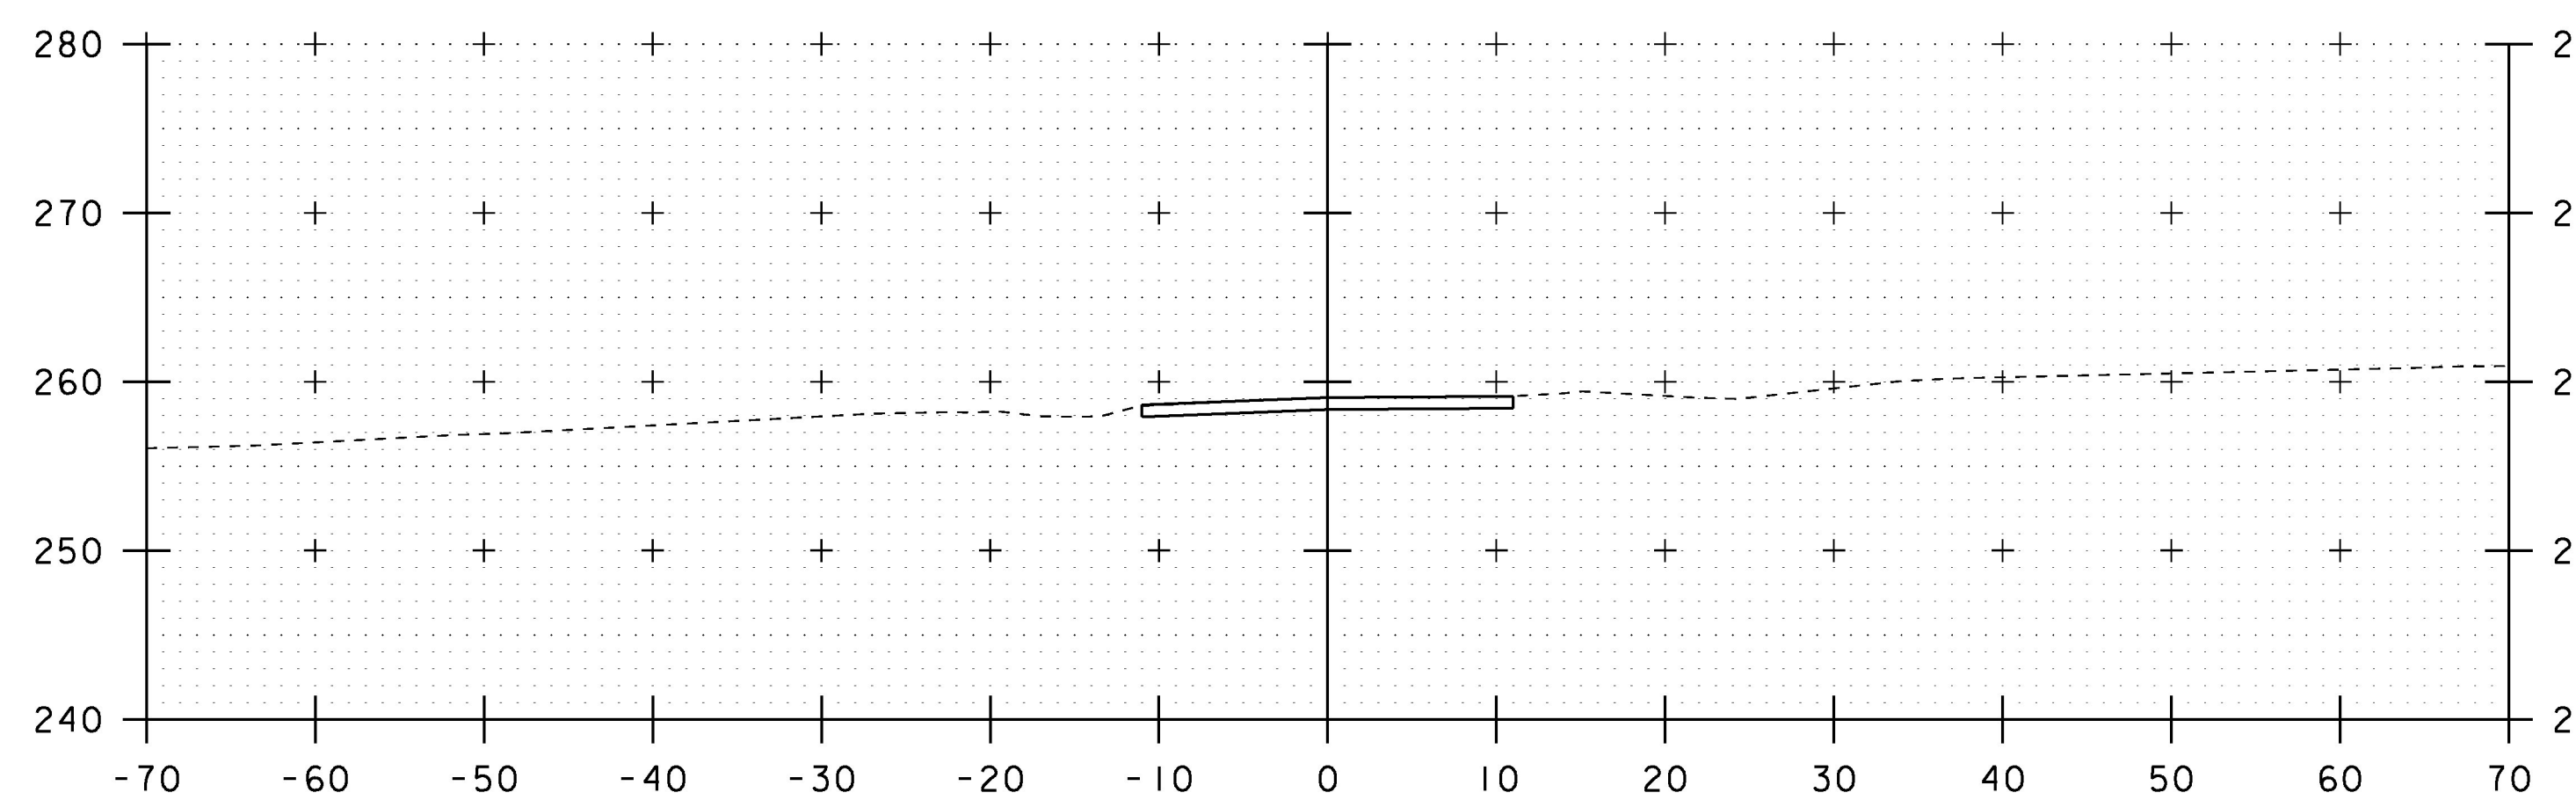

101+33

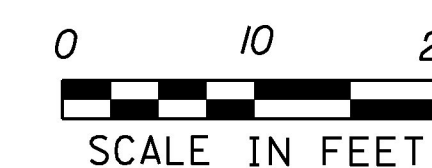

SCALE IN FEET  
STA. 101+00 TO STA. 101+75

PROJECT NAME: CHARLOTTE	PLOT DATE: 15-MAR-2016
PROJECT NUMBER: F EGC 019-4(20)	DRAWN BY: B. KIPP
FILE NAME: d78d062_xs.dgn	CHECKED BY: C. LEACH
PROJECT LEADER: K. UPMAL	SHEET 369 OF 499
DESIGNED BY: B. KIPP	
STATE PARK RD CROSS SECTIONS 2	