


400+00

400+75

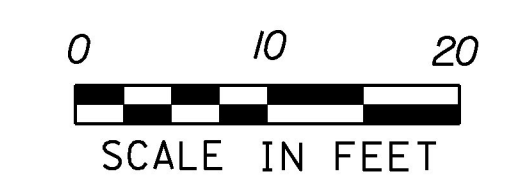

STA. 400+00 TO STA. 401+00

PROJECT NAME: CHARLOTTE	PLOT DATE: 15-MAR-2016
PROJECT NUMBER: F EGC 019-4(20)	DRAWN BY: B. KIPP
FILE NAME: d78d062_xs.dgn	CHECKED BY: C. LEACH
DESIGNED BY: B. KIPP	
DRIVE 63+09 ALIGNMENT CROSS SECTIONS SHEET 374 OF 499	