




500+50

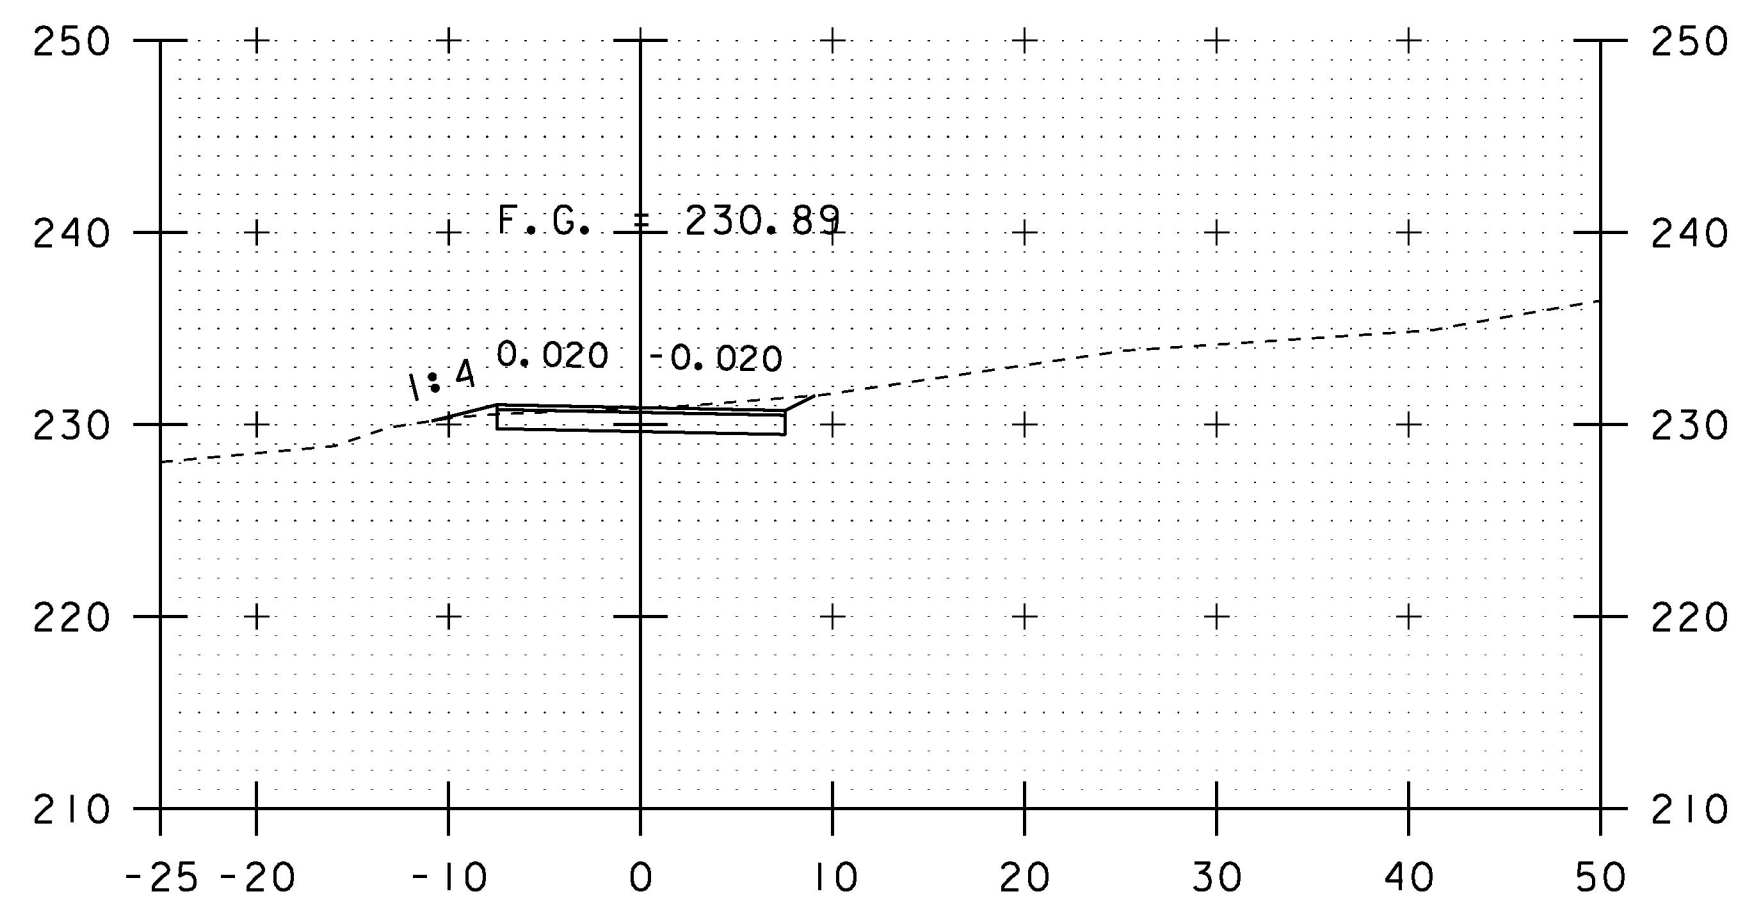


500+25

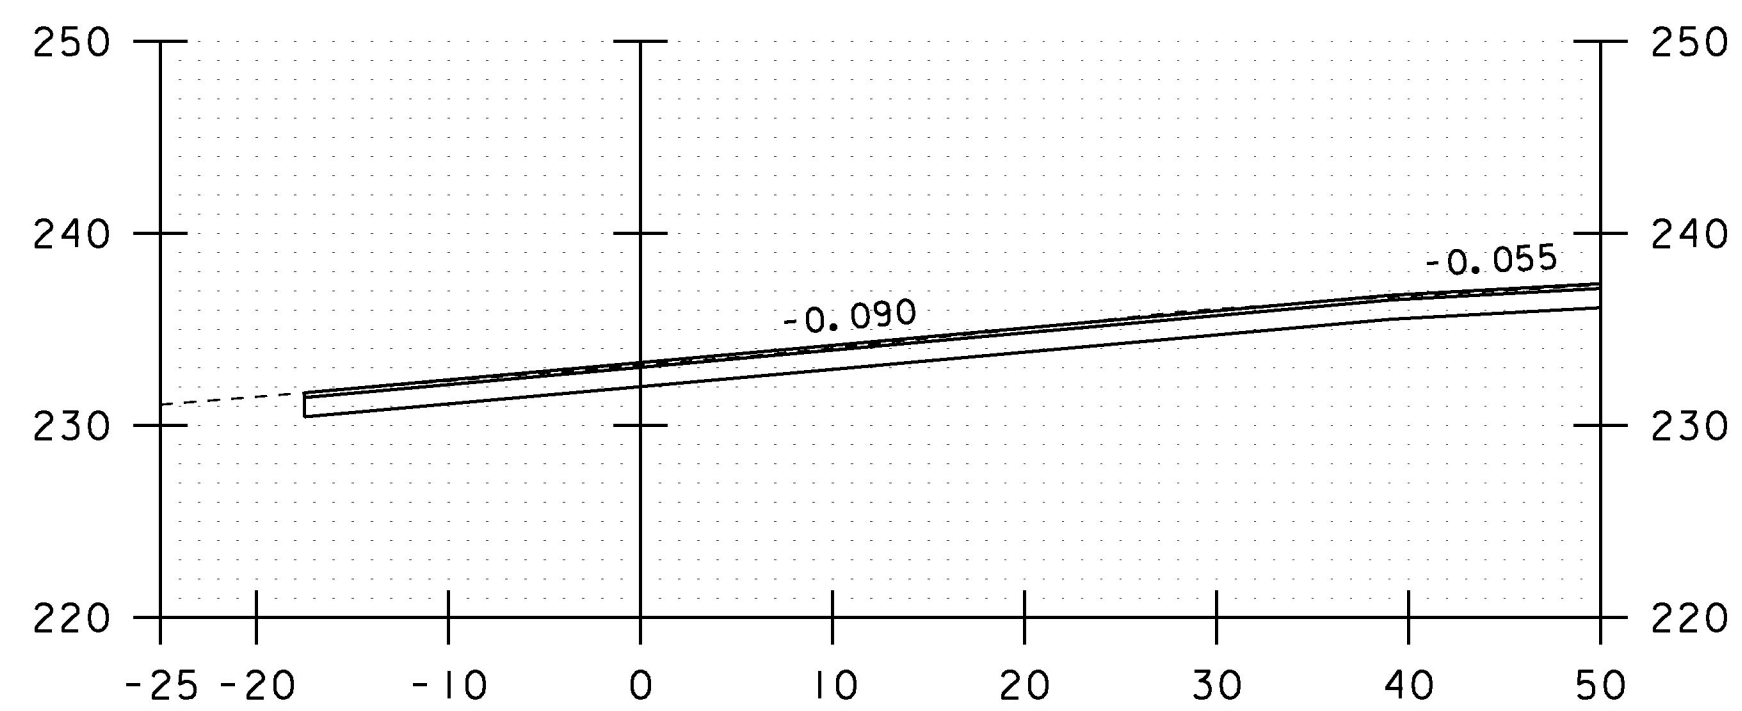


500+00

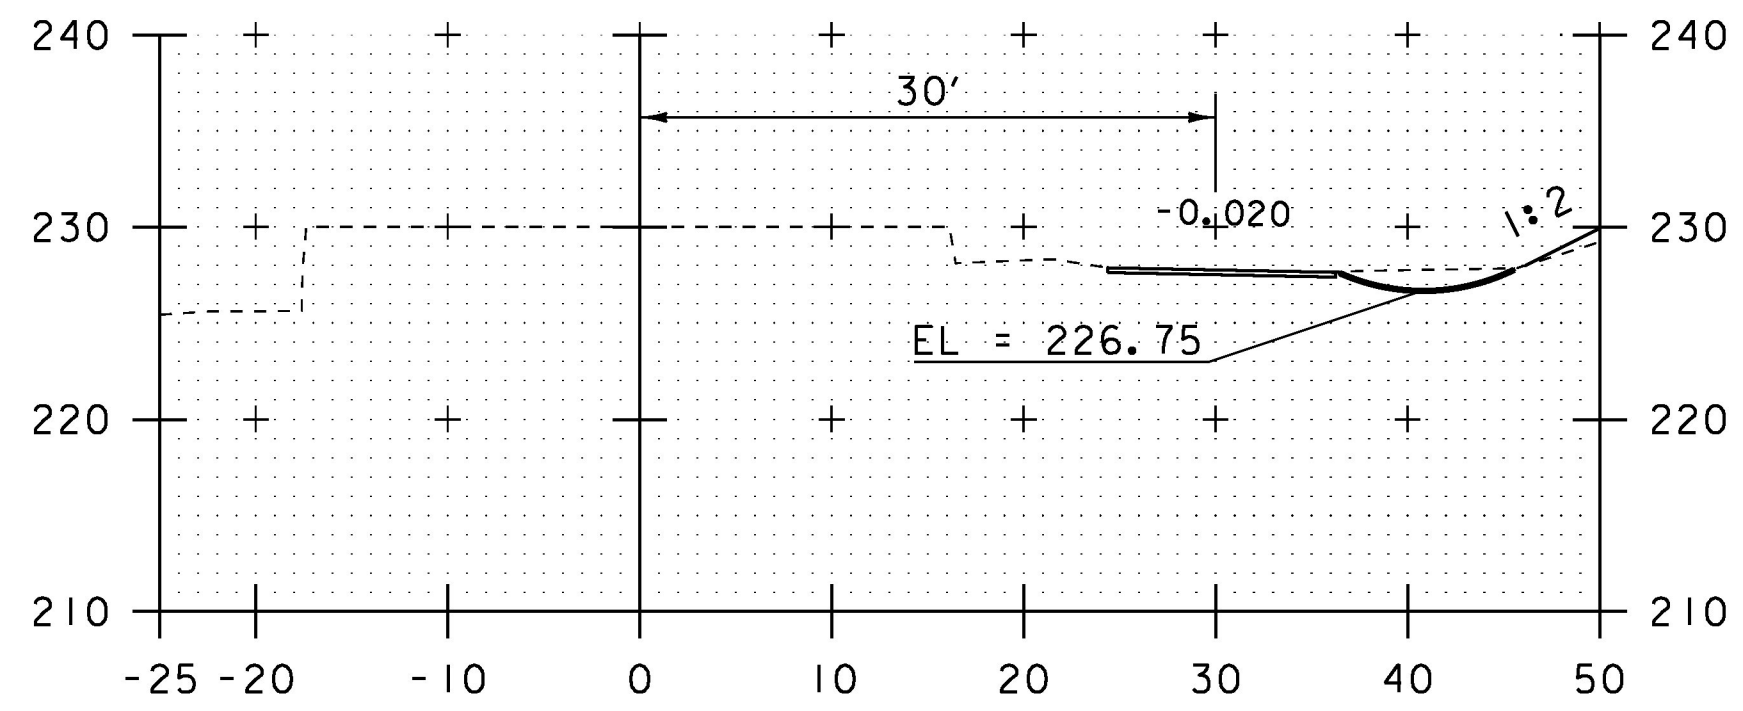


501+25

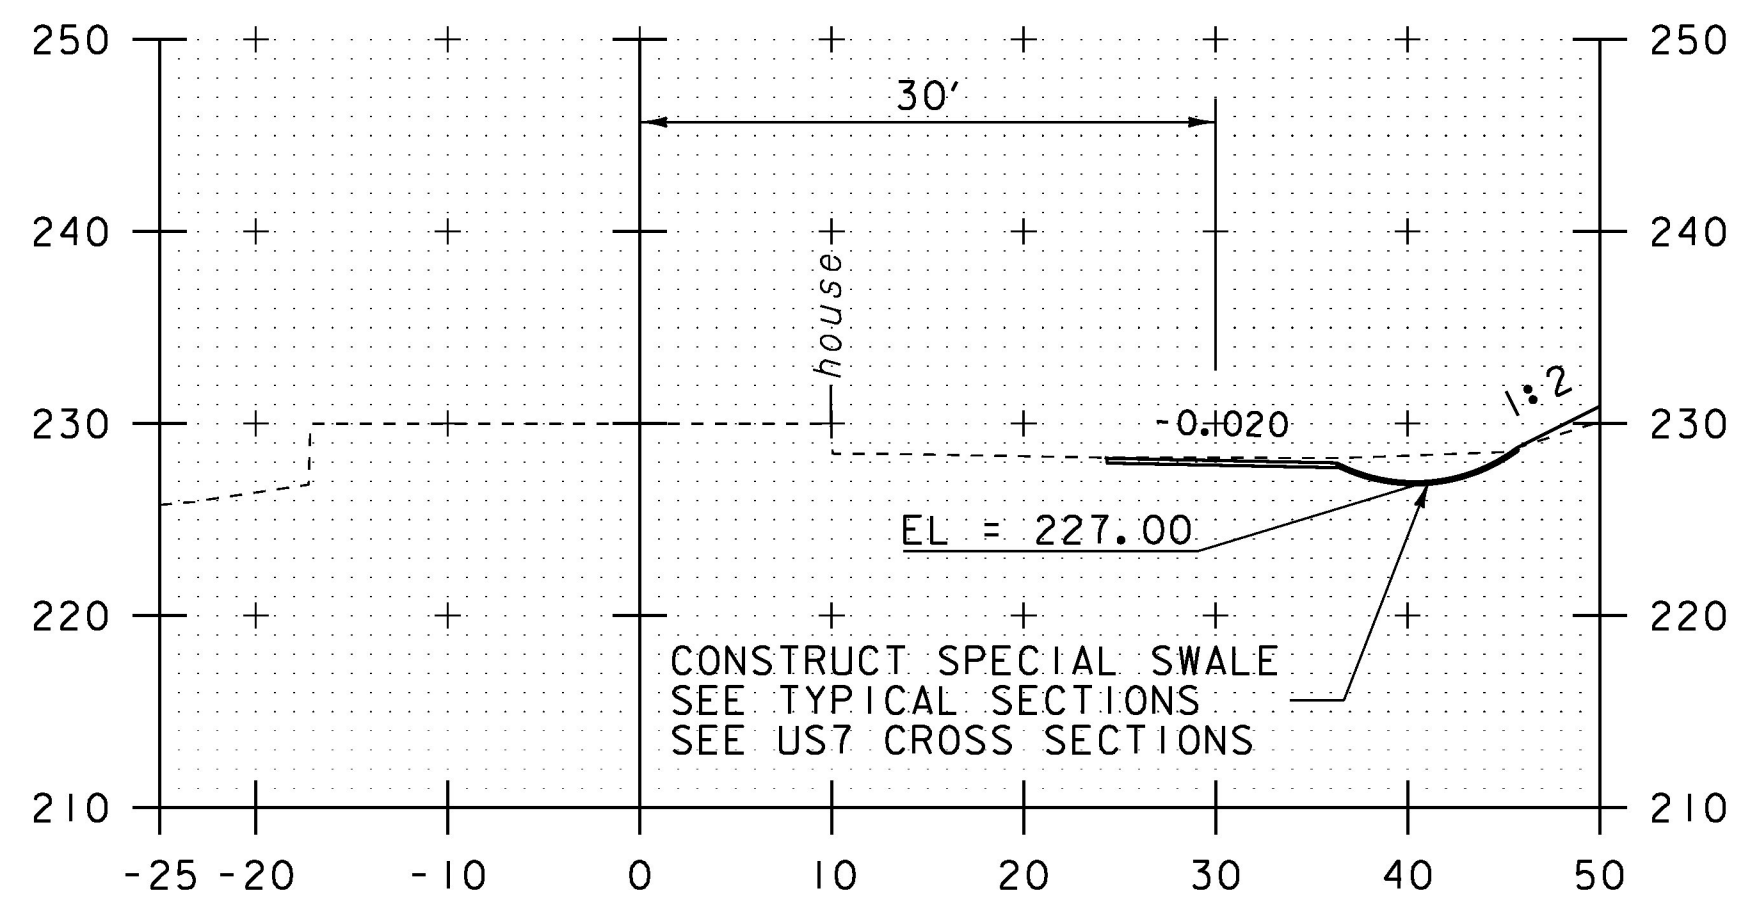


501+00

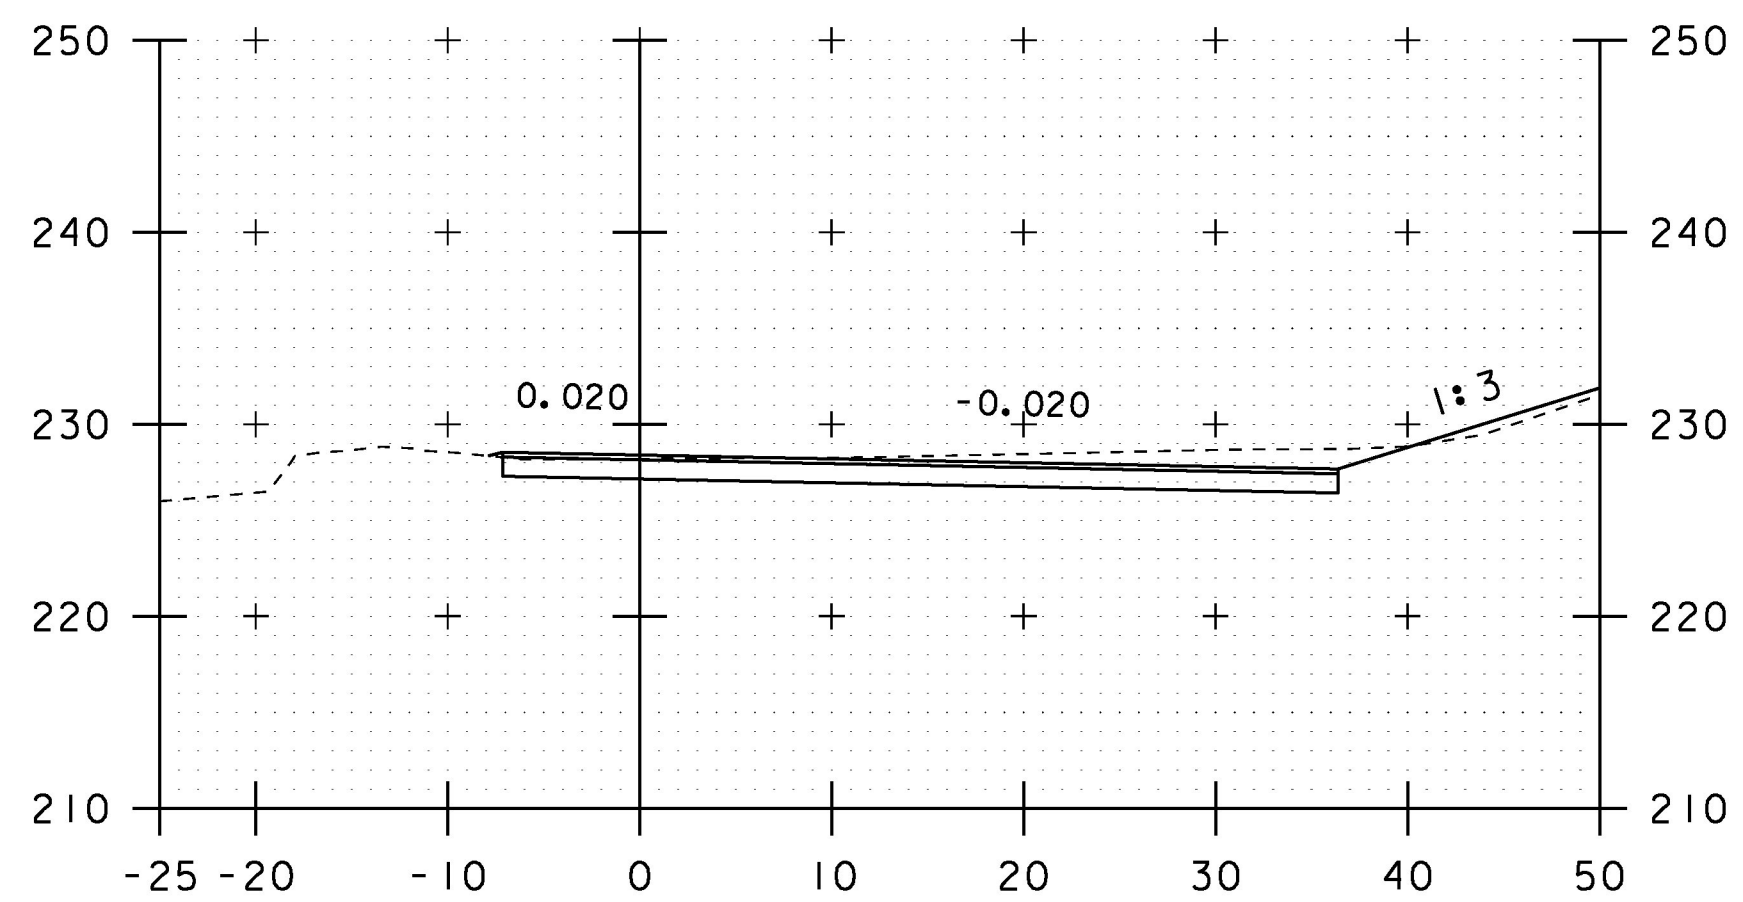

500+75

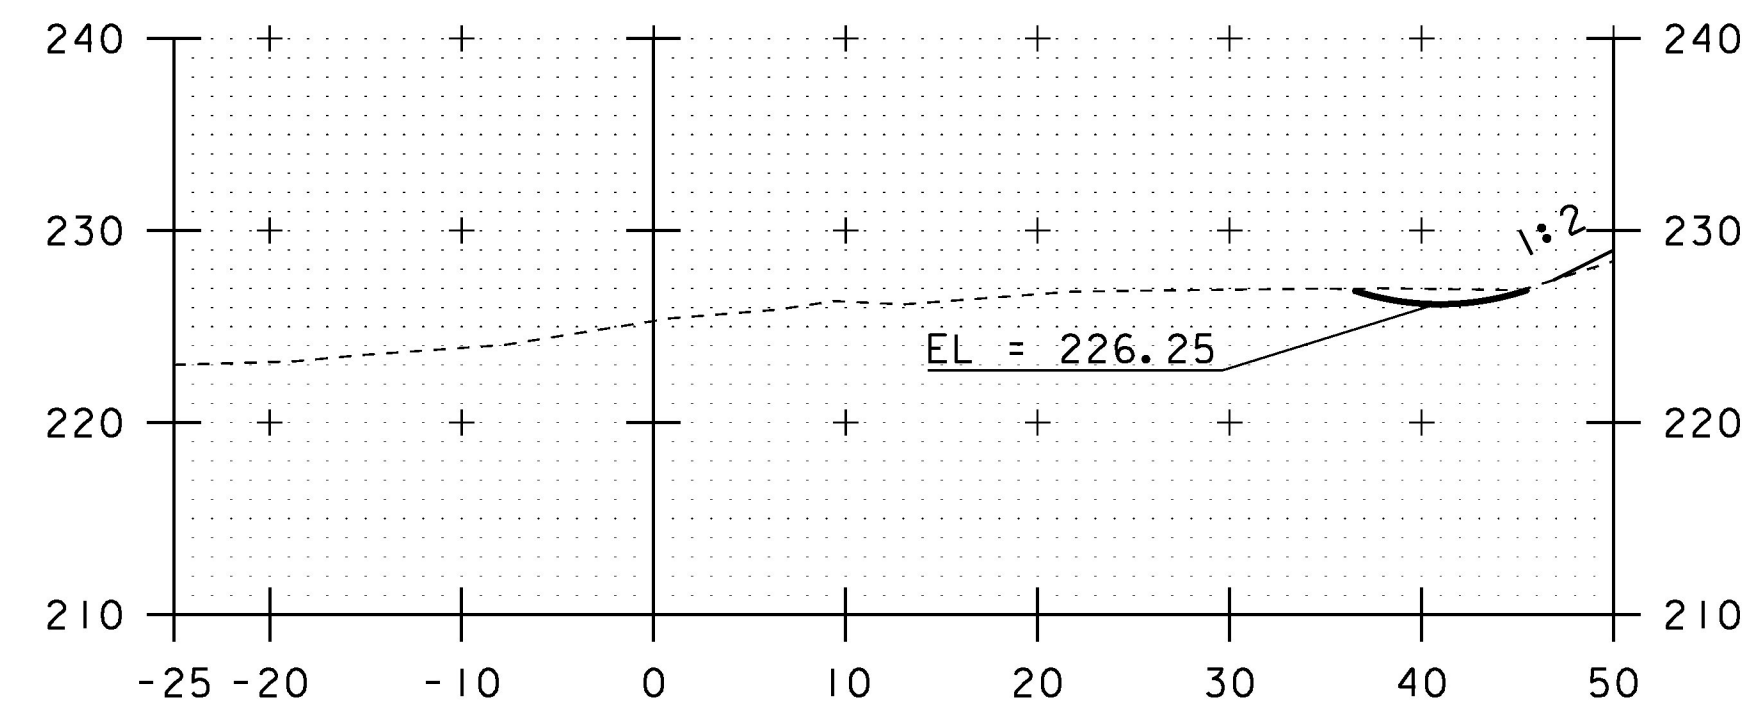

501+50

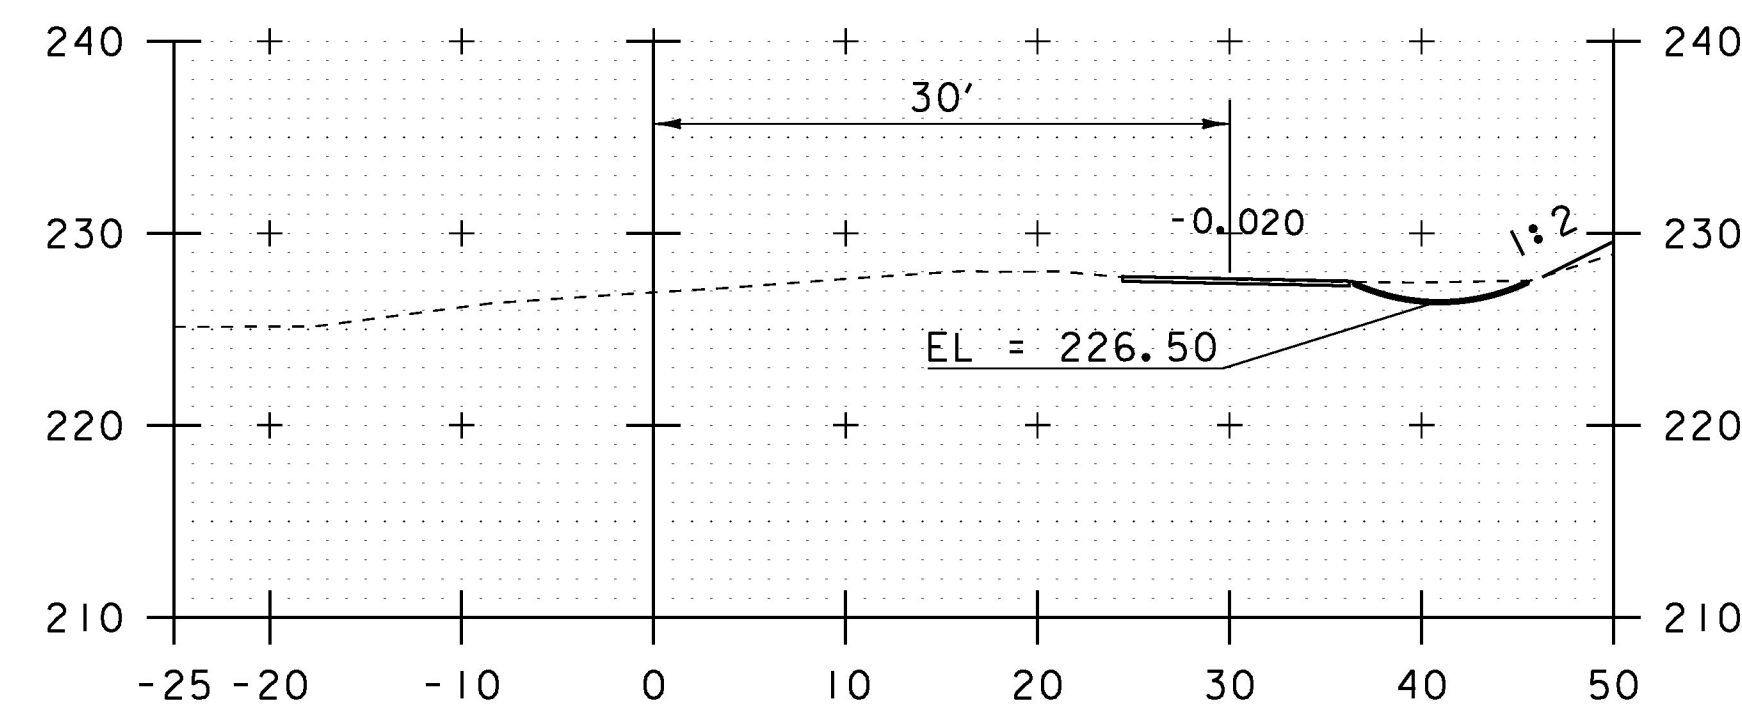

501+34



SCALE IN FEET
STA. 500+00 TO STA. 501+50

PROJECT NAME: CHARLOTTE
PROJECT NUMBER: F EGC 019-4(20)

FILE NAME: d78d062_xs.dgn
PROJECT LEADER: K. UPMAL
DESIGNED BY: B. KIPP
DRAWN BY: B. KIPP
CHECKED BY: C. LEACH
PLOT DATE: 15-MAR-2016
DRIVE 63+09 ALIGNMENT 2 CROSS SECTIONS | SHEET 375 OF 499