


LEGEND	
	PHASE I CONSTRUCTION
	PHASE I TRAFFIC
	SSL SINGLE SOLID WHITE LINE 4 INCHES WIDE
	DSL DOUBLE SOLID YELLOW LINE 4 INCHES WIDE

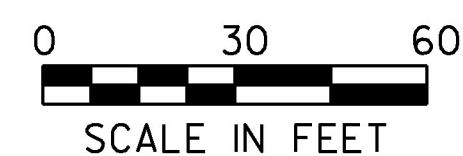

PROJECT NAME:	CHARLOTTE
PROJECT NUMBER:	F EGC 019-4(20)
FILE NAME:	d78d062_fc_1.bdr.dgn
PROJECT LEADER:	K. UPMAL
DESIGNED BY:	B. KIPP
PHASE I TRAFFIC CONTROL PLAN LAYOUT 2	
PLOT DATE:	15-MAR-2016
DRAWN BY:	B. KIPP
CHECKED BY:	C. LEACH
SHEET	379 OF 499