


LEGEND	
	PHASE I CONSTRUCTION
	PHASE I TRAFFIC
	SSL SINGLE SOLID WHITE LINE 4 INCHES WIDE
	DSL DOUBLE SOLID YELLOW LINE 4 INCHES WIDE

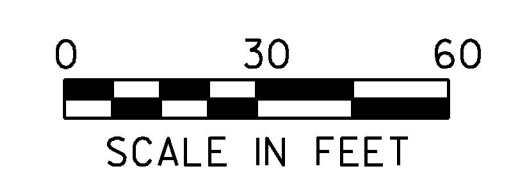

PROJECT NAME: CHARLOTTE	
PROJECT NUMBER: F EGC 019-4(20)	
FILE NAME: d78d062_fc_2.bdr.dgn	PLOT DATE: 15-MAR-2016
PROJECT LEADER: K. UPMAL	DRAWN BY: B. KIPP
DESIGNED BY: B. KIPP	CHECKED BY: C. LEACH
PHASE II TRAFFIC CONTROL PLAN LAYOUT 9	SHEET 406 OF 499