




41+50

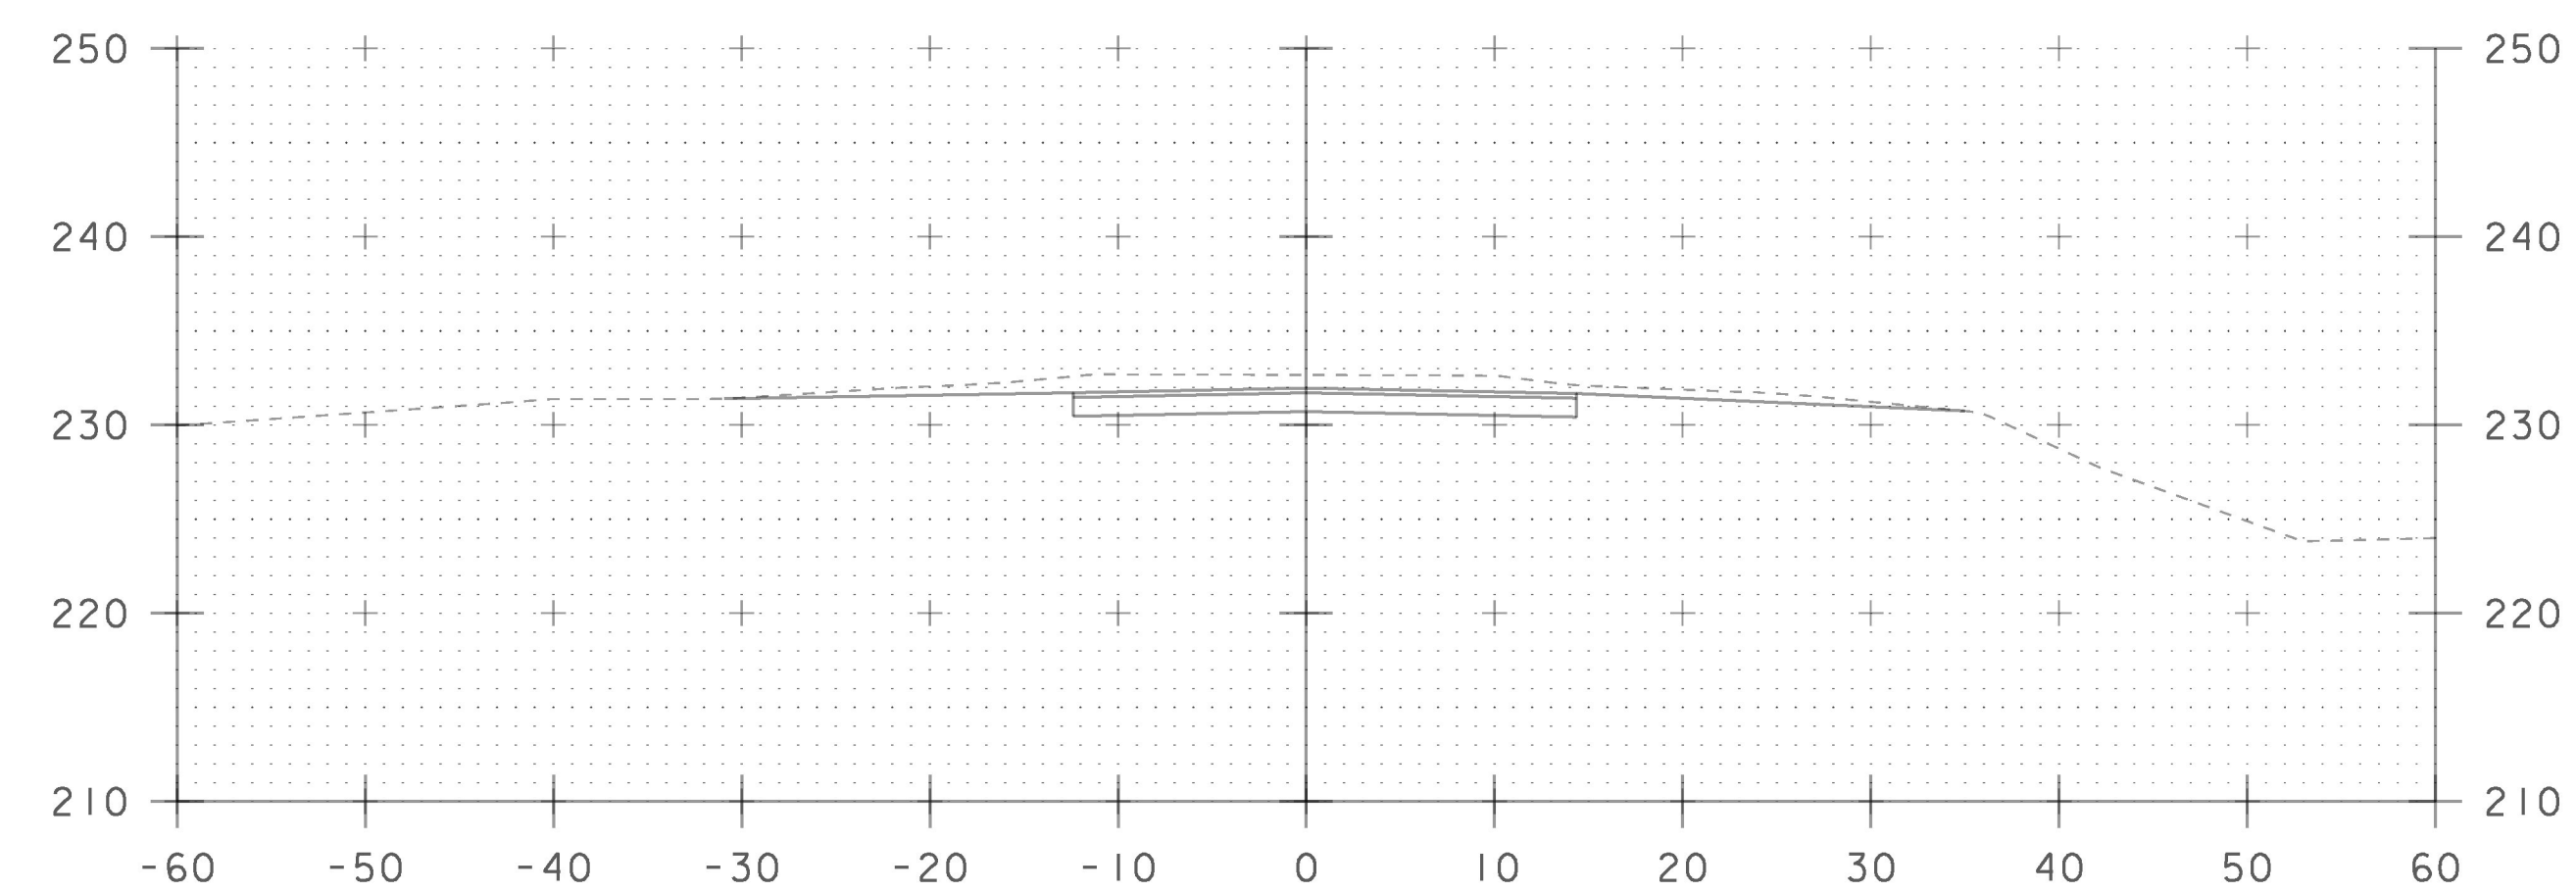

41+69 DRIVE LT SECTION A-A
(CHAFLIN FARM RD.)

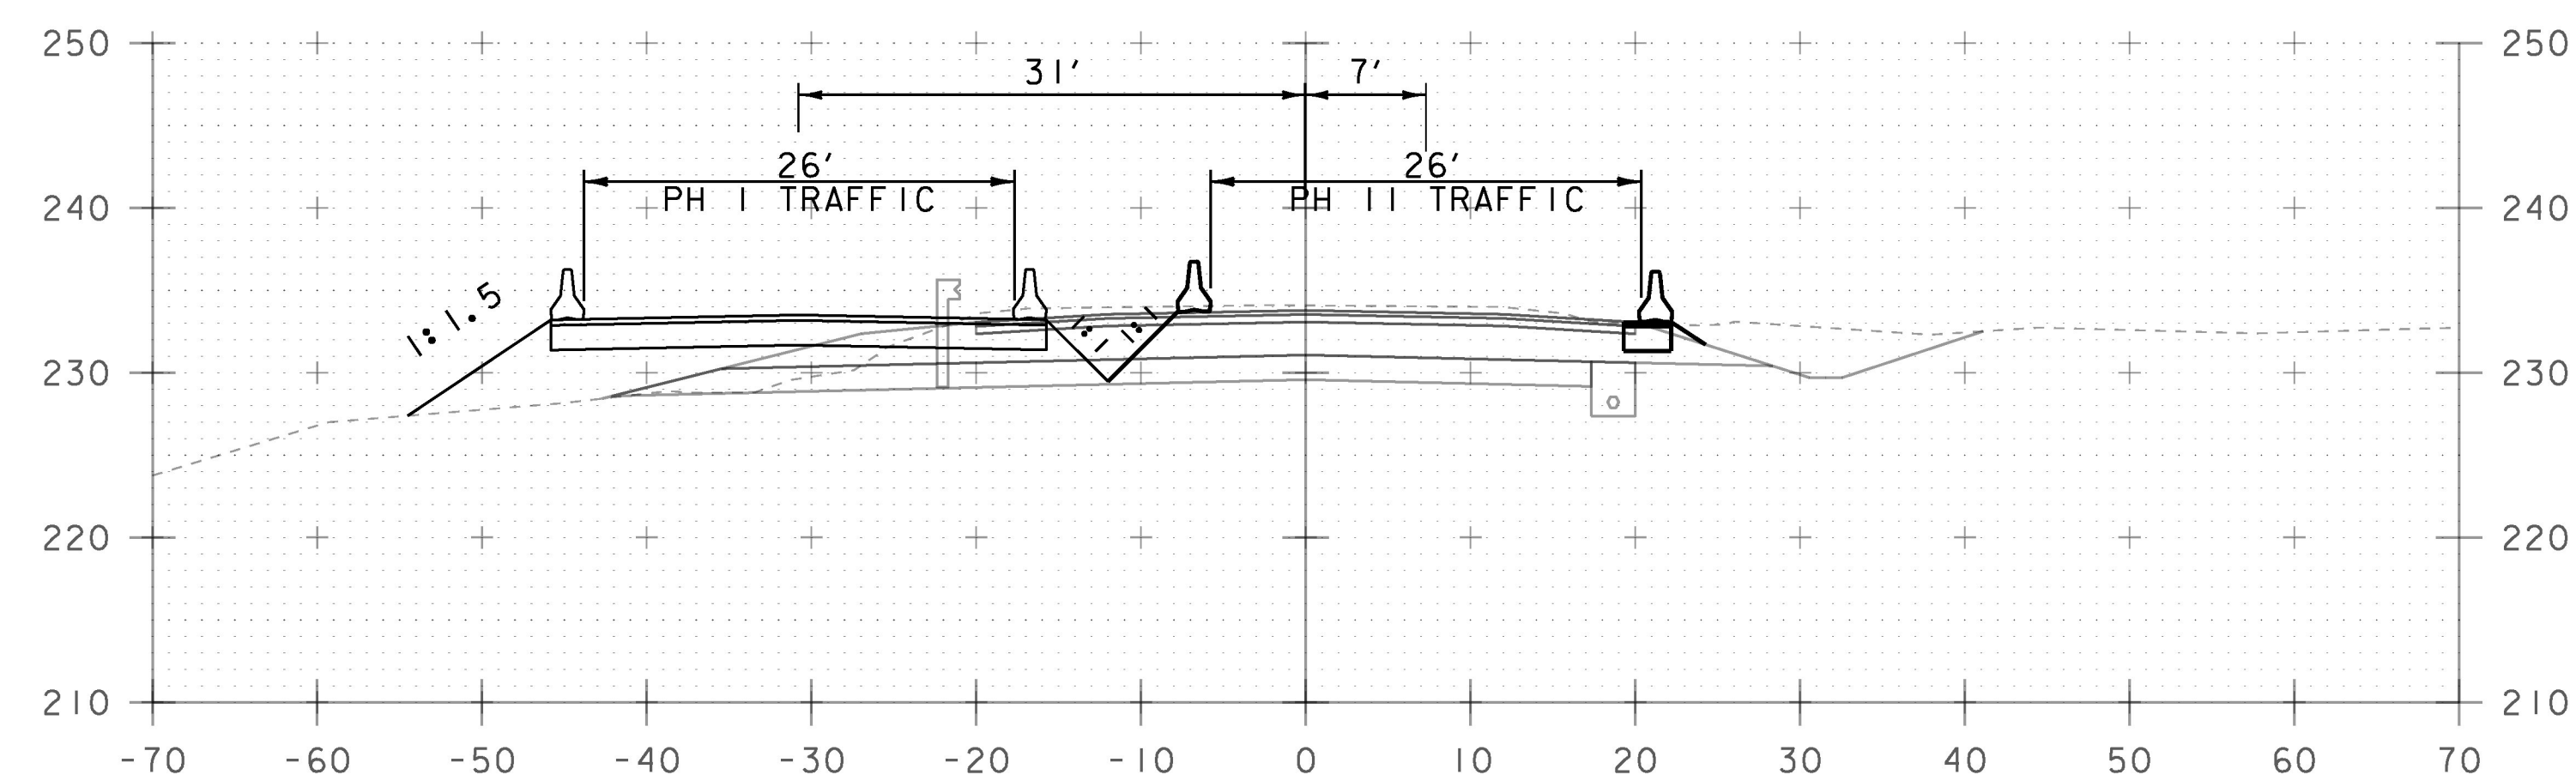

41+00

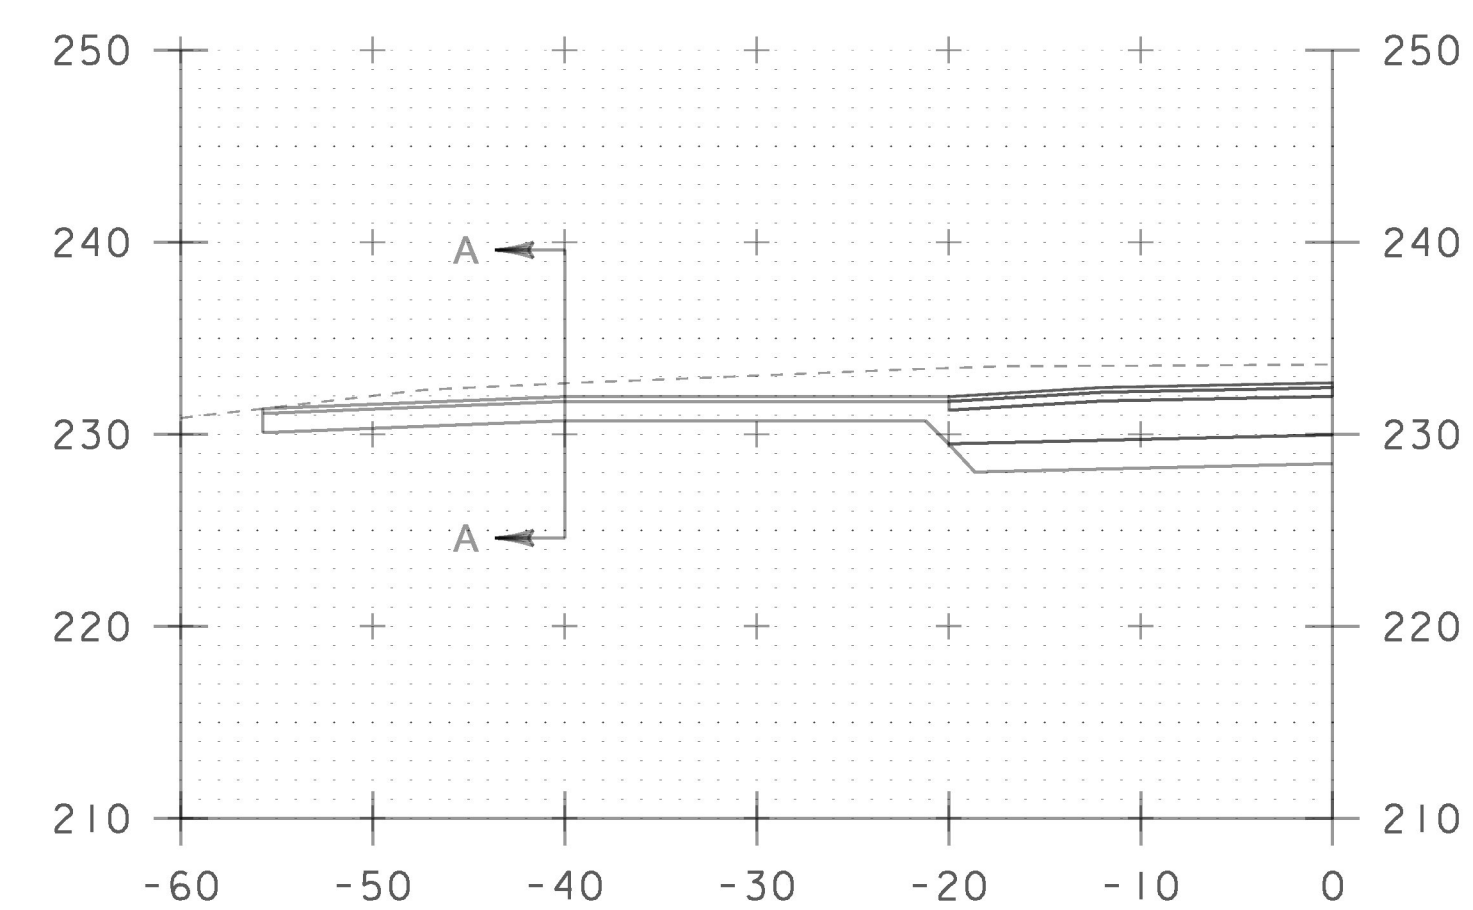

41+69 DRIVE LT
(CHAFLIN FARM RD.)

STA. 41+00 TO STA. 41+69

PROJECT NAME:	CHARLOTTE	PLOT DATE:	15-MAR-2016
PROJECT NUMBER:	F EGC 019-4(20)	DRAWN BY:	B. KIPP
FILE NAME:	d78d062_fc_xs.dgn	CHECKED BY:	A. BOMBARDIER
PROJECT LEADER:	K. UPMAL	TRAFFIC CONTROL CROSS SECTIONS 18	SHEET 435 OF 499
DESIGNED BY:	B. KIPP		