




55+06 DRIVE RT

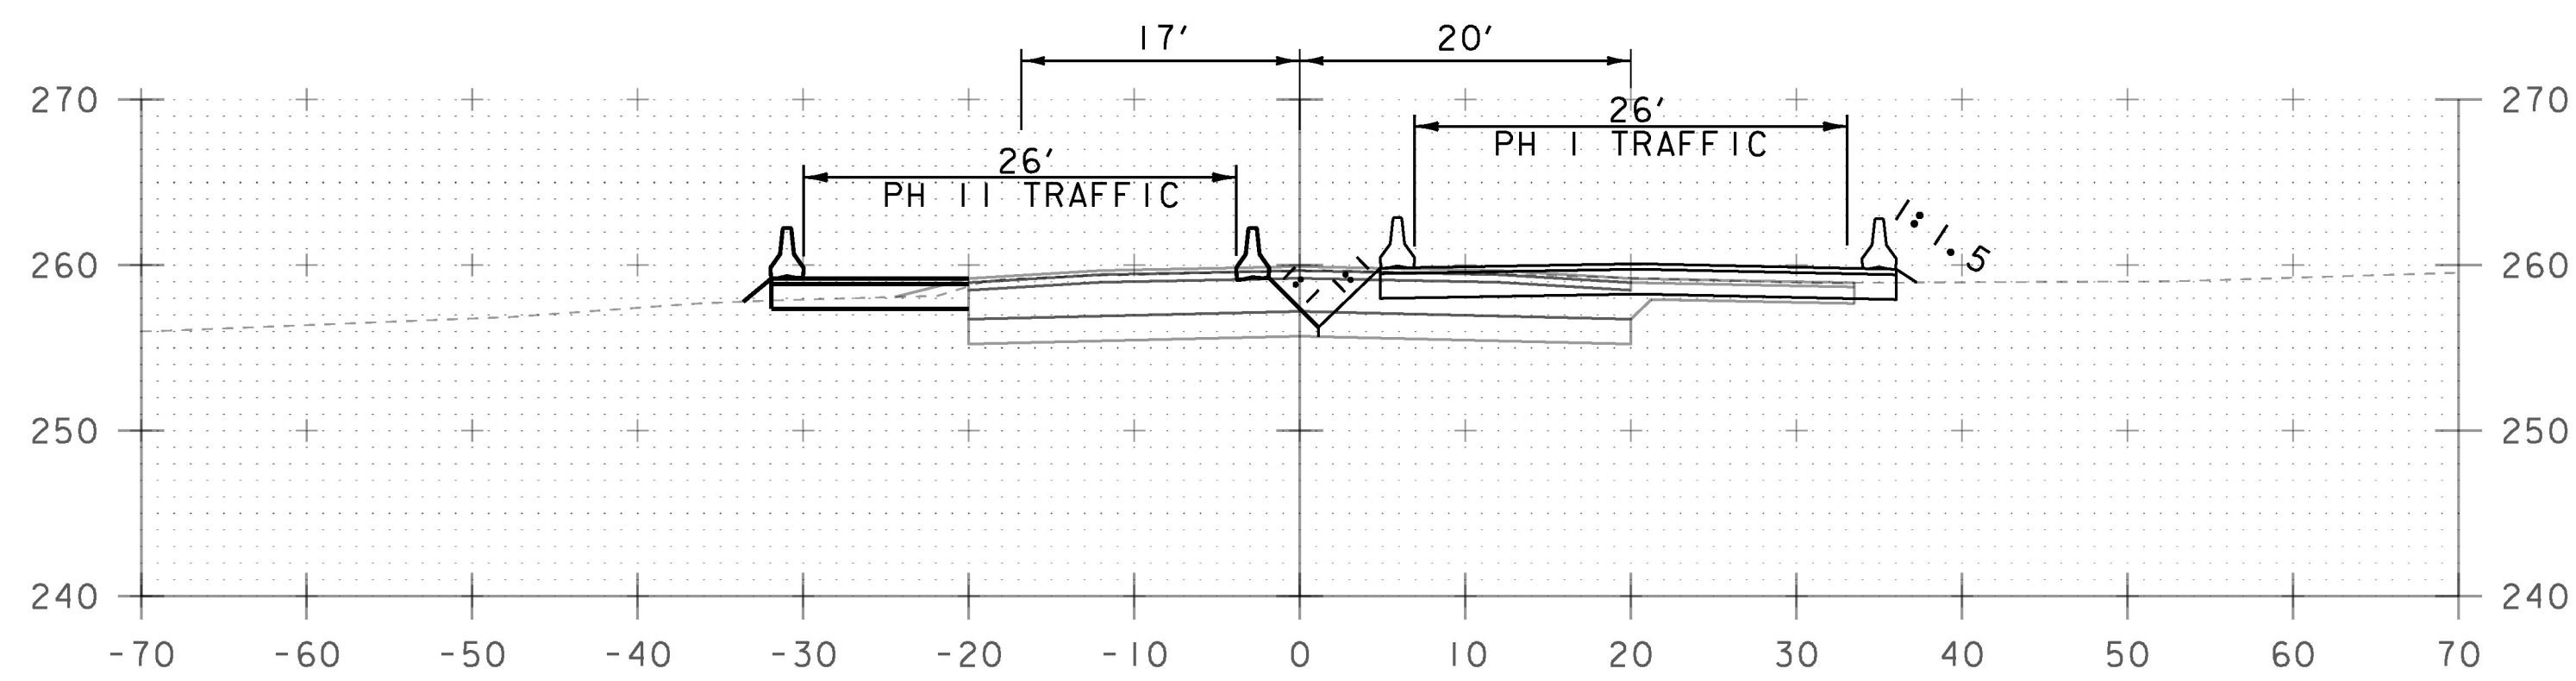


55+00

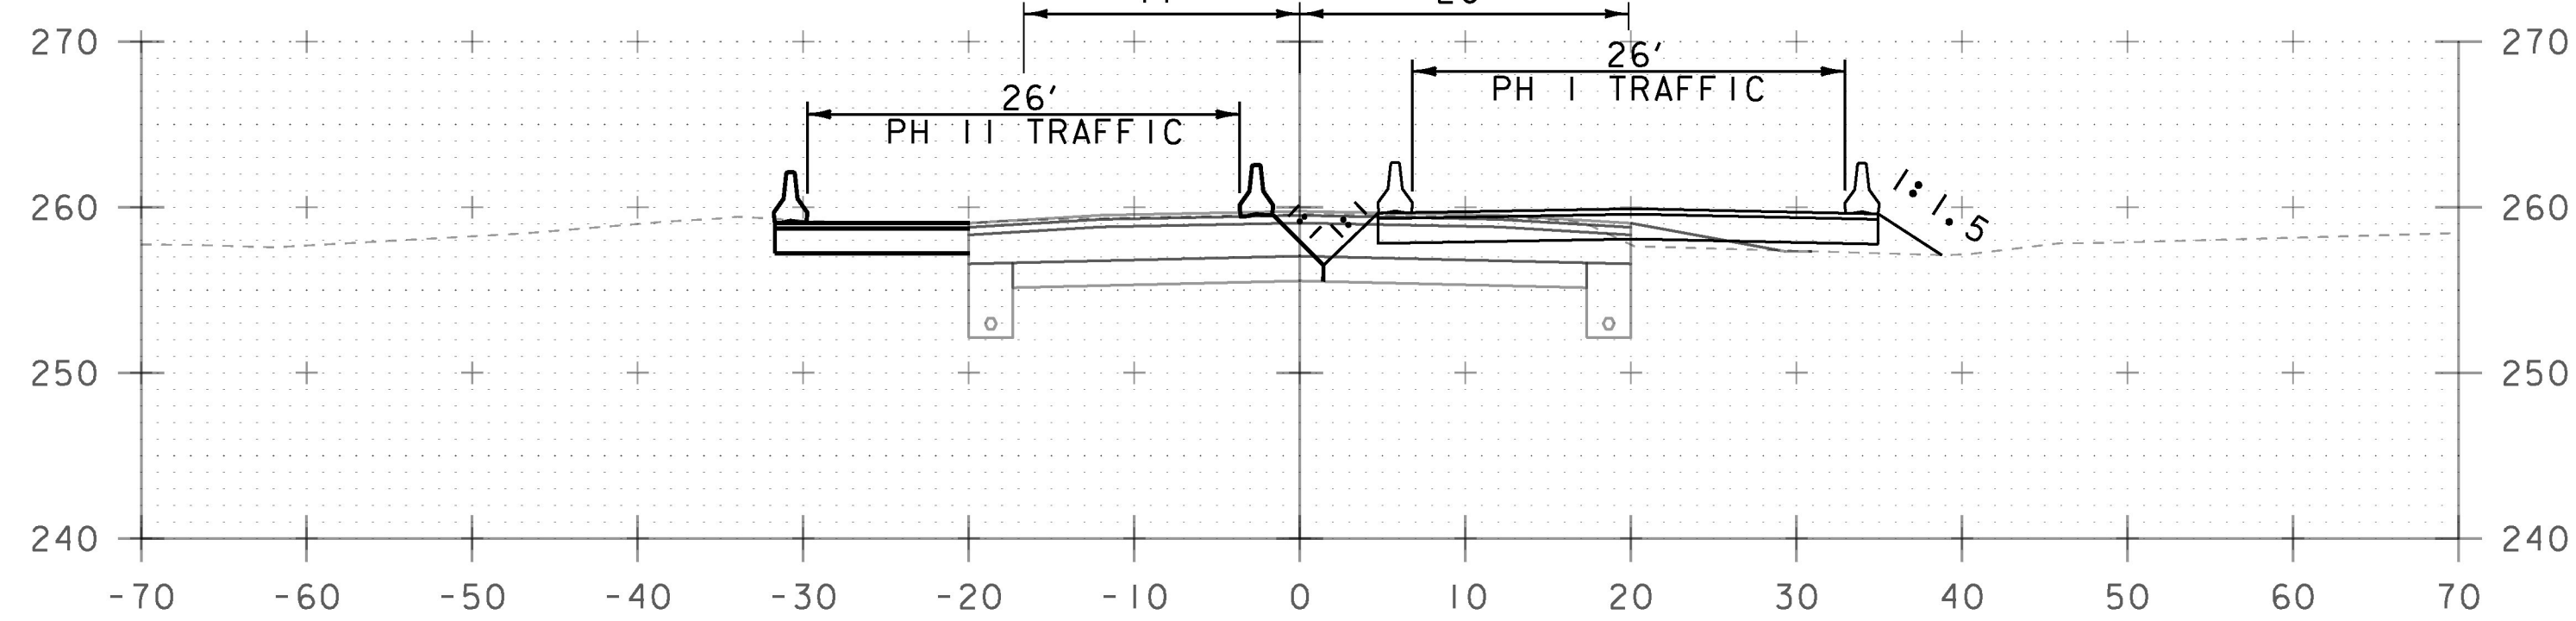


54+50

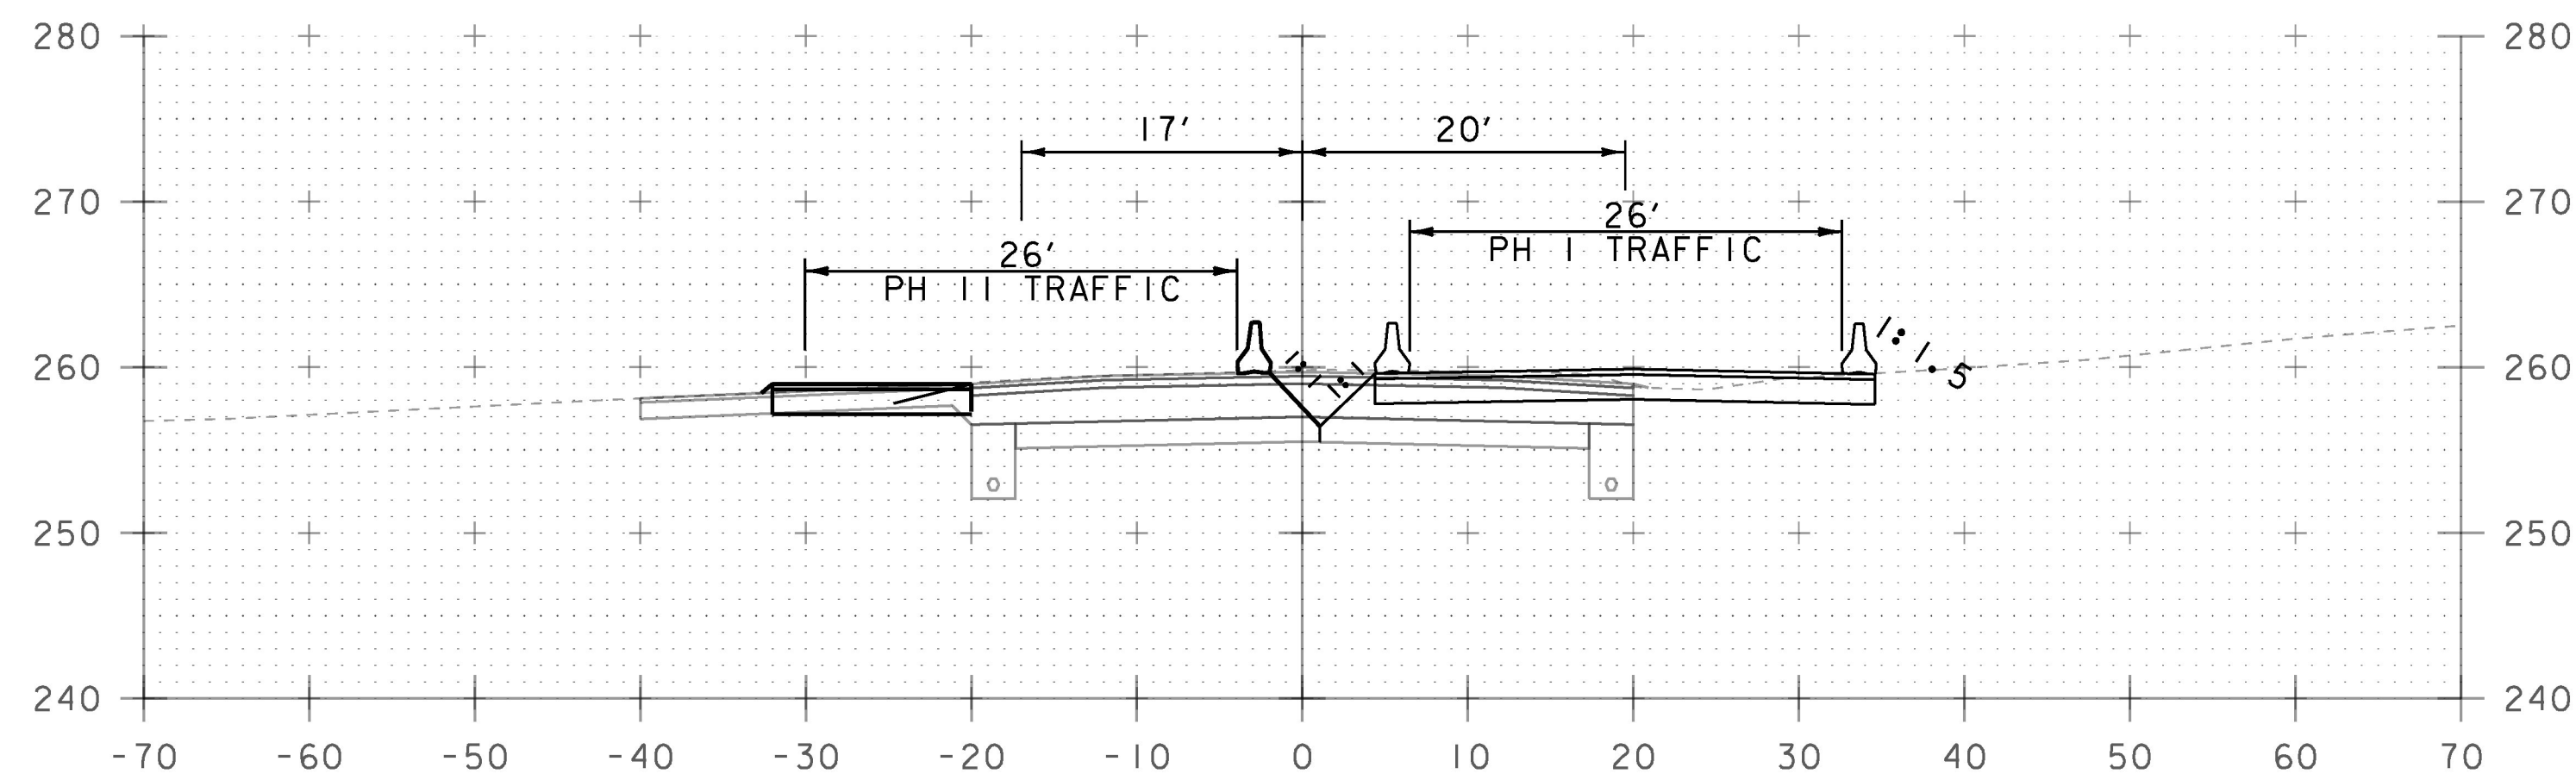

56+00

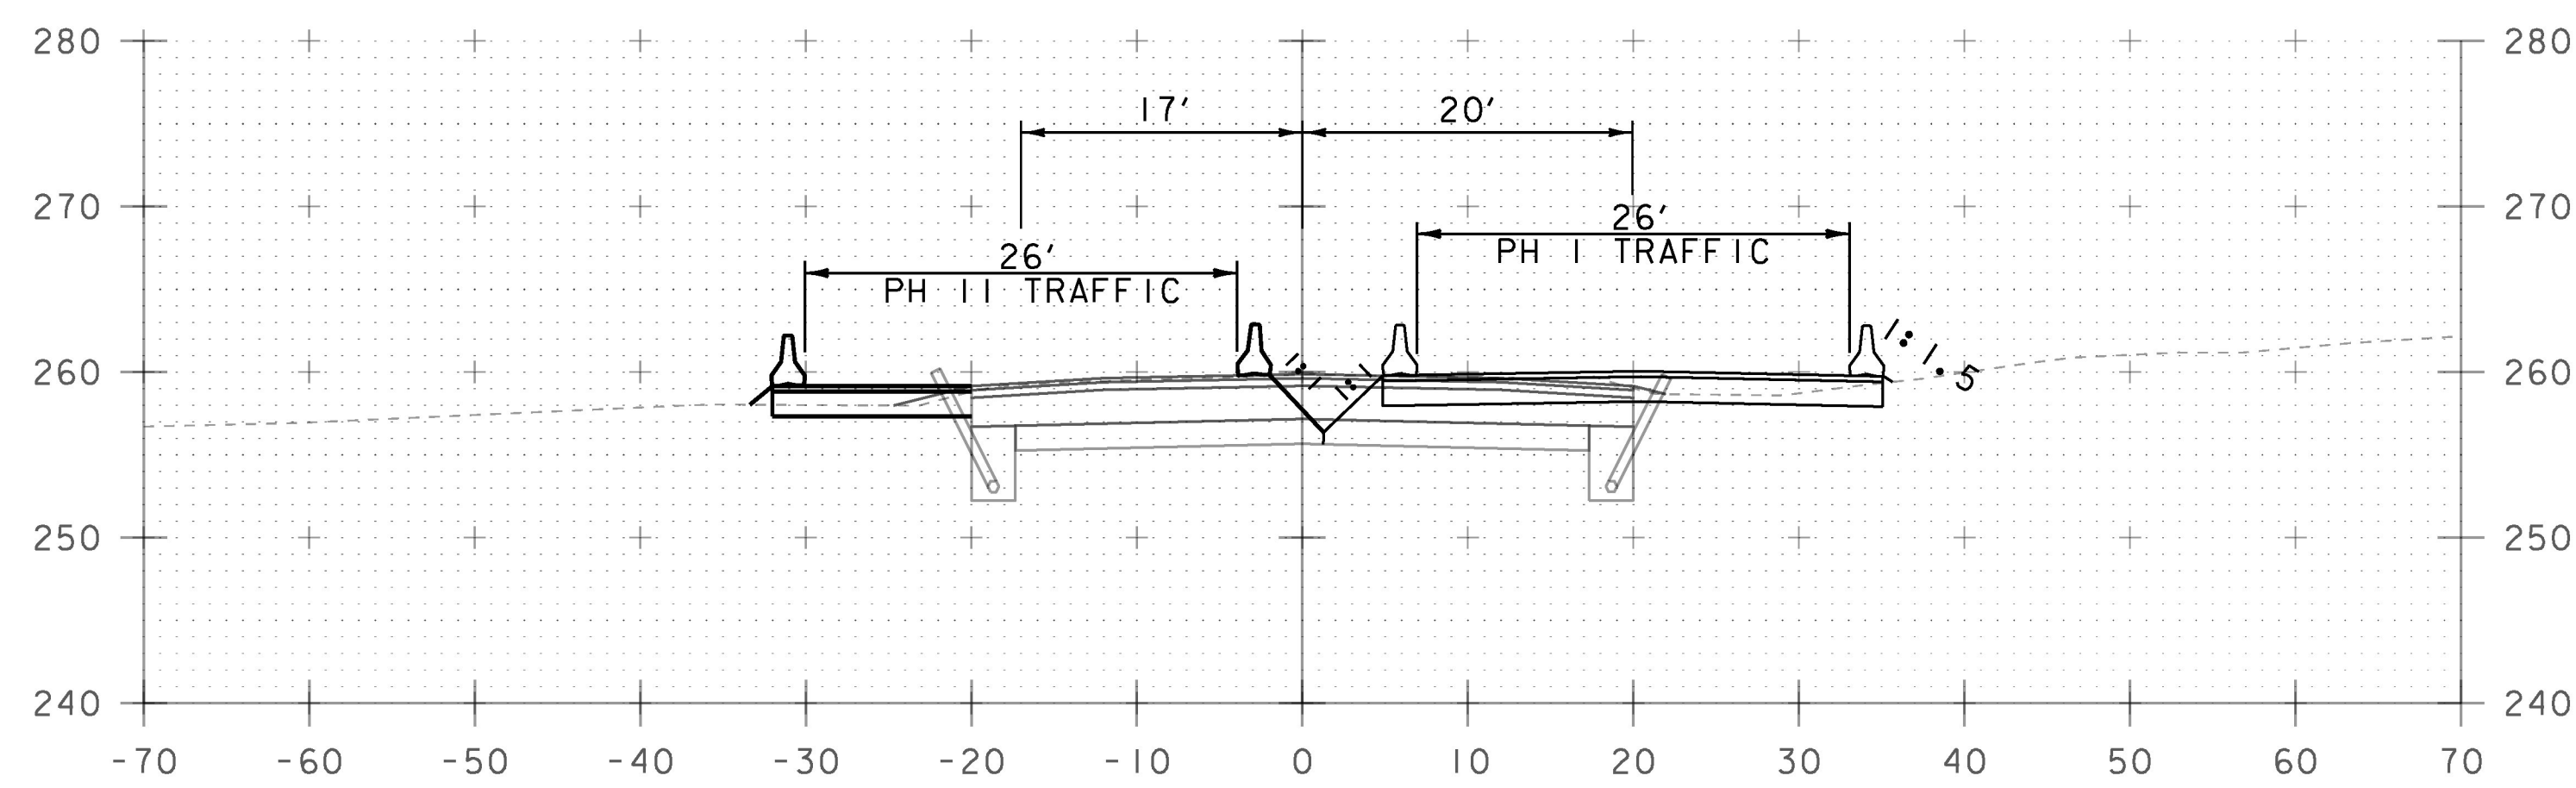

55+50

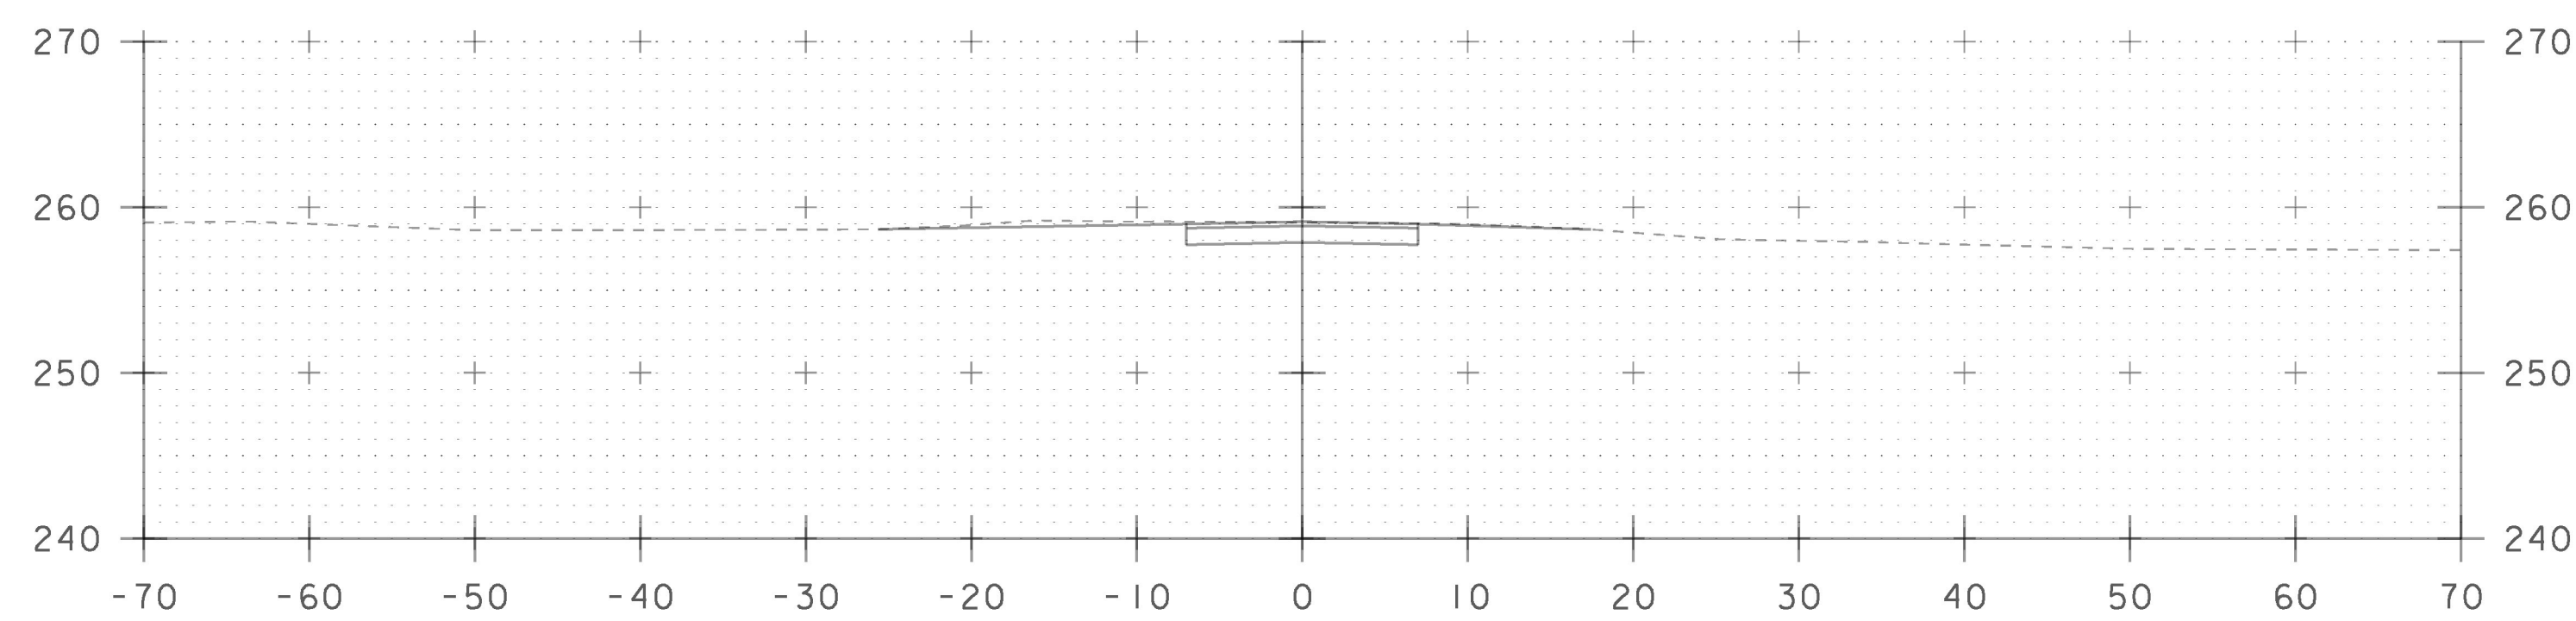

55+06 DRIVE RT SECTION A-A

STA. 54+50 TO STA. 56+00

PROJECT NAME:	CHARLOTTE	PLOT DATE:	15-MAR-2016
PROJECT NUMBER:	F EGC 019-4(20)	DRAWN BY:	B. KIPP
FILE NAME:	d78d062_fc_xs.dgn	DESIGNED BY:	B. KIPP
PROJECT LEADER:	K. UPMAL	CHECKED BY:	A. BOMBARDIER
TRAFFIC CONTROL CROSS SECTIONS 27		SHEET	443 OF 499