




154+91 DRIVE LT  
(SKEWED 77° 12' 51.76") RT

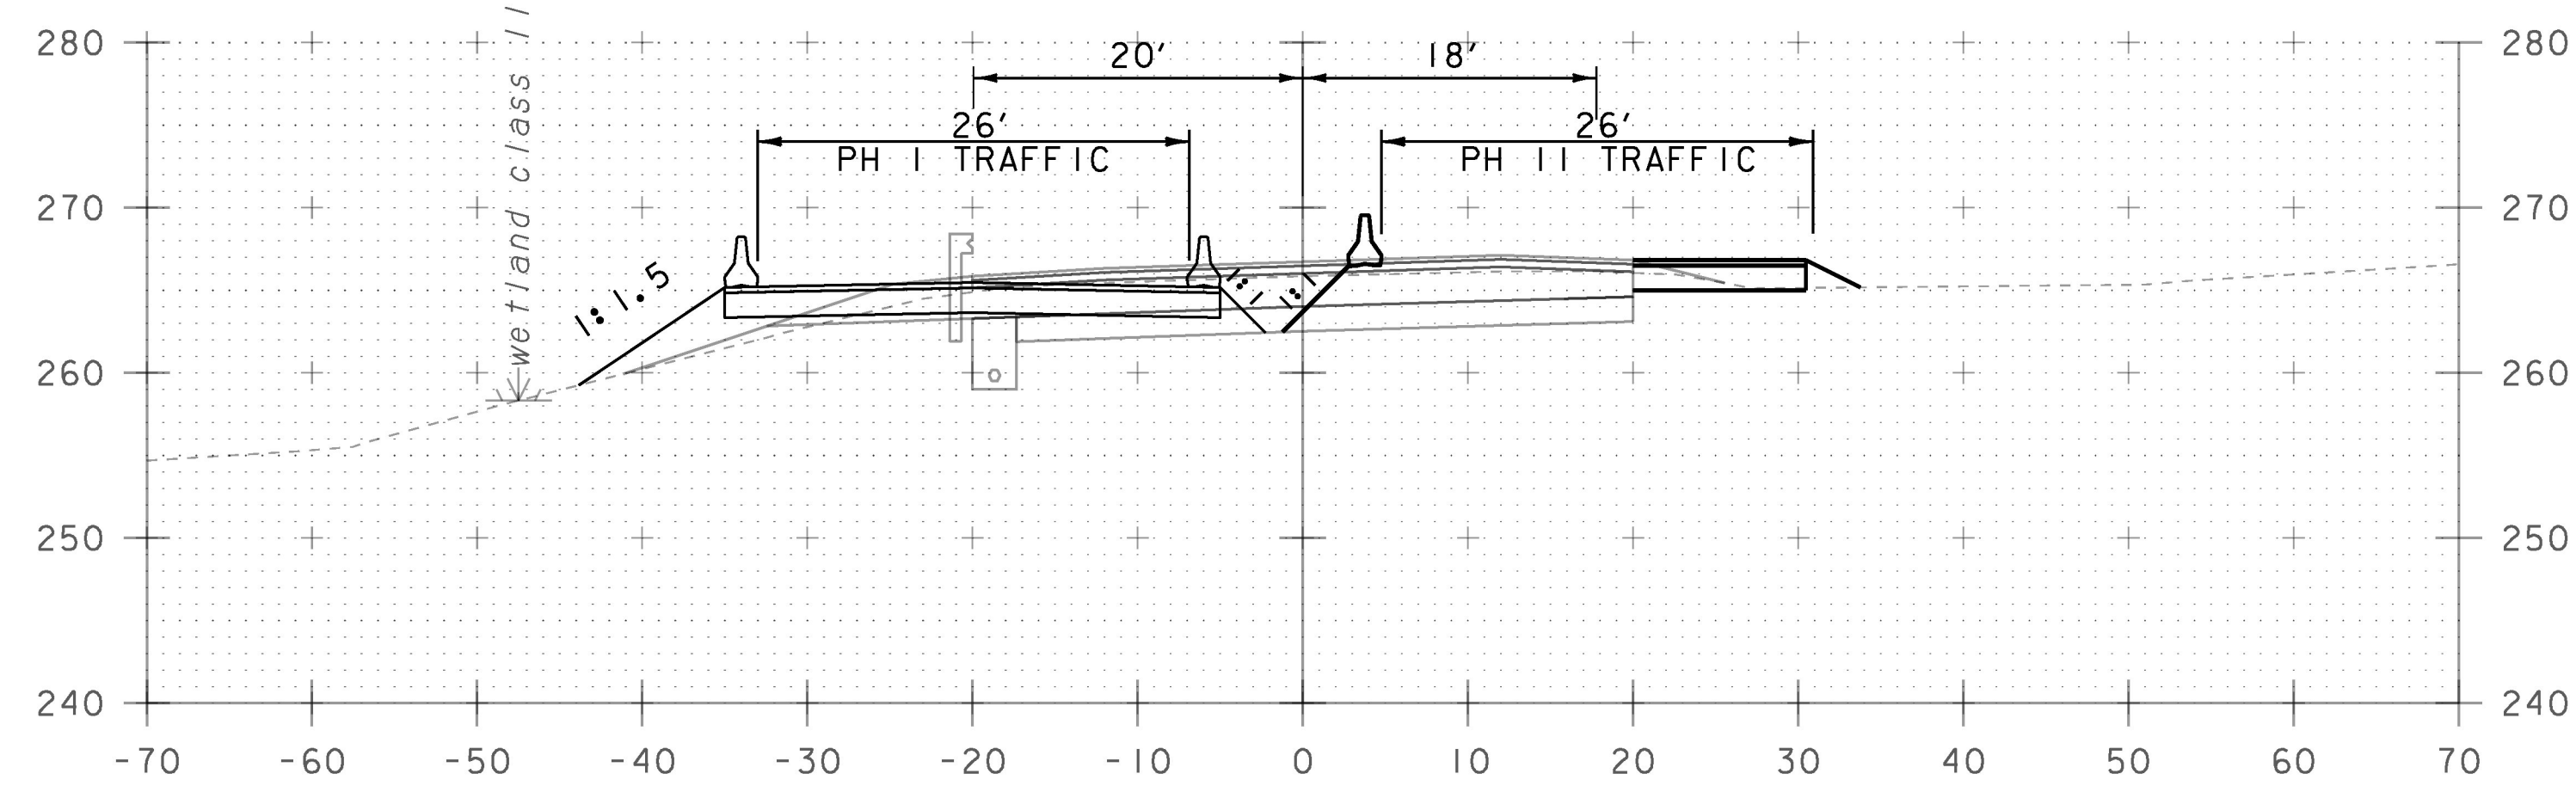


154+50

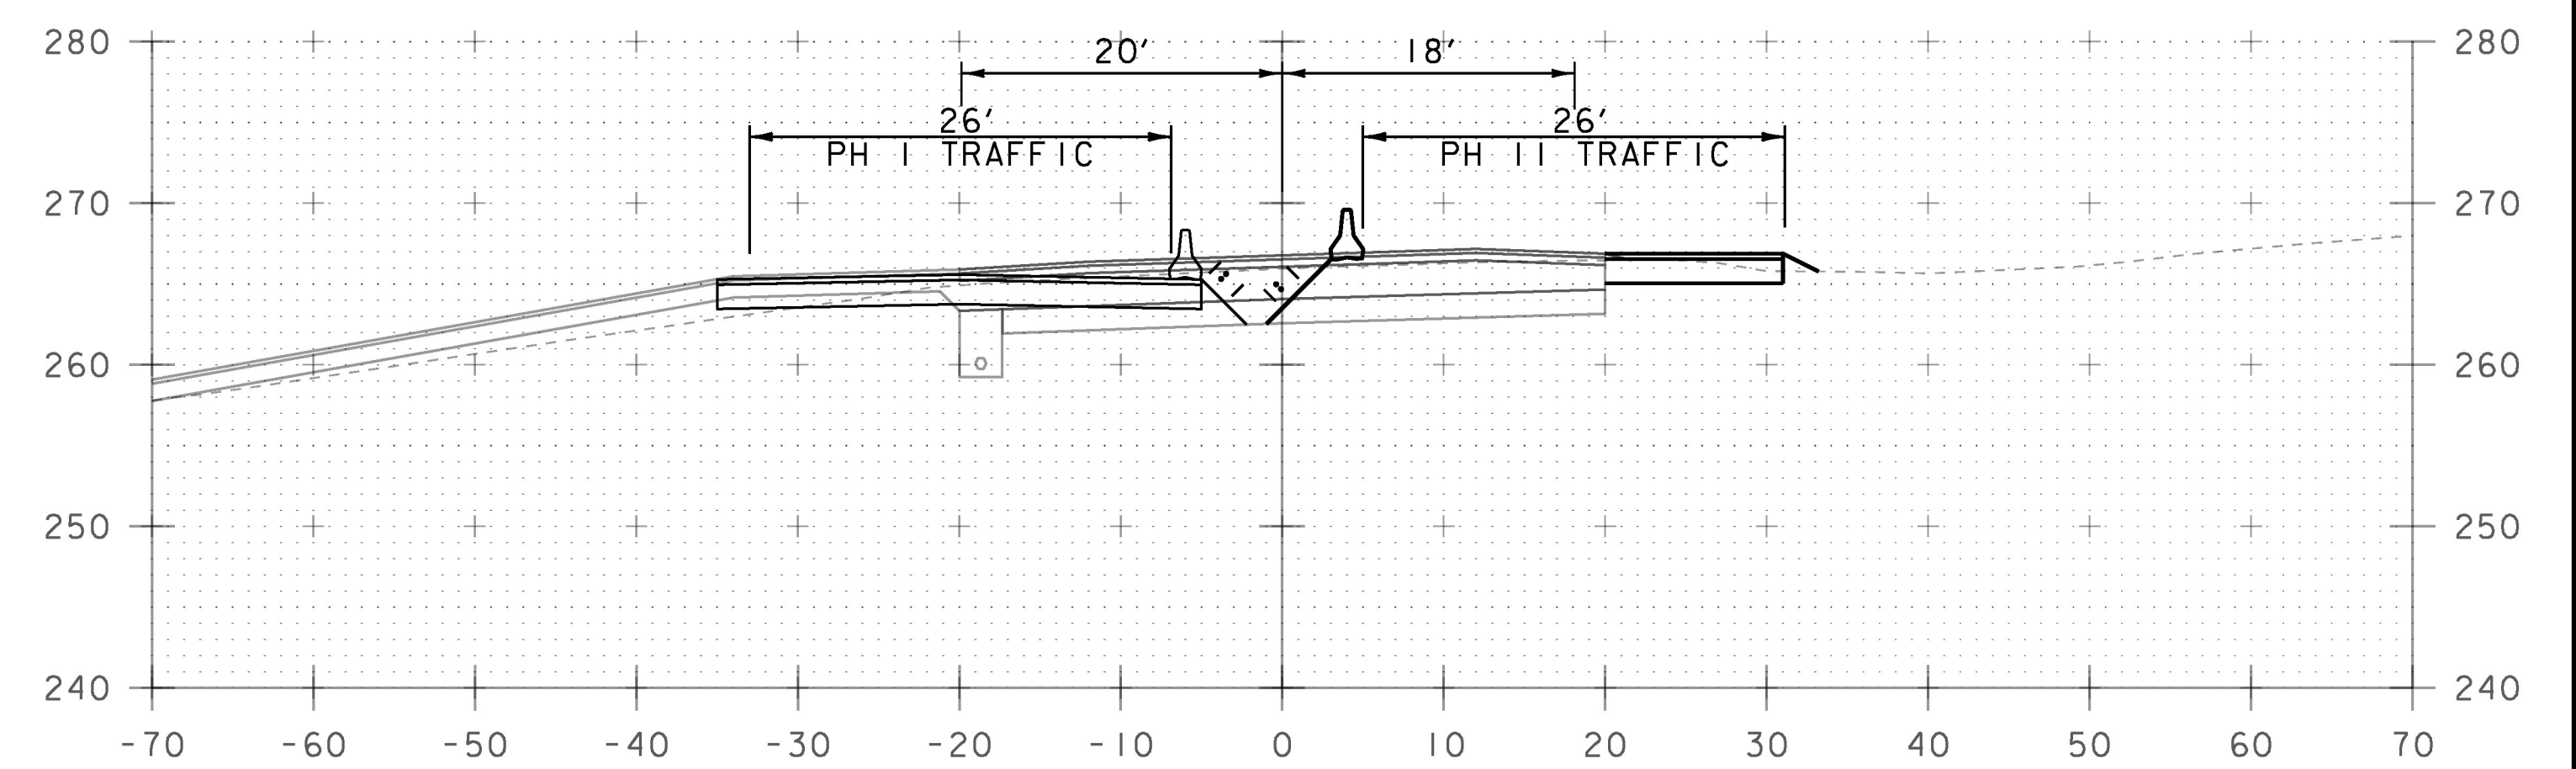

155+00

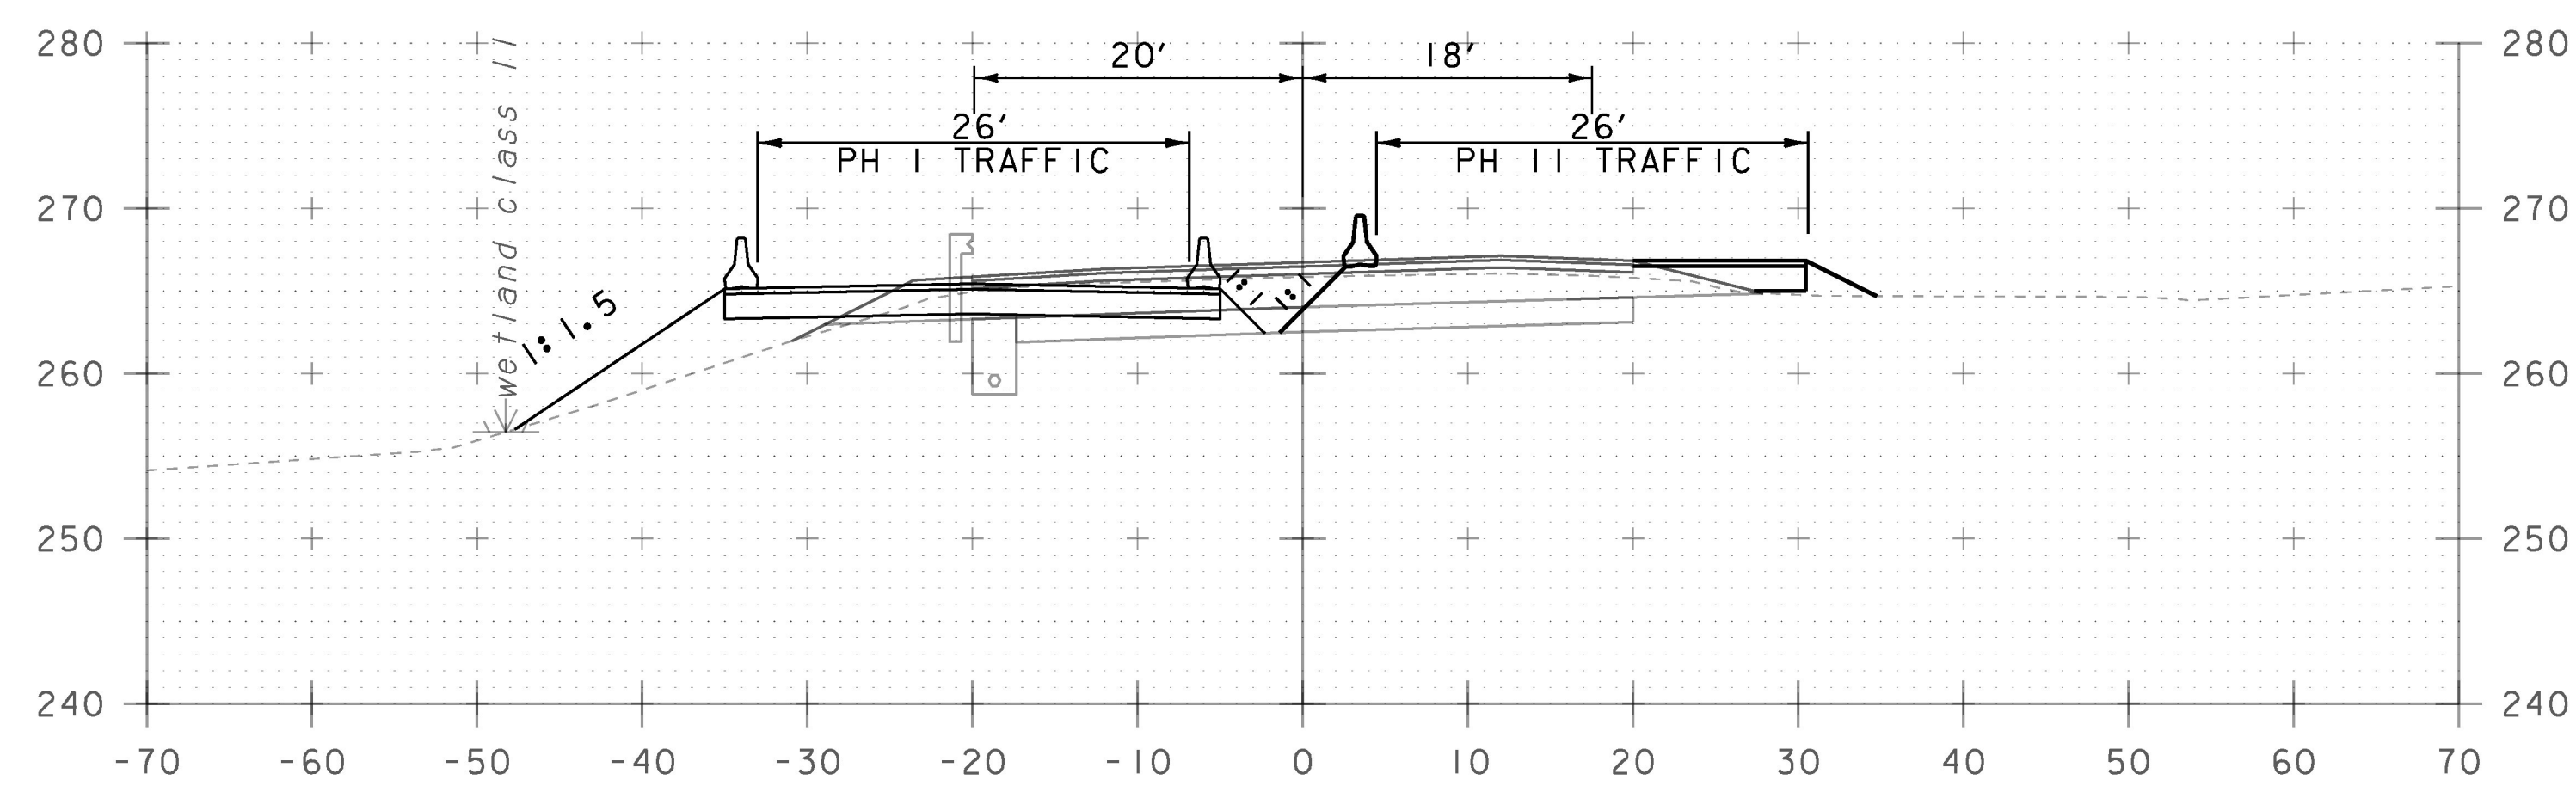

154+00

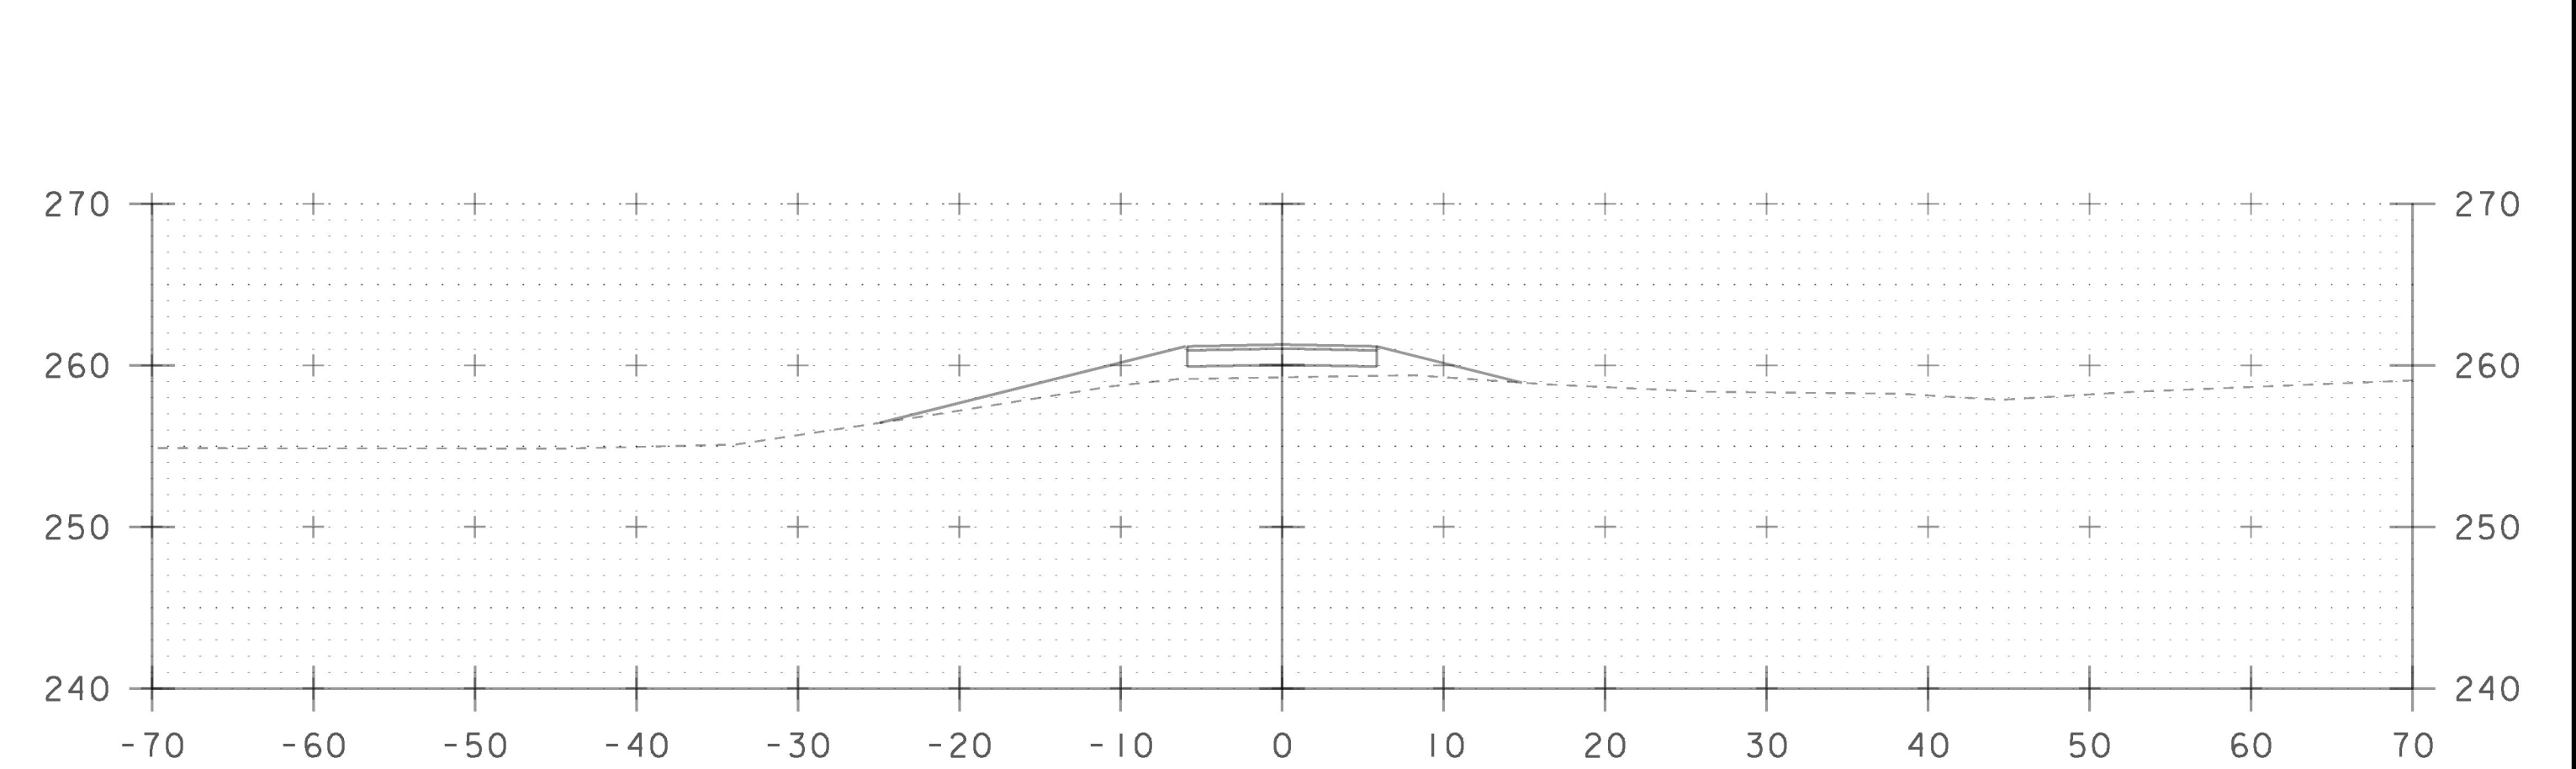

154+91 DRIVE LT SECTION A-A

STA. 154+00 TO STA. 155+00

PROJECT NAME: CHARLOTTE	PLOT DATE: 15-MAR-2016
PROJECT NUMBER: F EGC 019-4(20)	DRAWN BY: B. KIPP
FILE NAME: d78d062_fc_xs.dgn	CHECKED BY: A. BOMBARDIER
PROJECT LEADER: K. UPMAL	SHEET 492 OF 499
DESIGNED BY: B. KIPP	
TRAFFIC CONTROL CROSS SECTIONS 76	