




163+72 DRIVE LT SECTION A-A

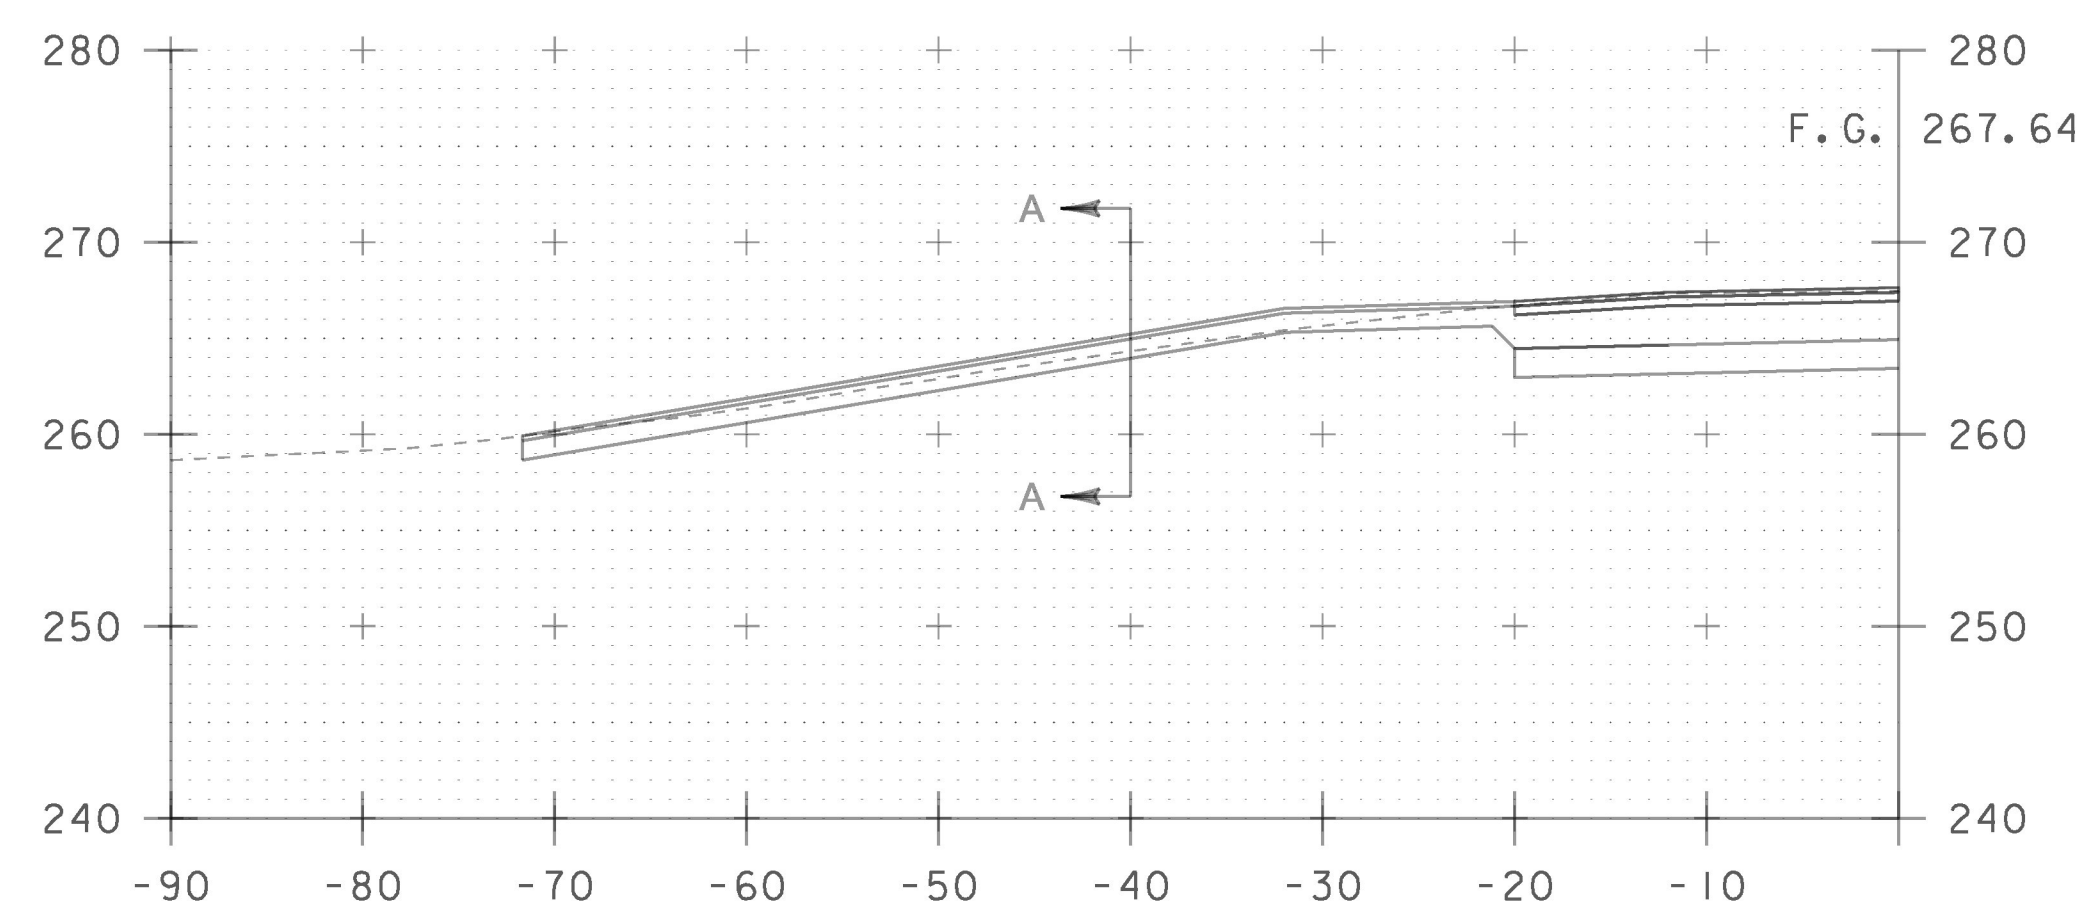

163+72 DRIVE LT

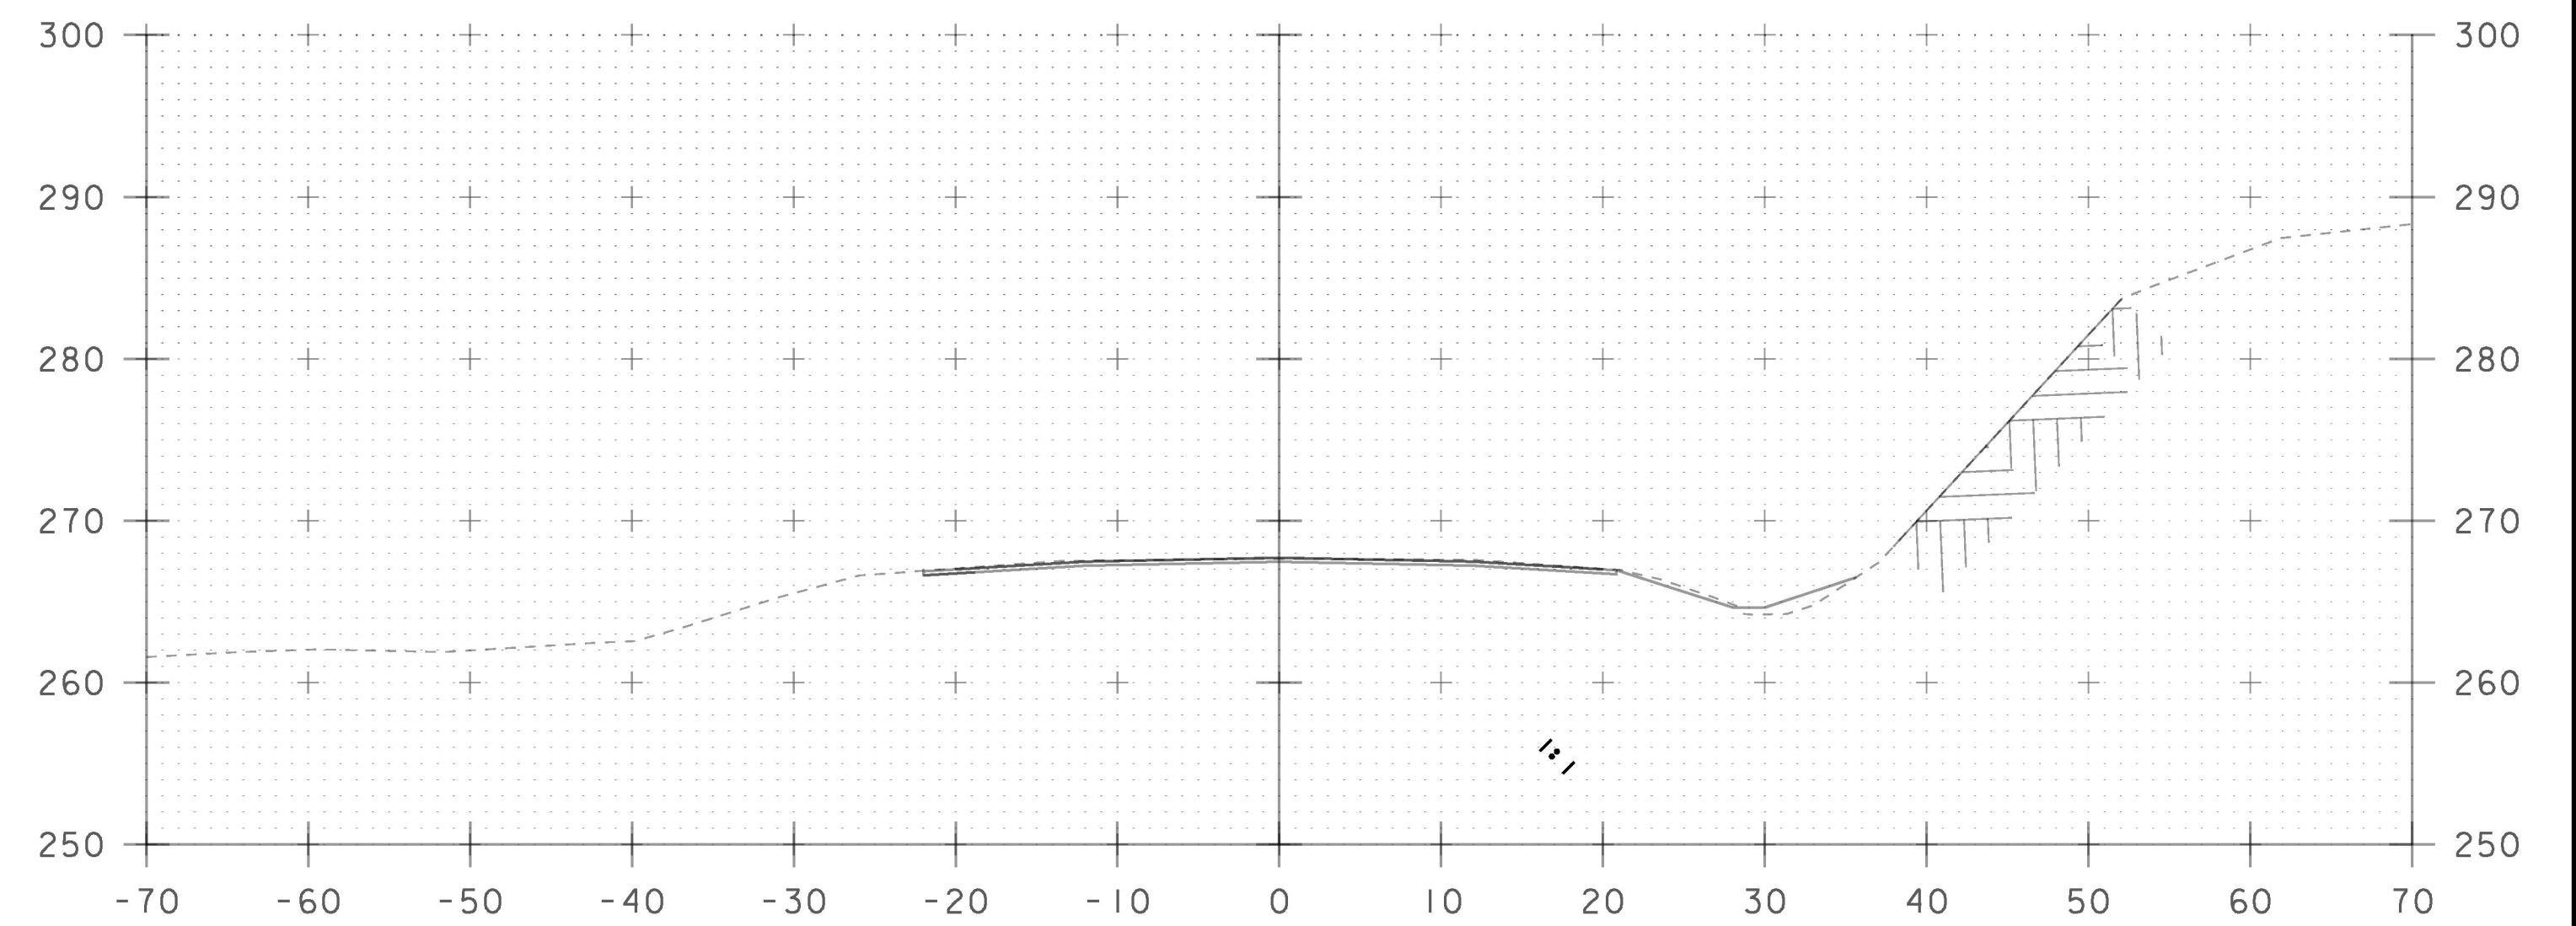

164+50
BEGIN COLD PLANING

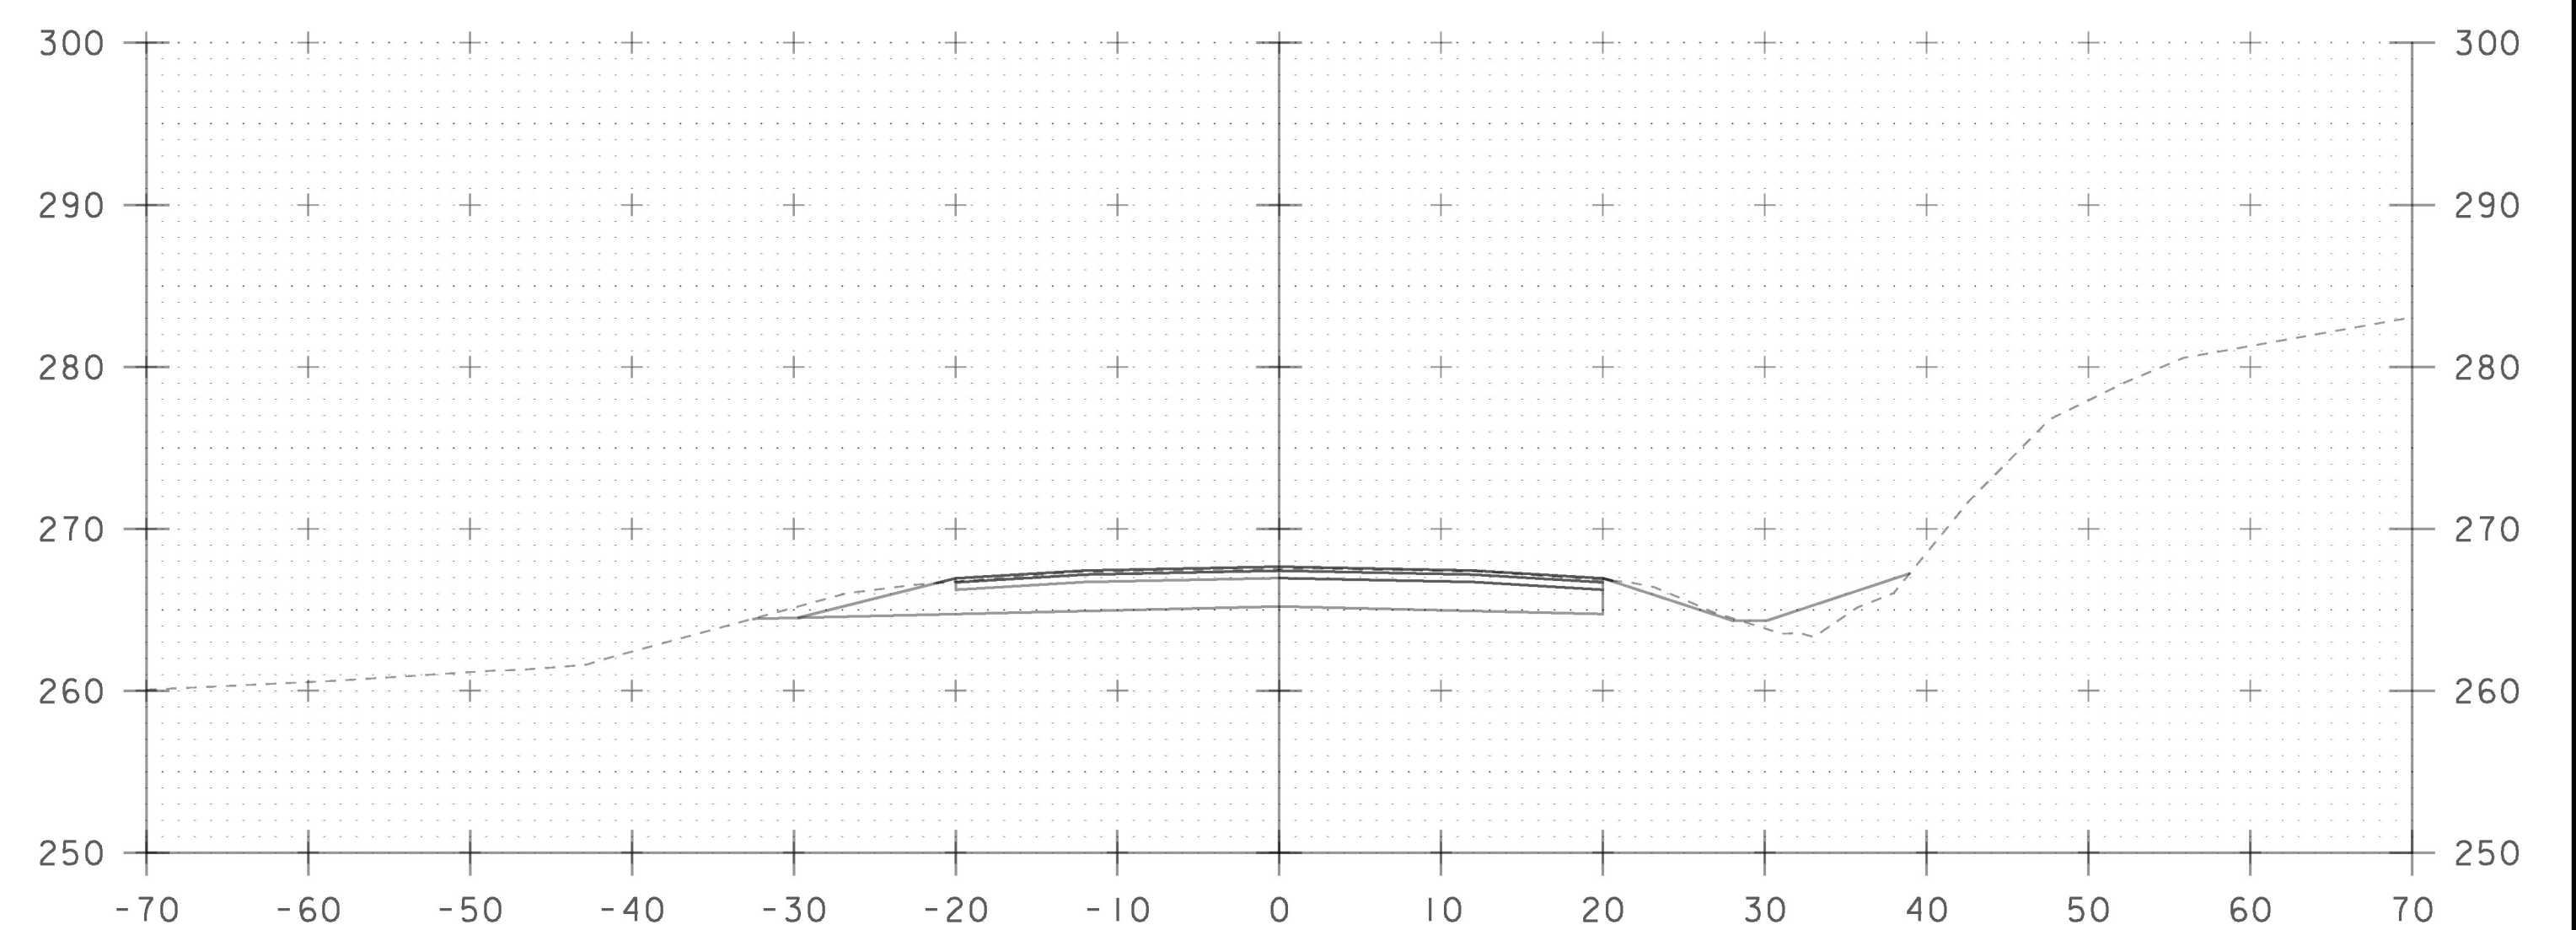

164+00

STA. 163+72 TO STA. 164+50

PROJECT NAME:	CHARLOTTE	PLOT DATE:	15-MAR-2016
PROJECT NUMBER:	F EGC 019-4(20)	DRAWN BY:	B. KIPP
FILE NAME:	d78d062_fc_xs.dgn	CHECKED BY:	A. BOMBARDIER
PROJECT LEADER:	K. UPMAL	TRAFFIC CONTROL CROSS SECTIONS	82
DESIGNED BY:	B. KIPP	SHEET	498 OF 499