


DATE: 12/14/11
 BY: J.S. [unclear]
 CHECKED: [unclear]
 SURVEYED: [unclear]
 PLOTTED: [unclear]
 NOTE BOOK: [unclear]
 NO.:



DATE: 12/14/11
 BY: J.S. [unclear]
 CHECKED: [unclear]
 SURVEYED: [unclear]
 PLOTTED: [unclear]
 NOTE BOOK: [unclear]
 NO.:

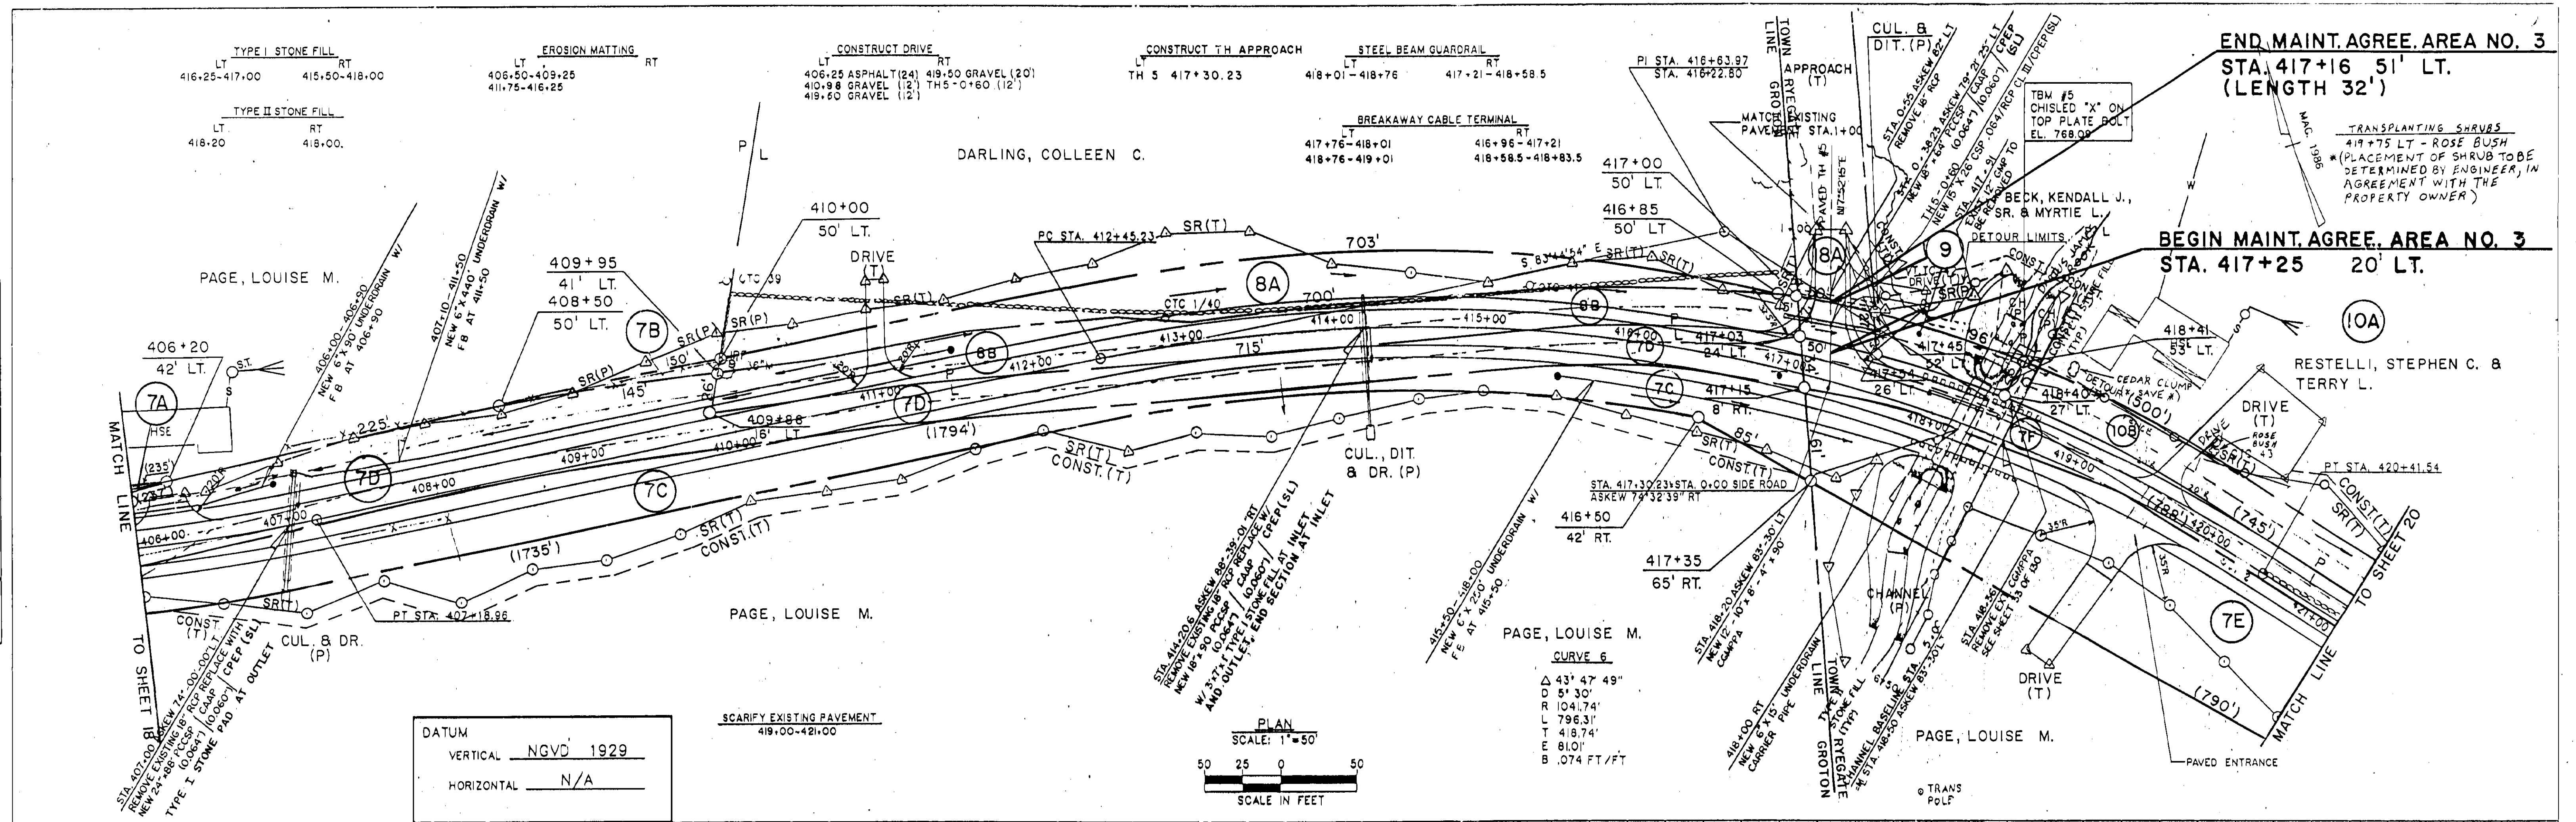