
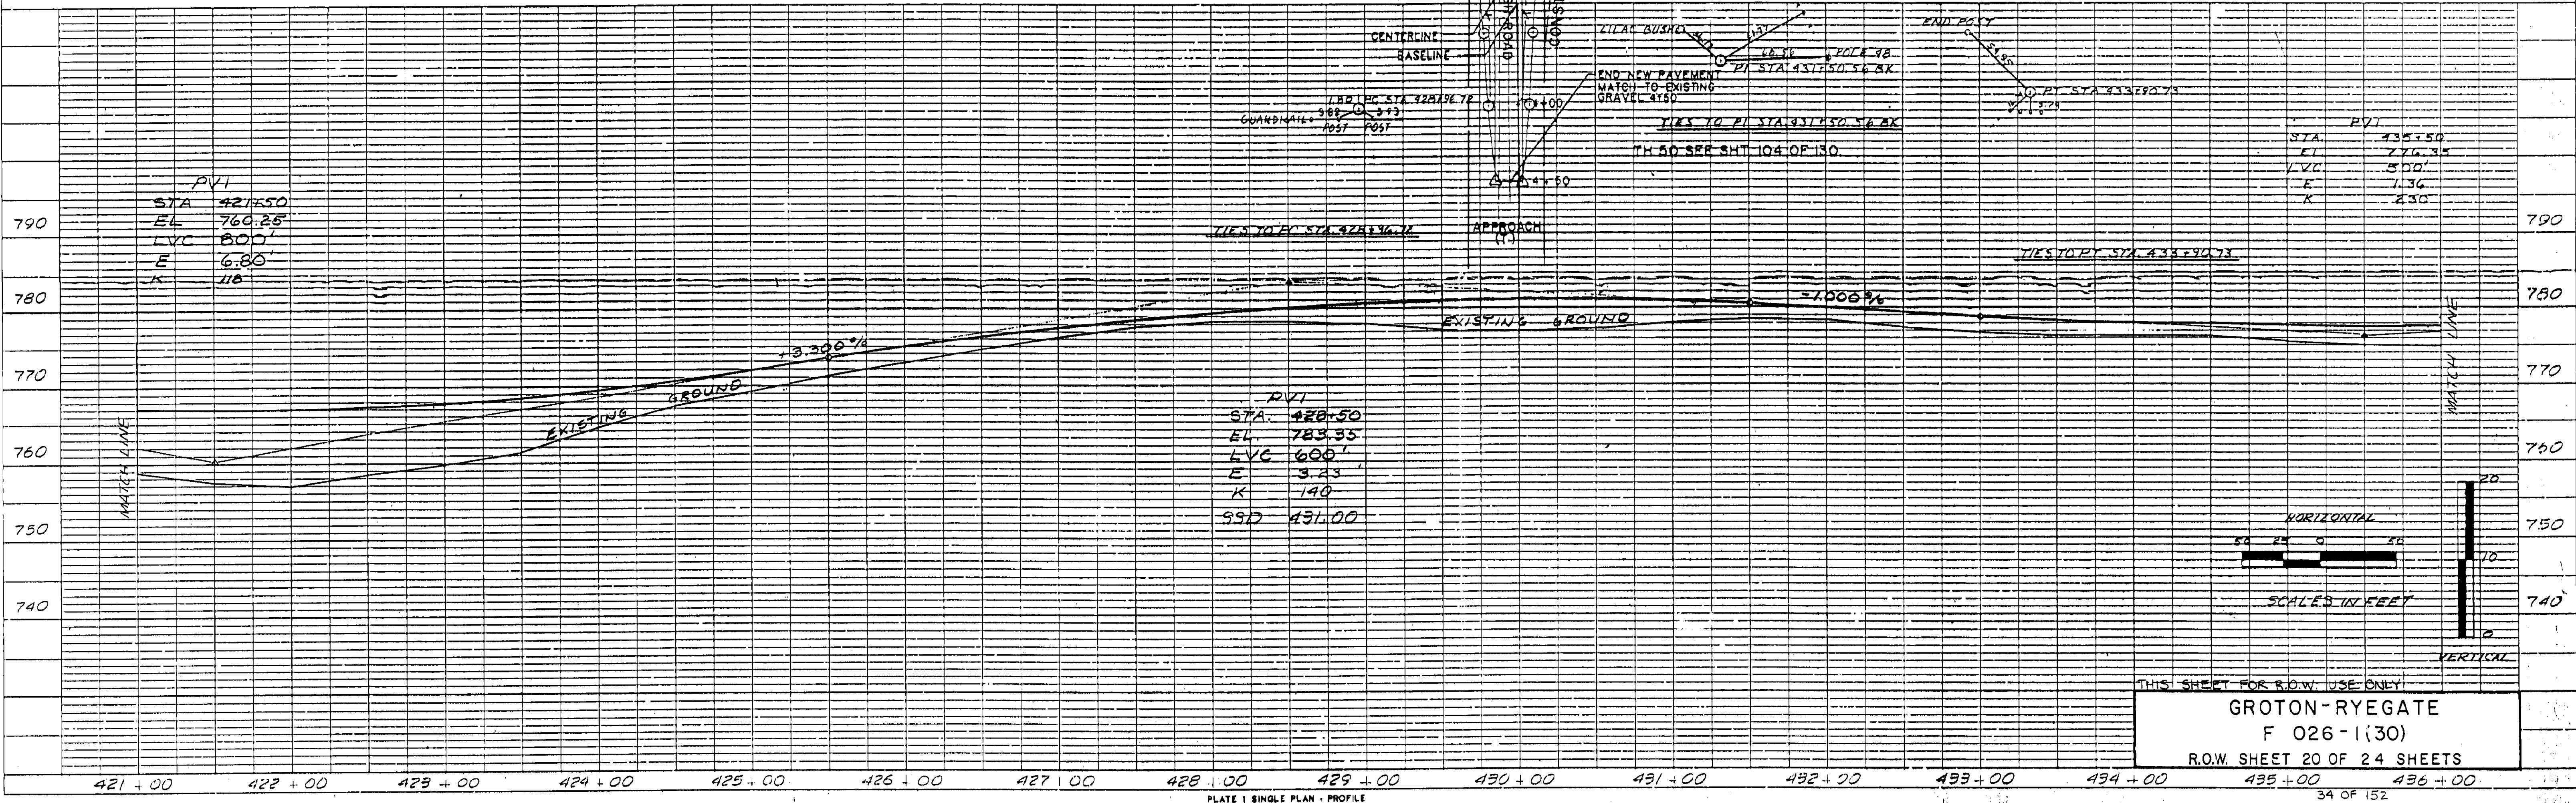


DATE	
BY	
ECG	
DISC	
DATE	
BY	
ECG	
DISC	
DATE	
BY	
ECG	
DISC	

PLAN
DATE
BY
ECG
DISC

DATE	
BY	
ECG	
DISC	
DATE	
BY	
ECG	
DISC	
DATE	
BY	
ECG	
DISC	

PROFILE
DATE
BY
ECG
DISC

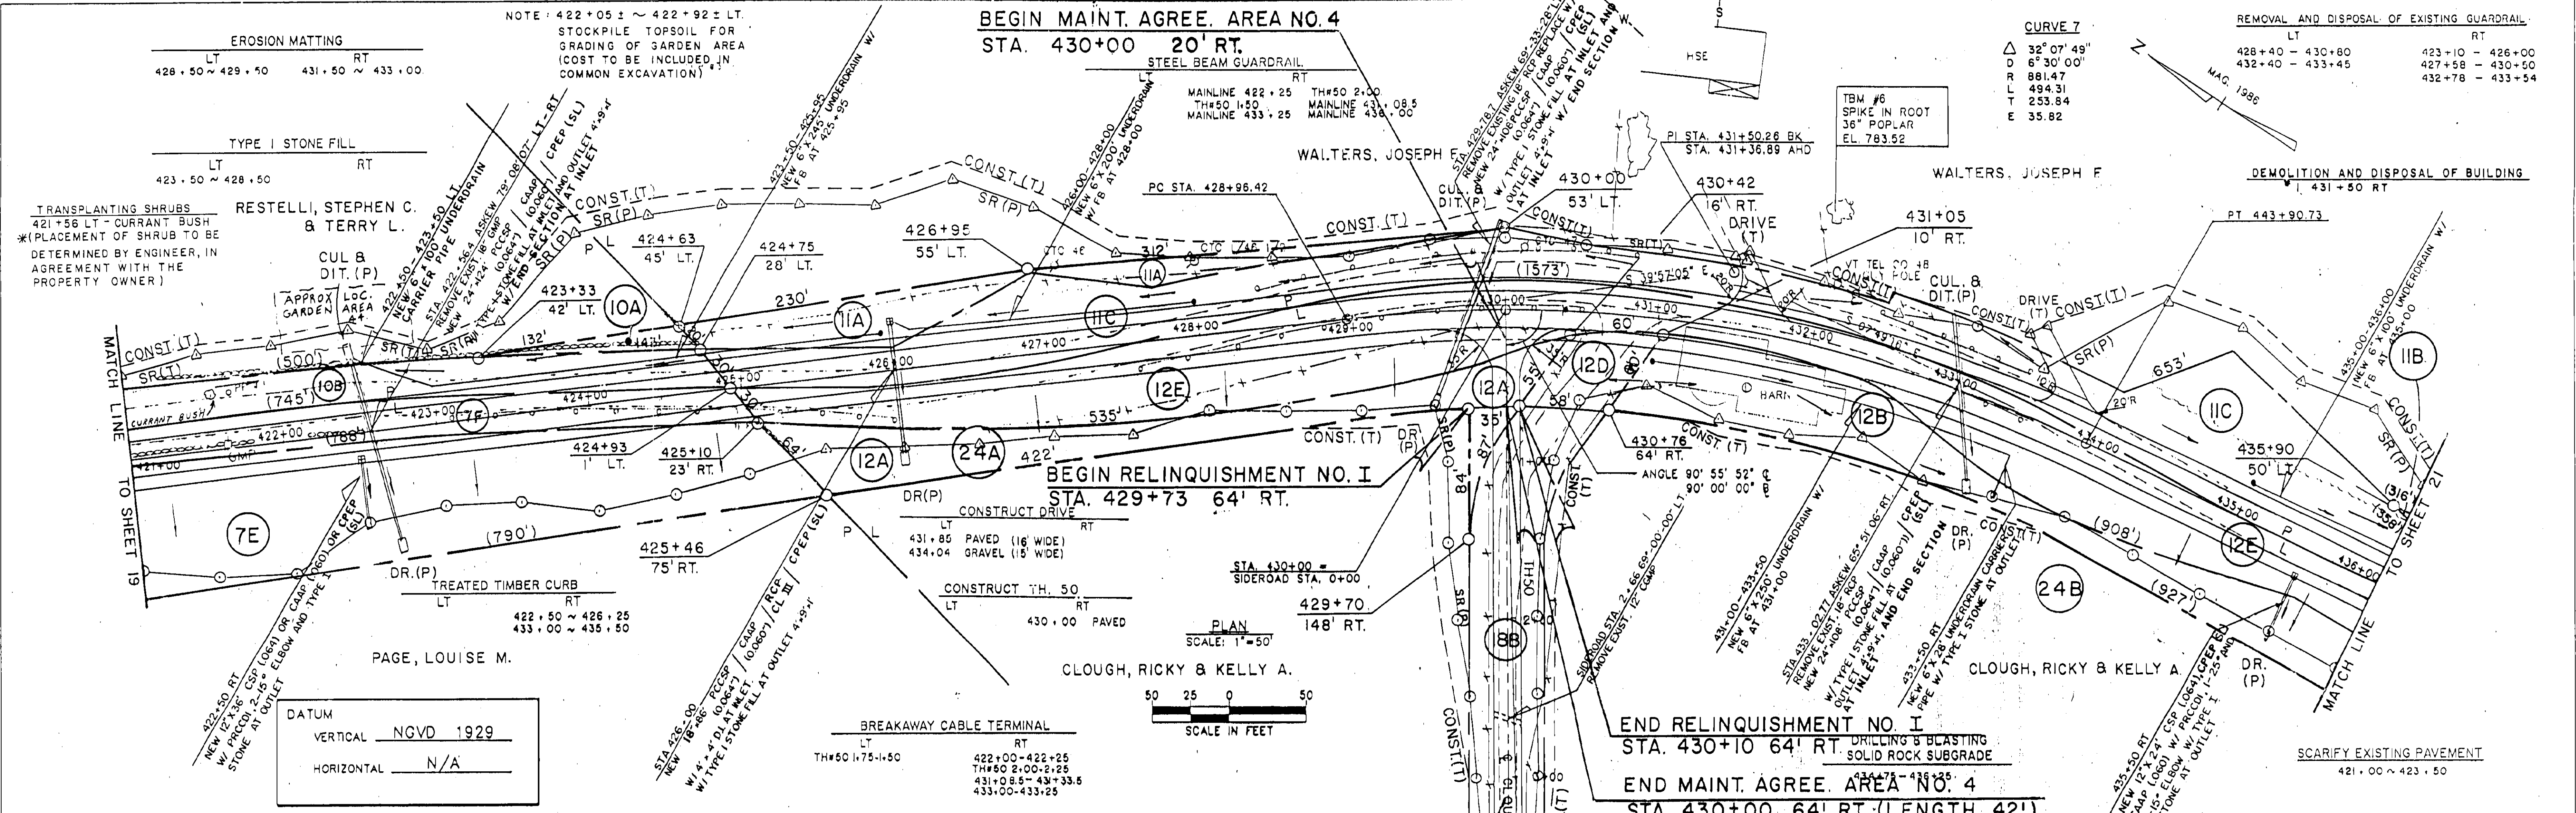

THIS SHEET FOR R.O.W. USE ONLY
GROTON-RYEGATE
 F 026-1(30)
 R.O.W. SHEET 20 OF 24 SHEETS

BRUNING 44 131 13428