


DATE	BY	CHKD.
10/24/24	C.B.	C.B.
DESIGNED	PLANNED	NOTED
BY C.B.	BY C.B.	BY C.B.
NO.	NO.	NO.


DATE	BY	CHKD.
10/24/24	C.B.	C.B.
DESIGNED	PLANNED	NOTED
BY C.B.	BY C.B.	BY C.B.
NO.	NO.	NO.

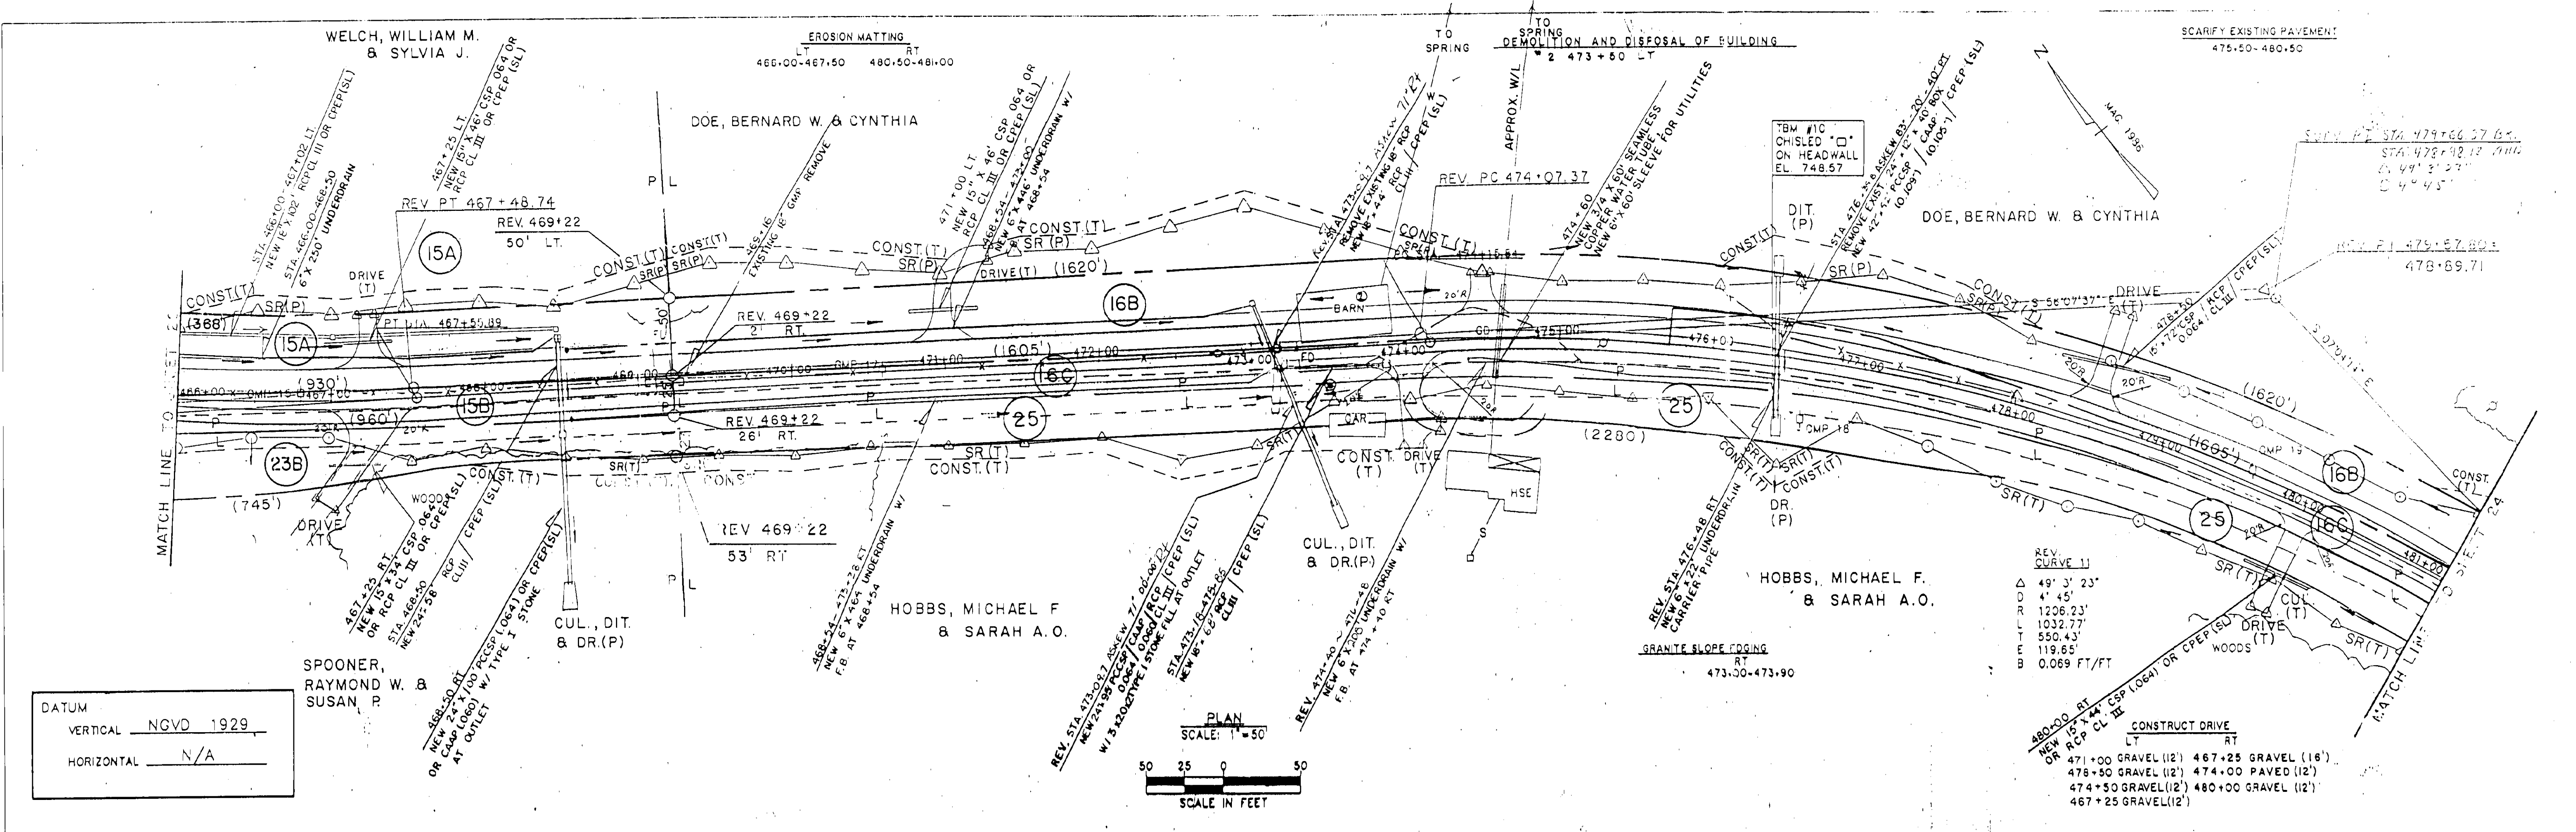

DATUM
 VERTICAL NGVD 1929
 HORIZONTAL N/A

REV. CURVE 11
 Δ 49° 3' 23"
 D 1206.23'
 L 1032.77'
 T 550.43'
 E 119.65'
 B 0.069 FT/FT

CONSTRUCT DRIVE
 LT
 471+00 GRAVEL (12) 467+25 GRAVEL (16)
 476+50 GRAVEL (12) 474+00 PAVED (12)
 474+50 GRAVEL (12) 480+00 GRAVEL (12)
 467+25 GRAVEL (12)

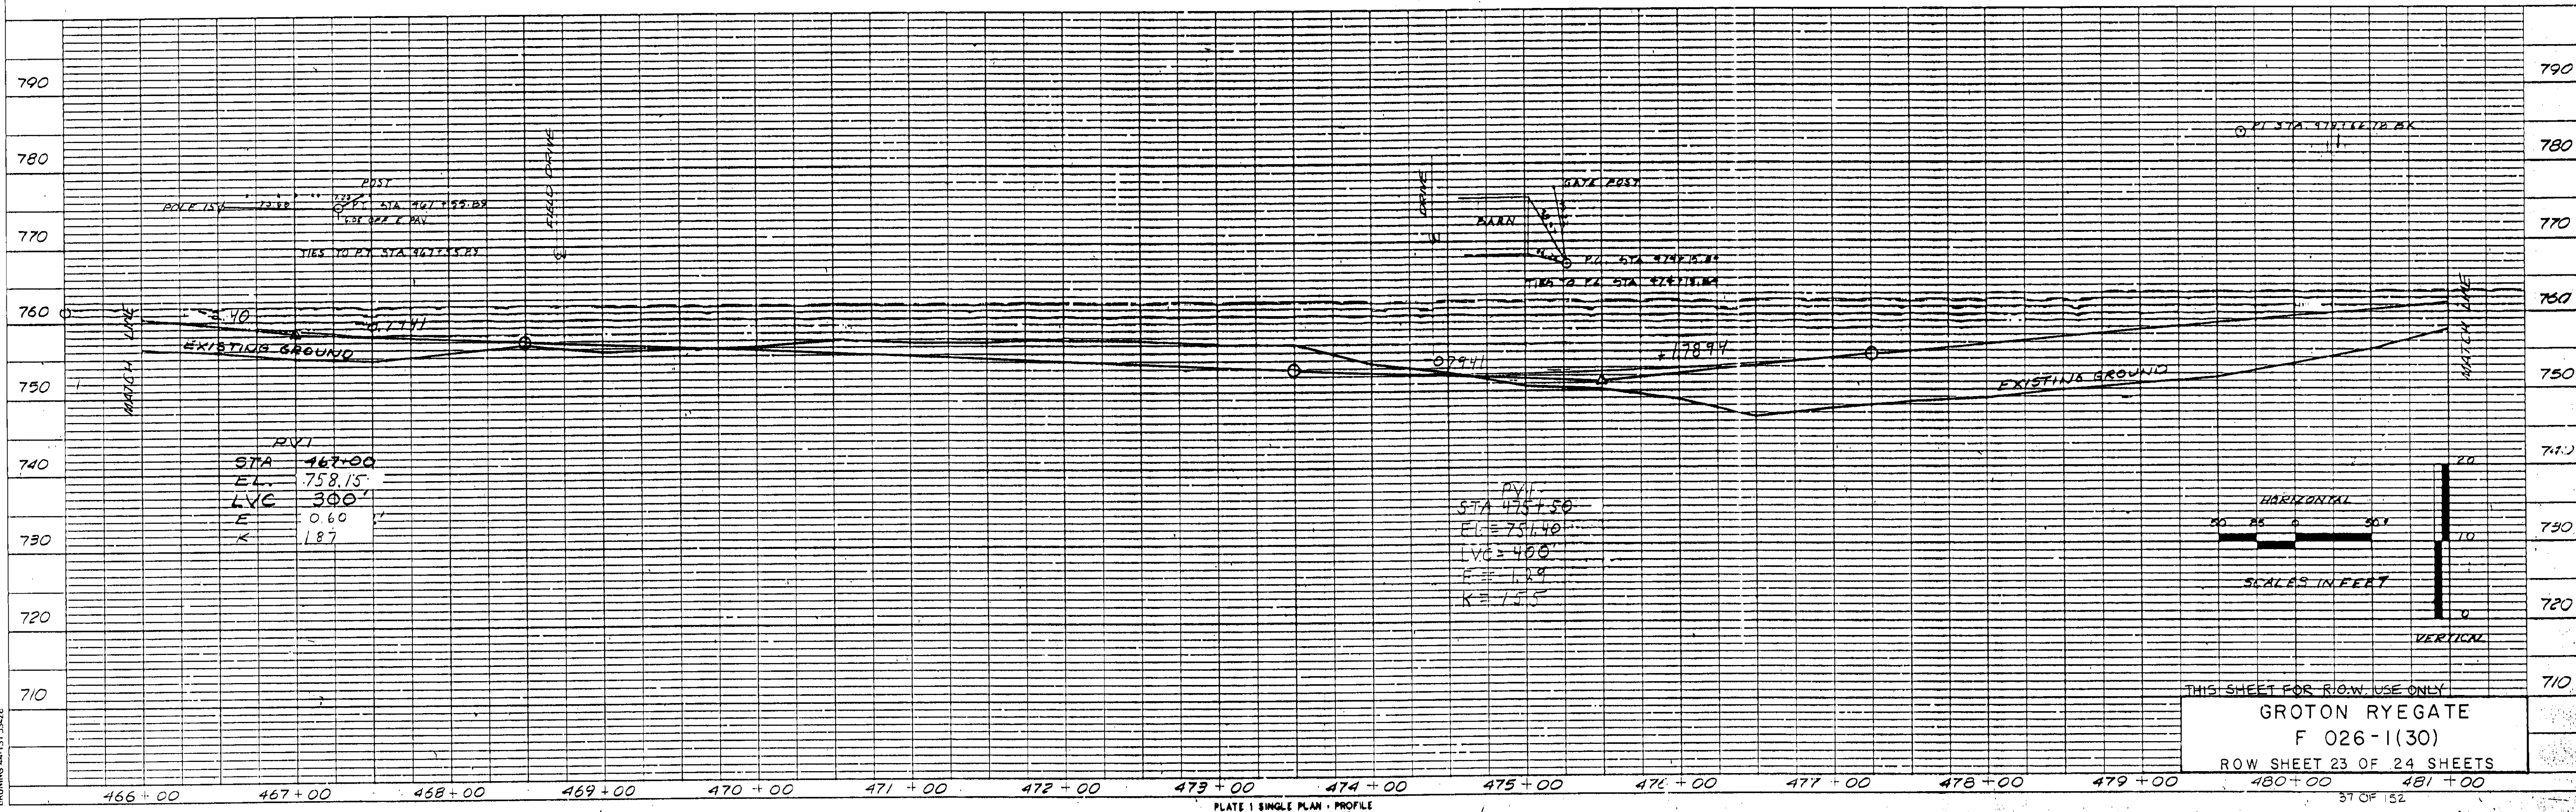

PVI
 STA 467+00
 EL. 758.15
 LVC 300'
 E 0.60
 K 1.87

PVI
 STA 475+30
 EL. 751.40
 LVC 400'
 E 1.89
 K 1.55

HORIZONTAL
 50 25 0 25 50
 SCALES IN FEET
 VERTICAL
 20 10 0

THIS SHEET FOR R.O.W. USE ONLY
 GROTON RYEGATE
 F 026-1(30)
 ROW SHEET 23 OF 24 SHEETS
 480+00 481+00