
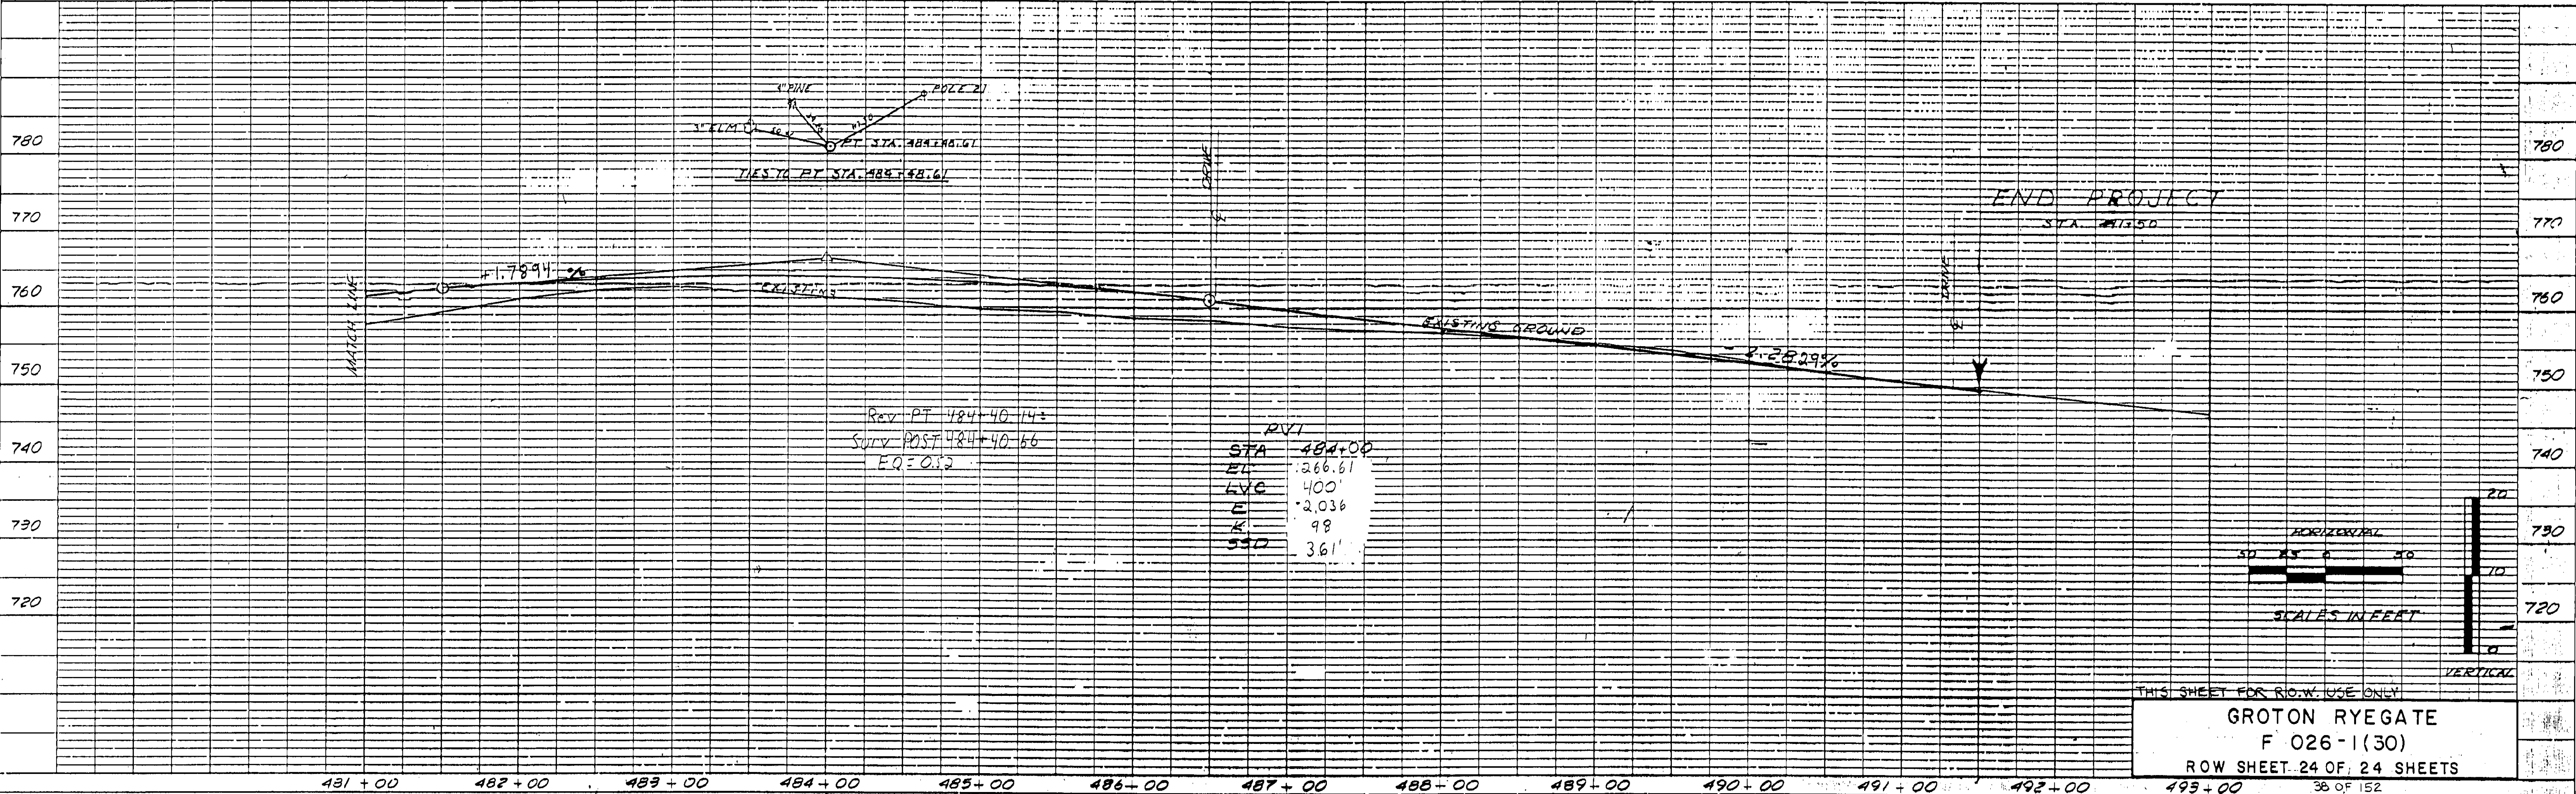


DATE	
BY	
REVISIONS	
NO.	DESCRIPTION
1	
2	
3	
4	
5	
6	
7	
8	
9	
10	

DATE	
BY	
REVISIONS	
NO.	DESCRIPTION
1	
2	
3	
4	
5	
6	
7	
8	
9	
10	

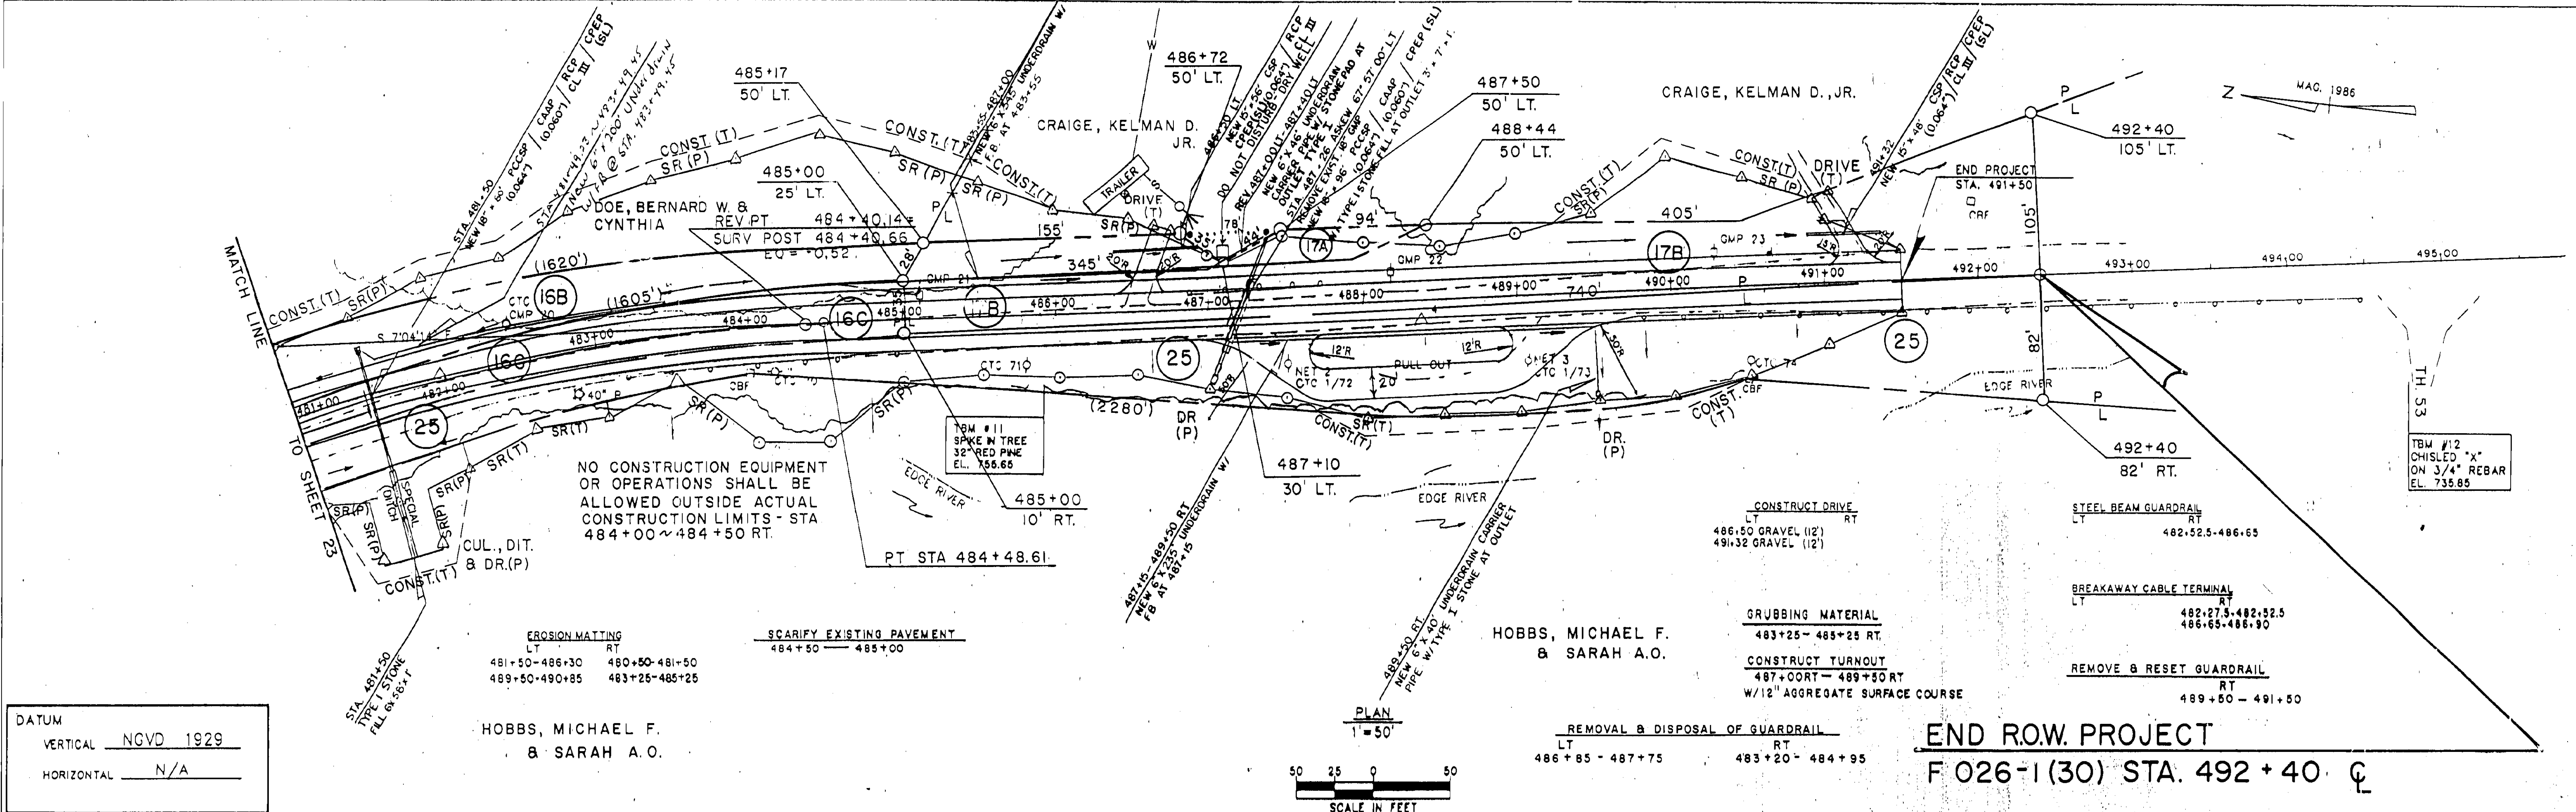

THIS SHEET FOR ROW USE ONLY  
**GROTON RYEGATE**  
**F 026-1(30)**  
 ROW SHEET 24 OF 24 SHEETS  
 38 OF 152