
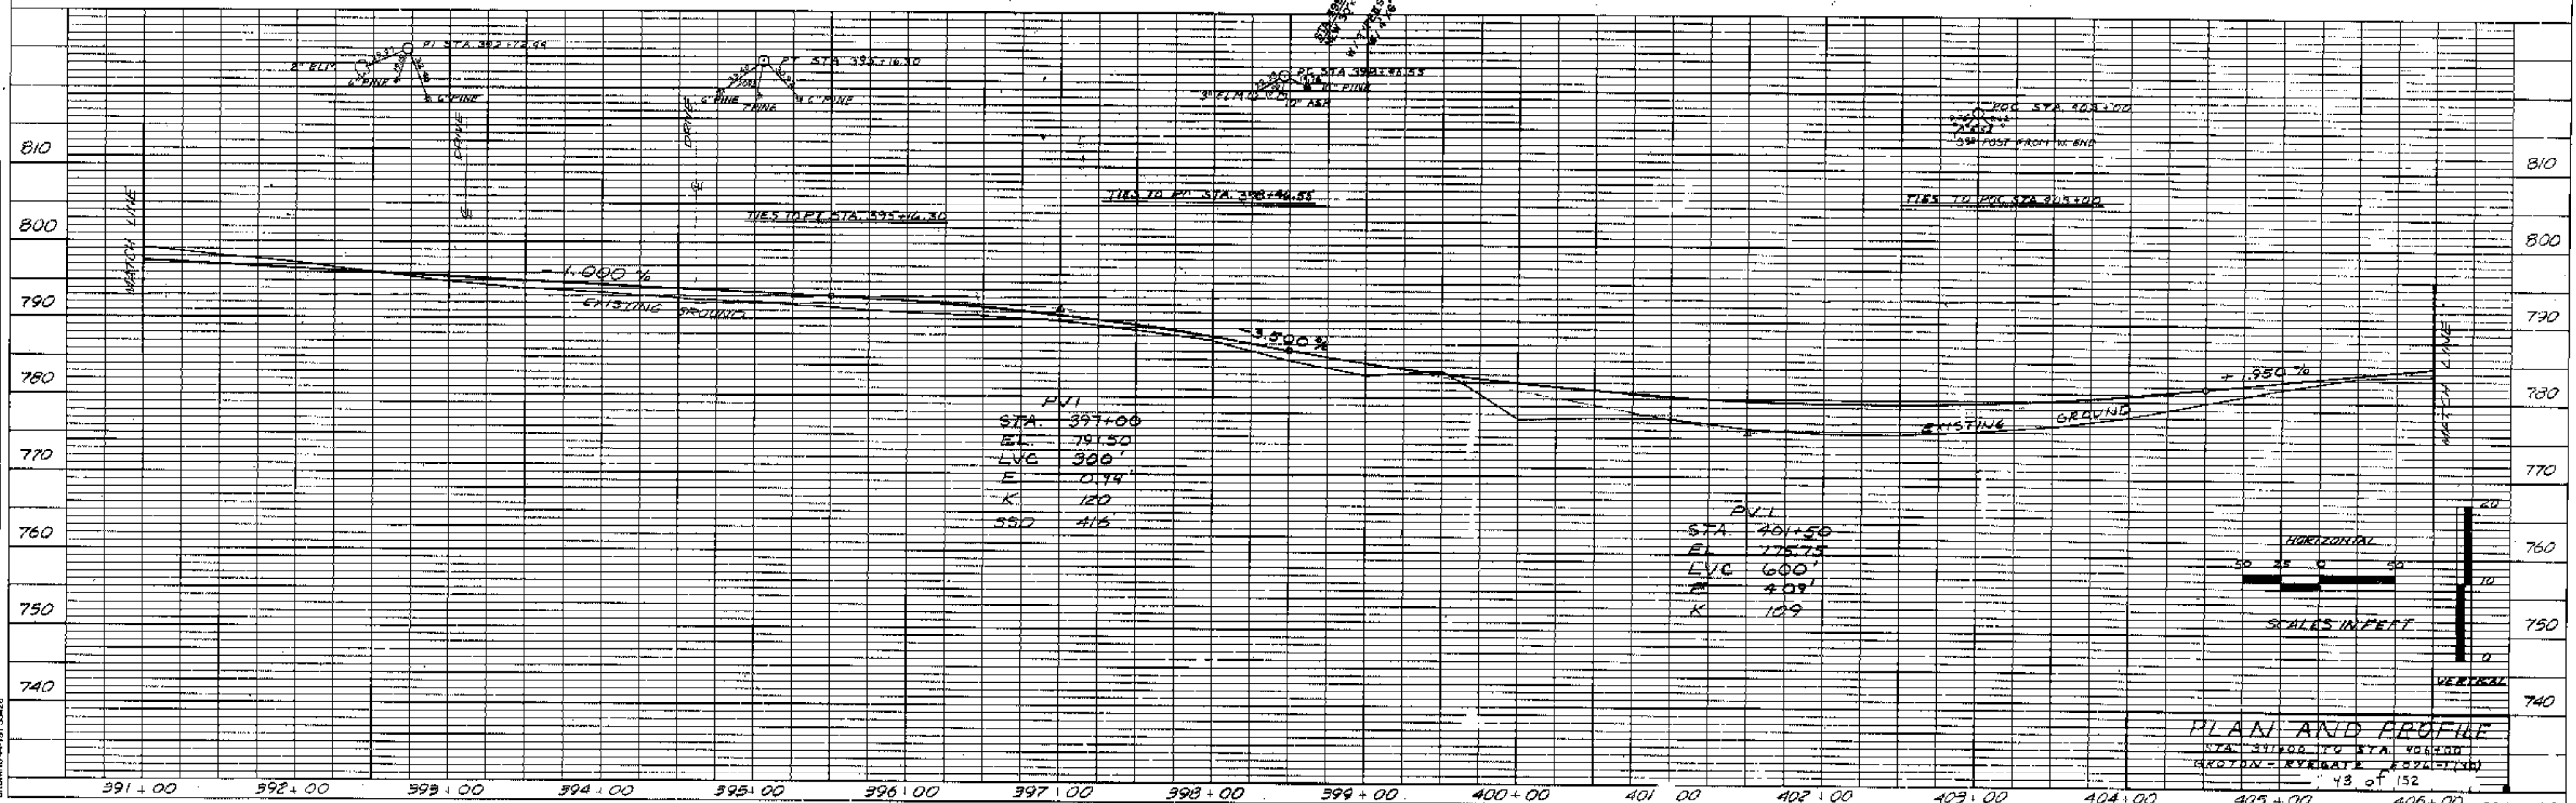


DATE: _____
 BY: _____
 CHECKED: _____
 DATE: _____

PLAN
 CHECKED: _____
 DATE: _____

DATE: _____
 BY: _____
 CHECKED: _____
 DATE: _____

PROFILE
 CHECKED: _____
 DATE: _____

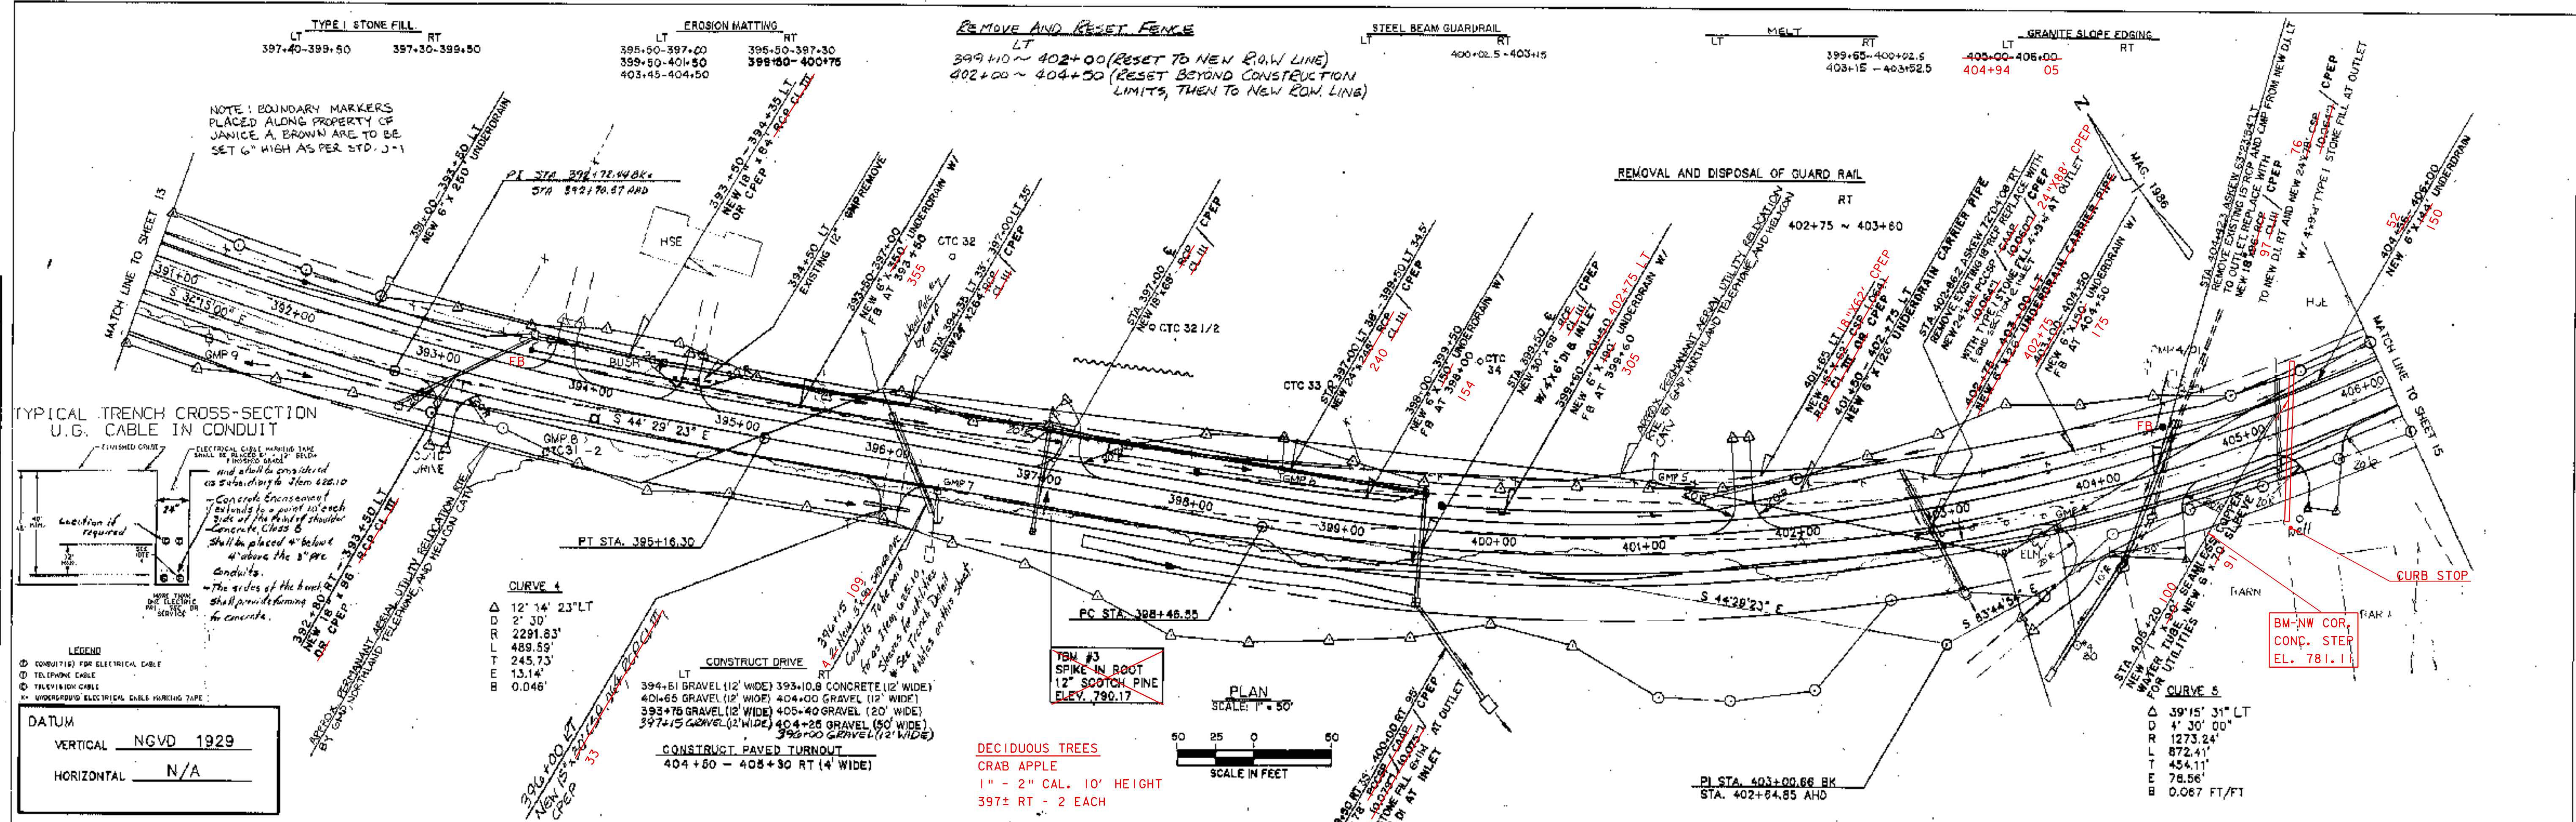

PLAN AND PROFILE
 STA 397+00 TO STA 406+00
 KROTON - KYRIAKIS ENGINEERING
 48 of 152
 REV. 3-31-97