




DATE	BY
DESIGNED	CHIEF ENGINEER
CHECKED	DATE
DATE	NO.
NO.	NO.

DATE	BY
DESIGNED	CHIEF ENGINEER
CHECKED	DATE
DATE	NO.
NO.	NO.

TYPE I STONE FILL	EROSION MATTING	CONSTRUCT DRIVE	CONSTRUCT SIDE ROAD	STEEL BEAM GUARDRAIL
LT 416+25-417+00 RT 415+50-418+00 TH S - 0+30 - 0+40	LT 406+50-409+25 RT 416+75-416+25	LT 406+25 ASPHALT (24) 410+58 GRAVEL (12) 419+60 GRAVEL (12)	LT 417+30+23	LT 418+13.5-418+03.5 RT 417+33.5-418+19
TYPE II STONE FILL				MELT
LT 416+20 RT 416+00				LT 417+76-418+13.5 RT 416+96-417+33.5 418+65-419+01 418+46-419+85.5

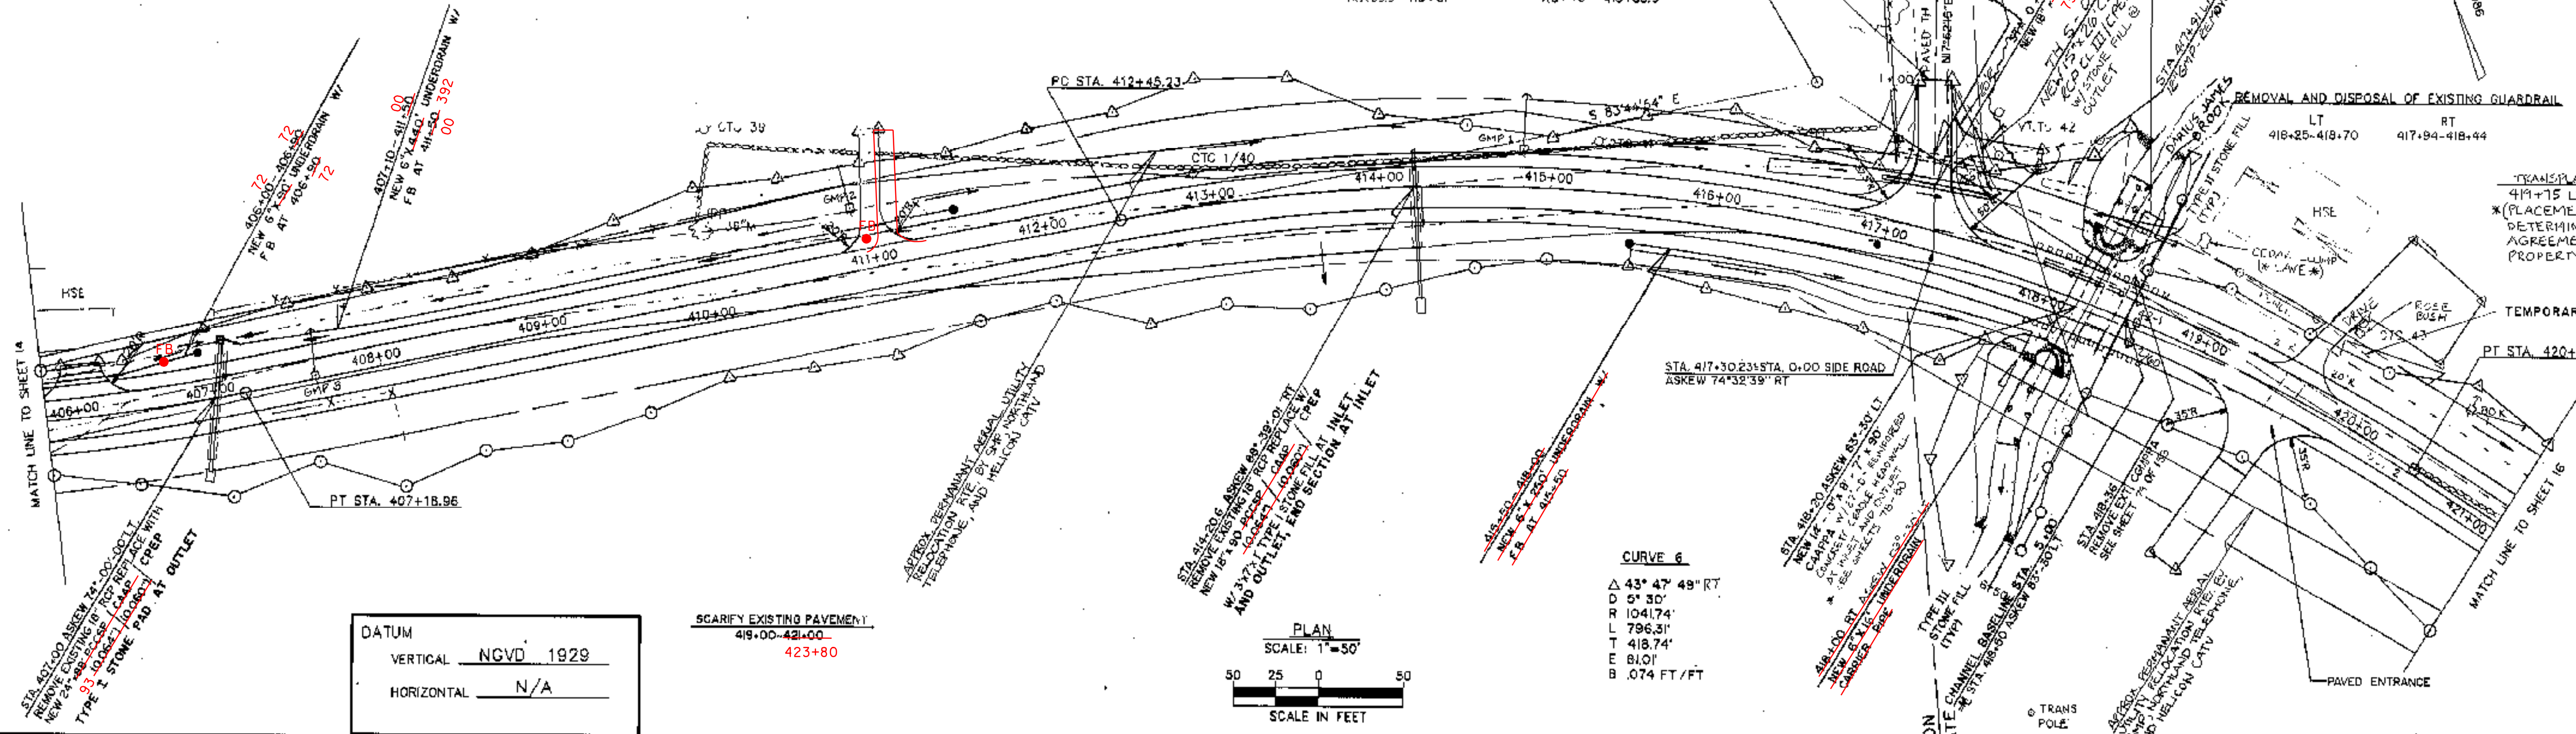

DATUM
VERTICAL NGVD 1929
HORIZONTAL N/A

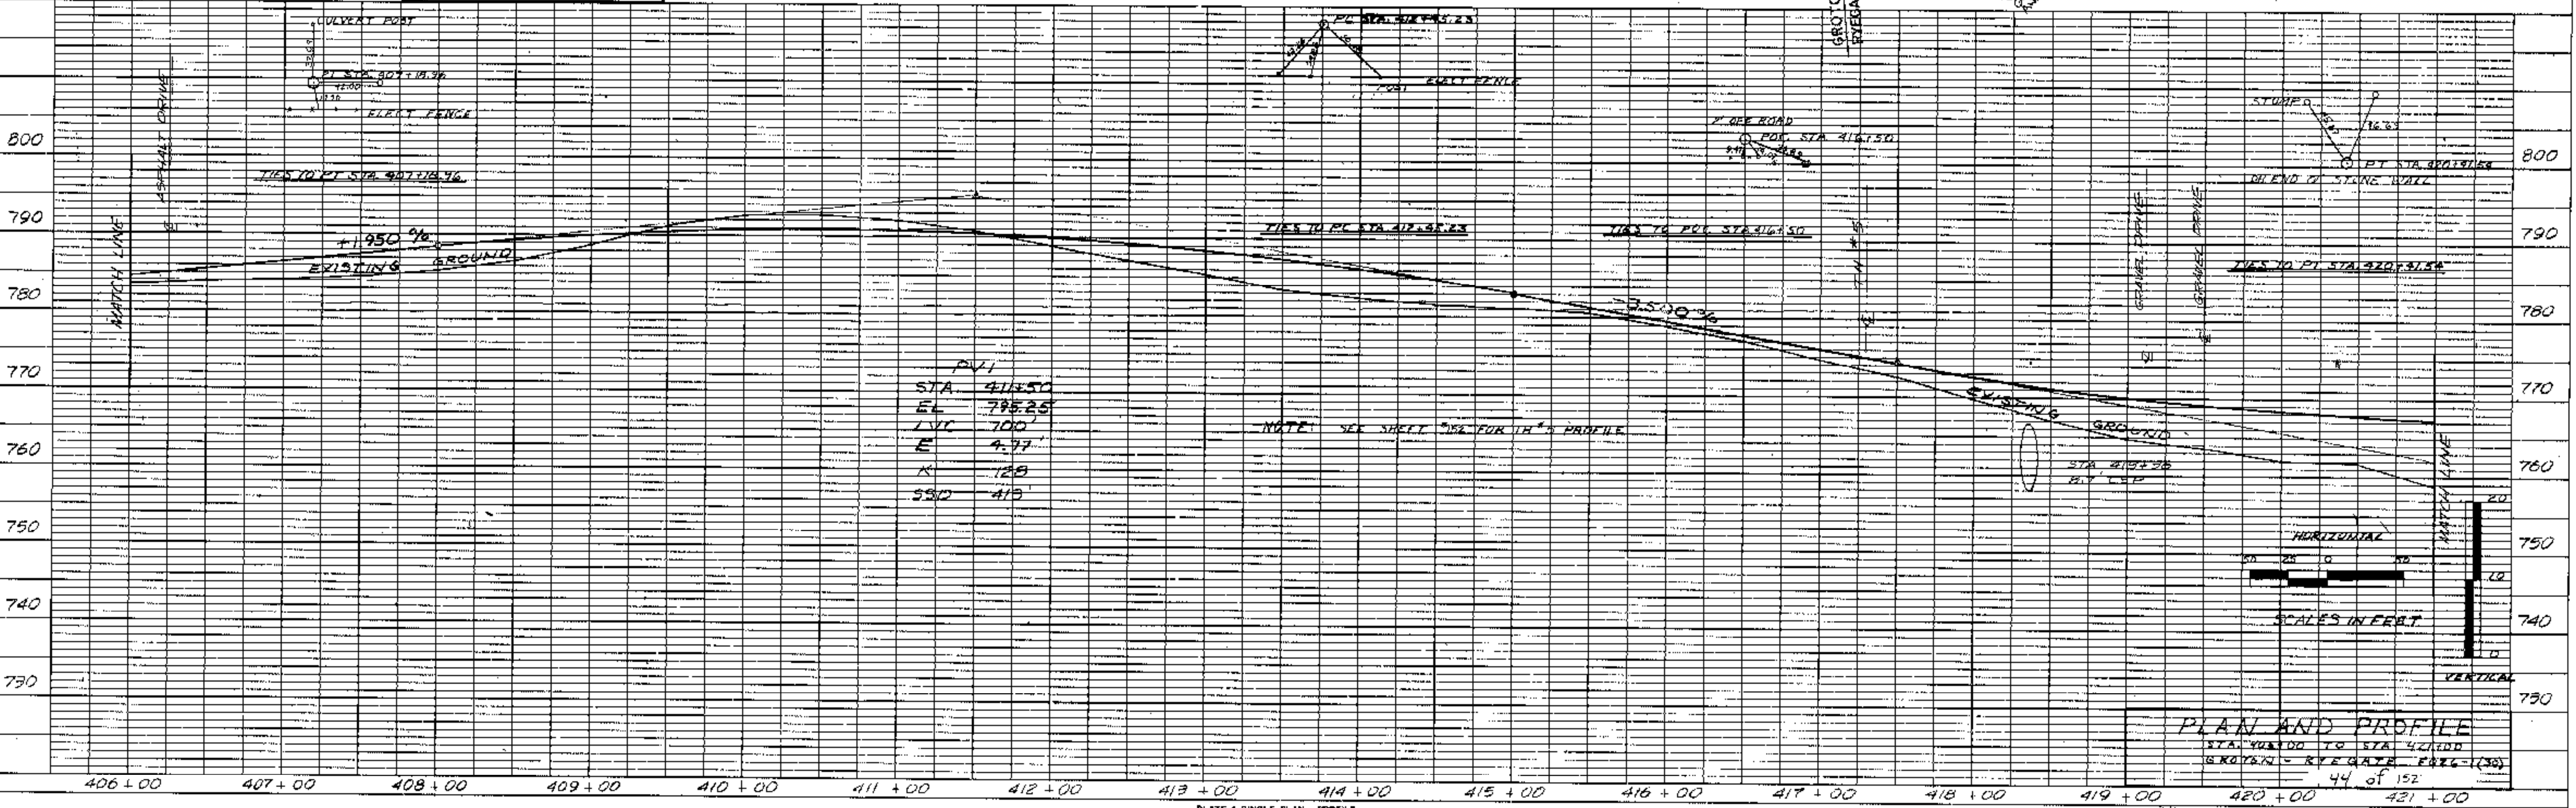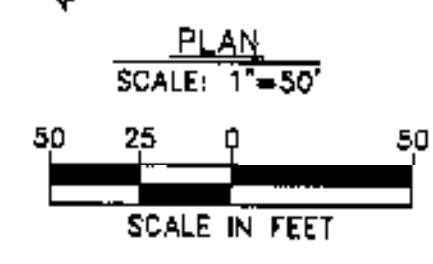

PVI
STA 411+50
EL 795.25
LVC 700'
E 4.77
K 128
SSID 419'

PLAN AND PROFILE
STA 406+00 TO STA 421+00
GRADING - RYGAZE E066-136
44 of 152