


DATUM
 VERTICAL NGVD 1929
 HORIZONTAL N/A

CONSTRUCT DRIVE
 LT 441+98 PAVED (16')
 RT 443+37 GRAVEL (12')
 446+20 GRAVEL (16')


DRILLING AND BLASTING
 SOLID ROCK SUBGRADE
 438+75-439+75
 442+25-448+50
 438+75-440+50

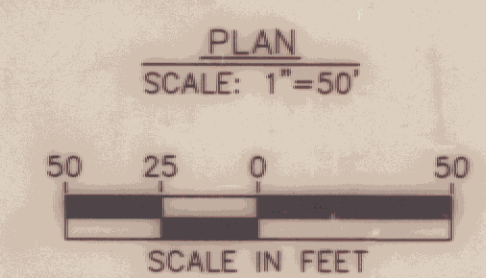


EROSION MATTING
 LT 437+50-442+75
 RT 445+30-448+50

STONE FILL TYPE I
 LT 448+50-451+00 (EXCAV. TO BE PAID AS TRENCH)
 RT 441+25

4' CHAIN LINK FENCE
 LT 443+00-445+00
 (NOTE: ACTUAL LENGTH AND OFFSET TO BE DETERMINED IN FIELD BY THE ENGINEER IN AGREEMENT WITH THE PROPERTY OWNER. FENCE TO BE LOCATED OUTSIDE R.O.W. LINE)

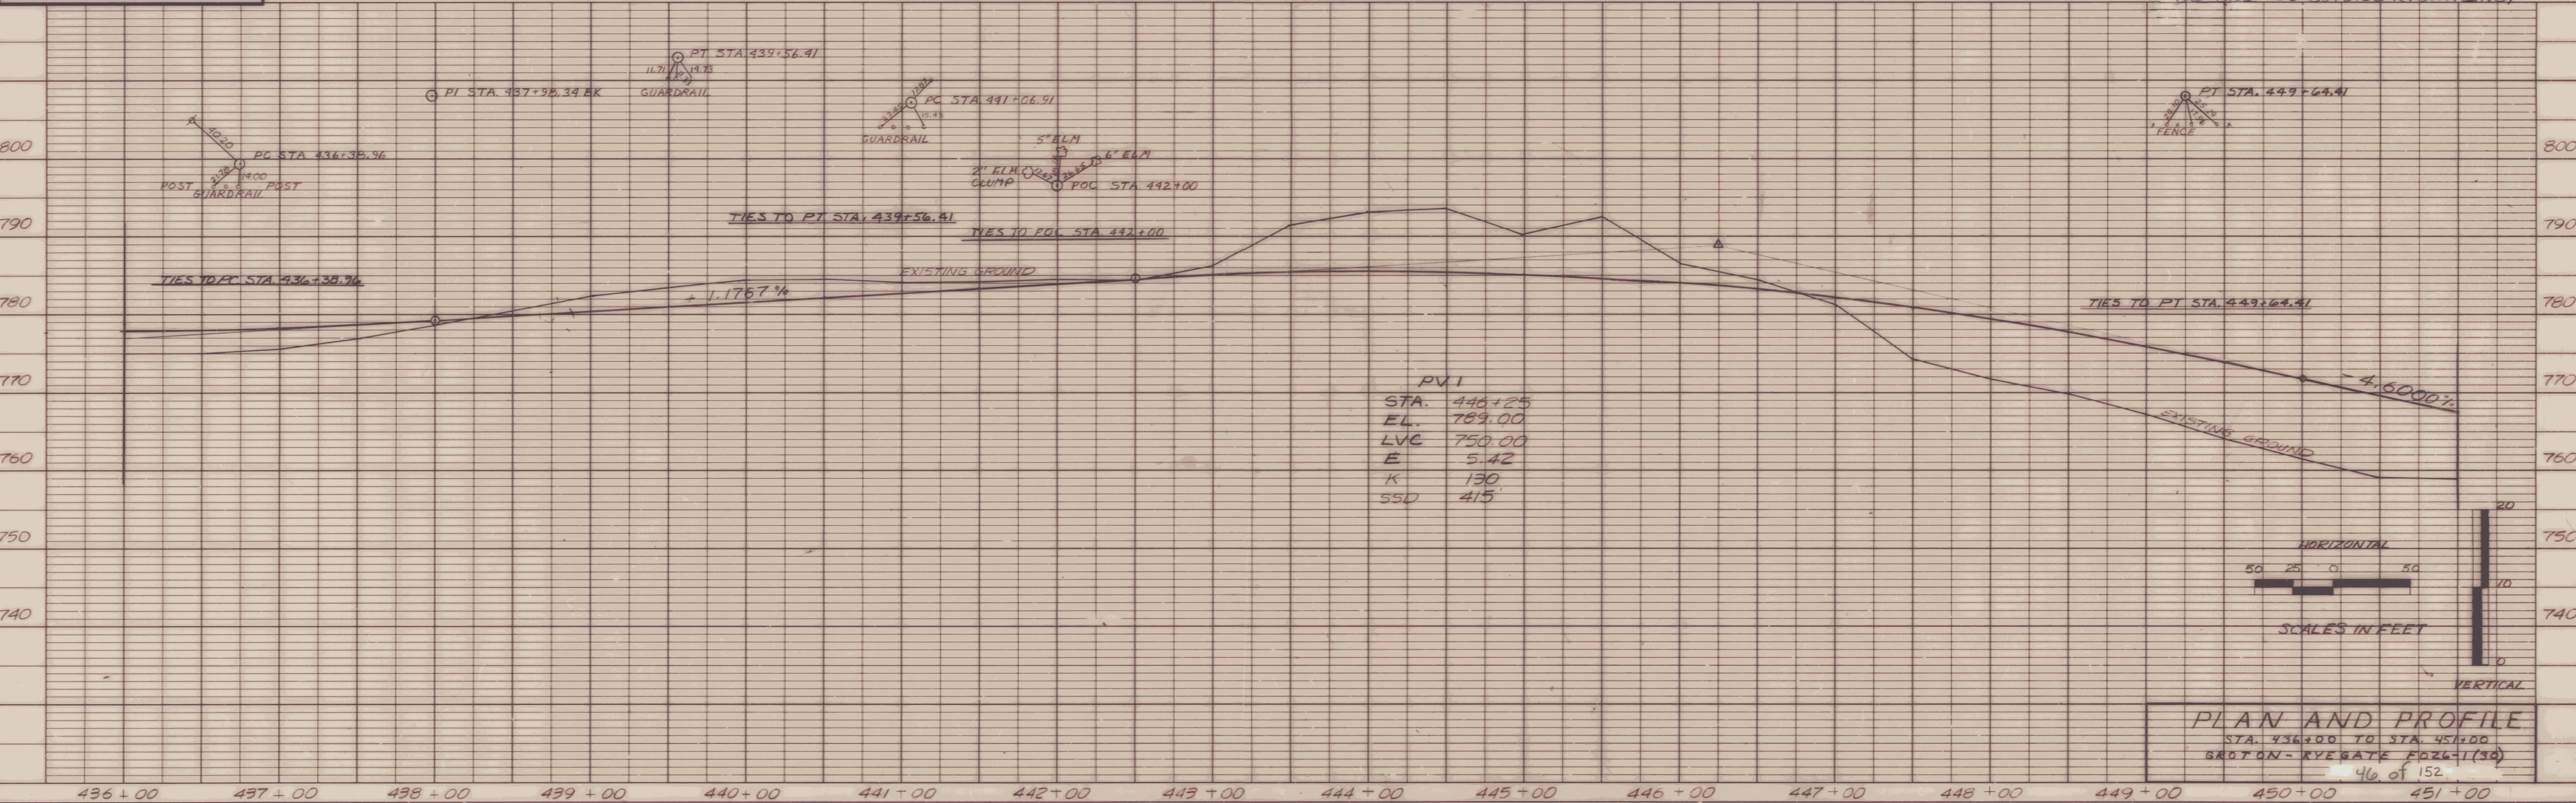

PVI
 STA. 446+25
 EL. 789.00
 LVC 750.00
 E 5.42
 K 130
 SSD 415

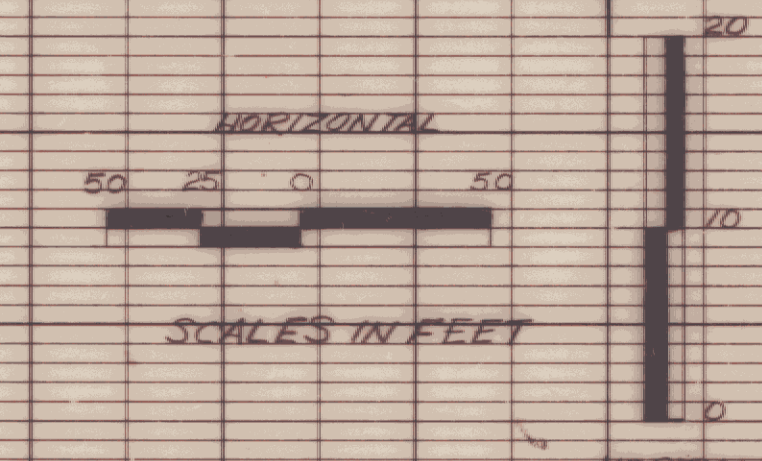

PLAN AND PROFILE
 STA. 436+00 TO STA. 451+00
 BROOKLYN - RYE GATE ROAD-1 (30)