

DATUM
 VERTICAL NGVD 1929
 HORIZONTAL N/A


EROSION MATTING
 LT 452+00-453+50
 455+25-459+25
 462+00-466+00

TYPE I STONE FILL
 LT 451+00-452+00
 (EXCAV. TO BE PAID AS TRENCH)

TYPE II STONE FILL FOR SLOPE PROTECTION
 RT 453+75-458+25

GRUBBING MATERIAL
 RT 453+75-458+25

SCALE IN FEET
 50 25 0 25 50

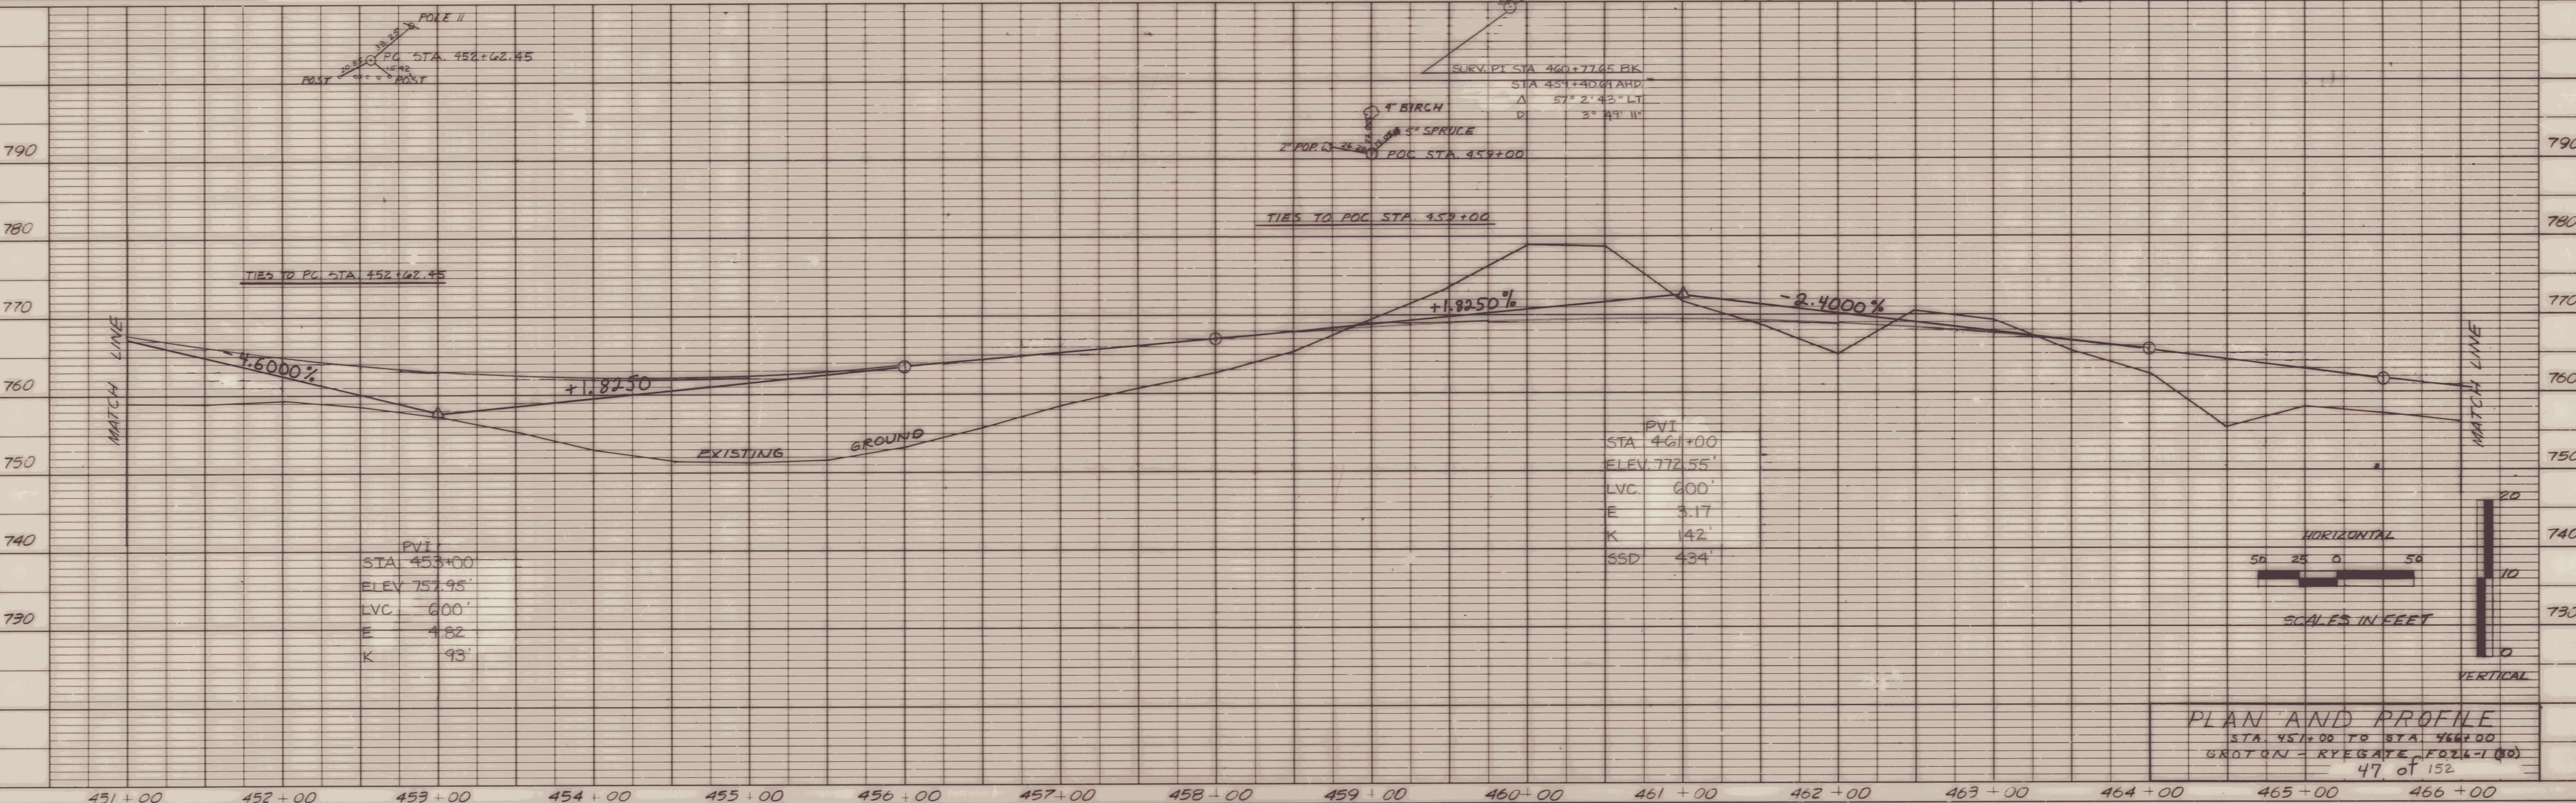

PLAN AND PROFILE
 STA 451+00 TO STA 466+00
 GUYTON - RYEGATE, F026-1 (10)
 47 of 152